


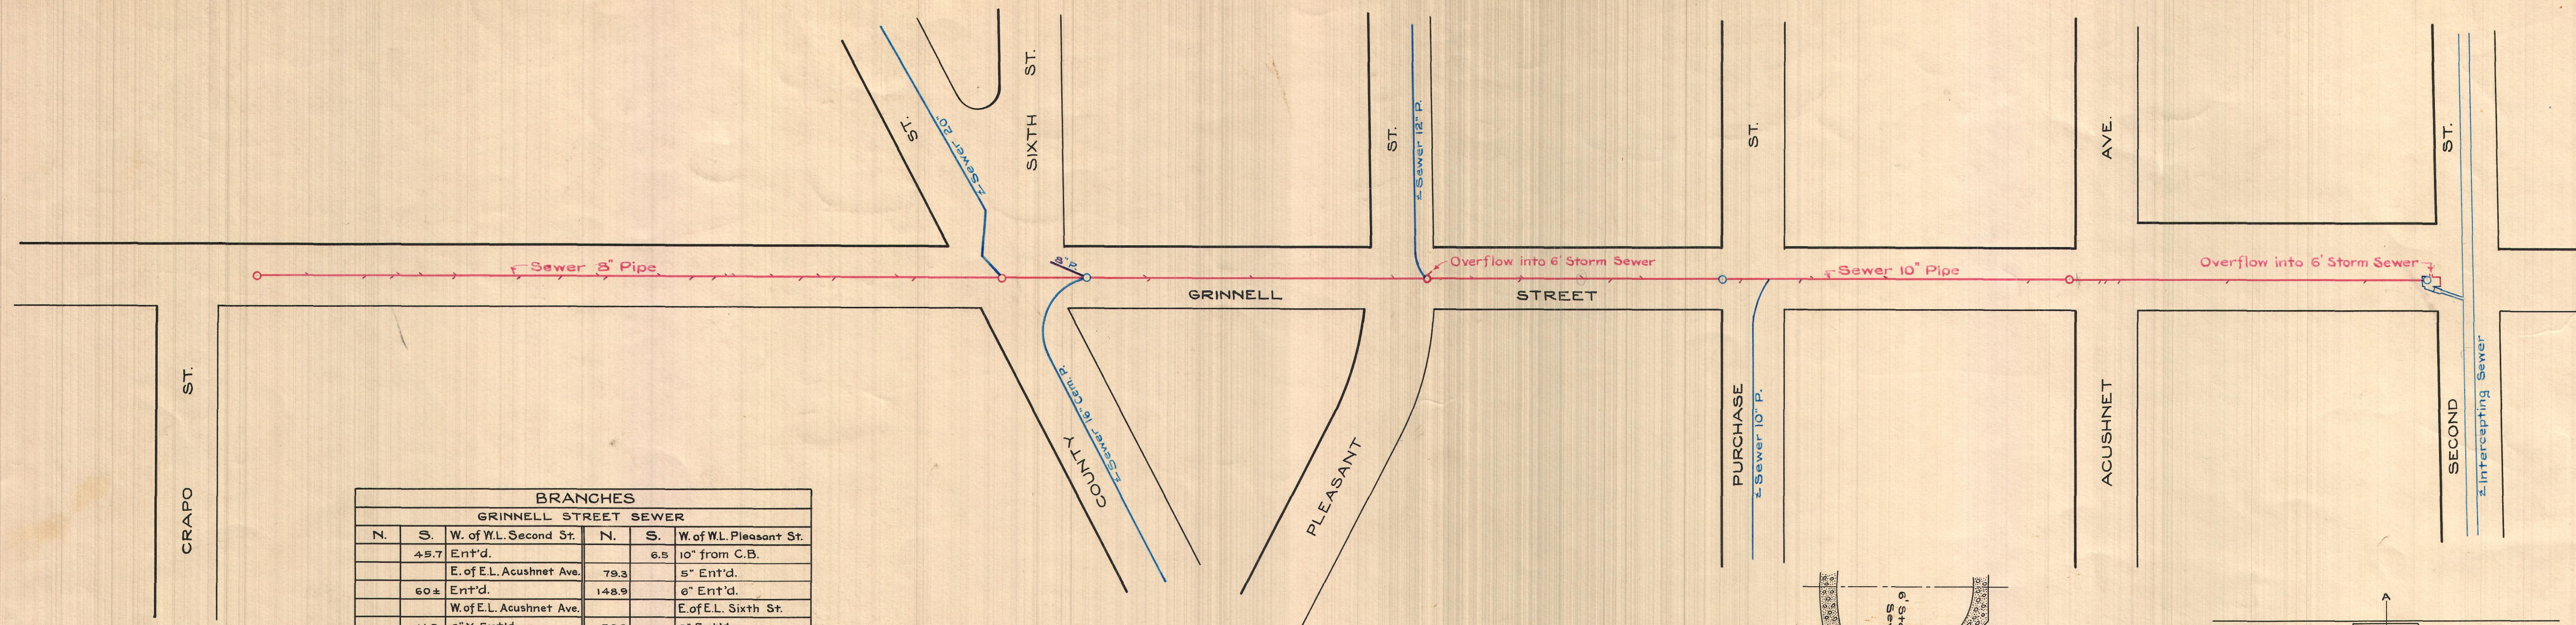

BRANCHES					
GRINNELL STREET SEWER					
N.	S.	W. of W.L. Second St.	N.	S.	W. of W.L. Pleasant St.
45.7	Ent'd.		6.5		10' from C.B.
		E. of E.L. Acushnet Ave.	79.3		5' Ent'd.
60.2	Ent'd.		148.9		6' Ent'd.
		W. of E.L. Acushnet Ave.			E. of E.L. Sixth St.
11.8	6" Y. Ent'd.		56.8		6' Ent'd.
20.5	6" Y. Ent'd.				W. of W.L. County St.
24	6" Y. Ent'd.		33		6' Ent'd.
		W. of W.L. Acushnet Ave.	45		6' Ent'd.
30.2	6" Y. Ent'd.		86.2		6' Ent'd.
126.2	6" Y. Ent'd.		96.7		6' Ent'd.
174.6	6" Y. Ent'd.		107.8		6' Ent'd.
181	4" Y. Ent'd.		127.6		6' Ent'd.
		W. of E.L. Purchase St.	151.5		6' Ent'd.
9.3	10" Y. Ent'd.		157.3		6' Ent'd.
		E. of W.L. Purchase St.	165		Location uncertain
13	6" Y. Ent'd.		180		6' Ent'd.
		W. of W.L. Purchase St.	201.6		6' Ent'd.
25	10' to C.B.		236.3		6' Ent'd.
52.8	6"		241.9		6"
72.6	6"		266.3		6' Ent'd.
92.5	6"		294		6' Ent'd.
131.2	6"		336		6"
			336.4		6' Ent'd.
165	6"		358.5		6"
		W. of E.L. Pleasant St.	373.3		6' Ent'd.
25.8	6" Ent'd.		377.6		6' Ent'd.
			395.9		6' Ent'd.
			433.4		6' Ent'd.

GRINNELL ST. SEWER



SCALE

Horizontal:- 1 inch = 60 feet Vertical:- 1 inch = 6 feet

BUILT UNDER W.P.A.

1940 - 1942

Patrick J. Foley
COMMISSIONER

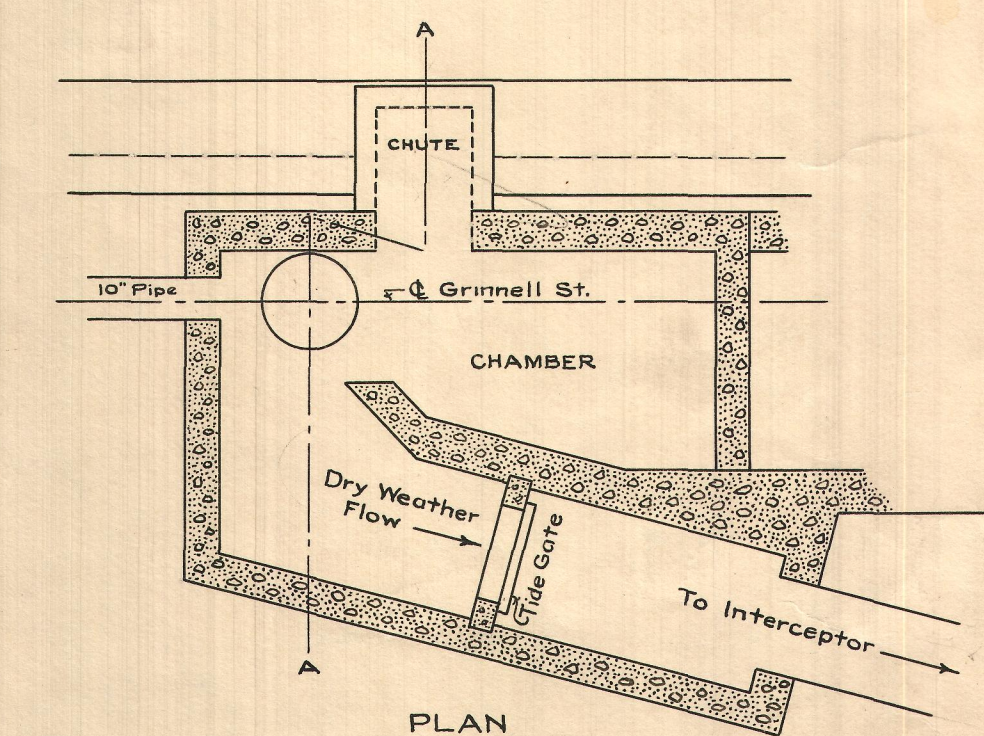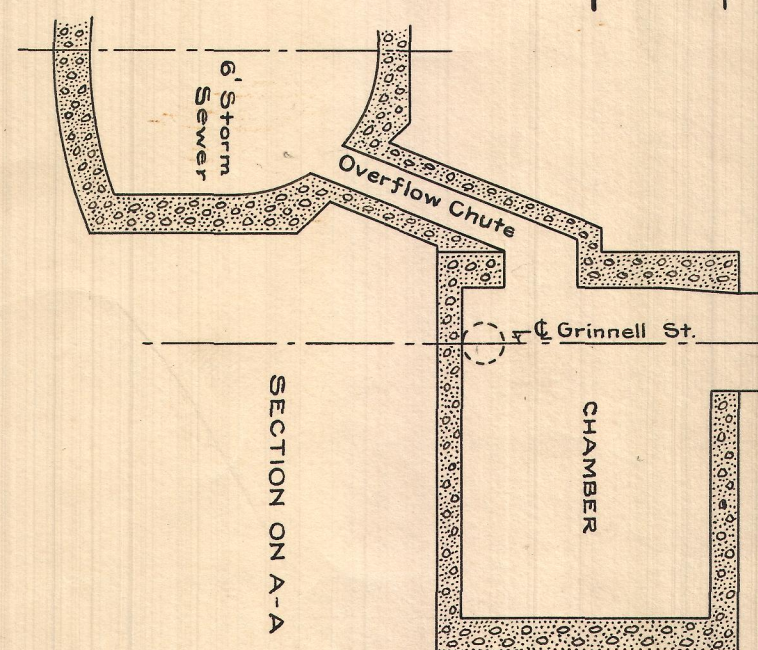

DETAILS OF CHAMBER AT SECOND ST.
SCALE 1" = 4'

