
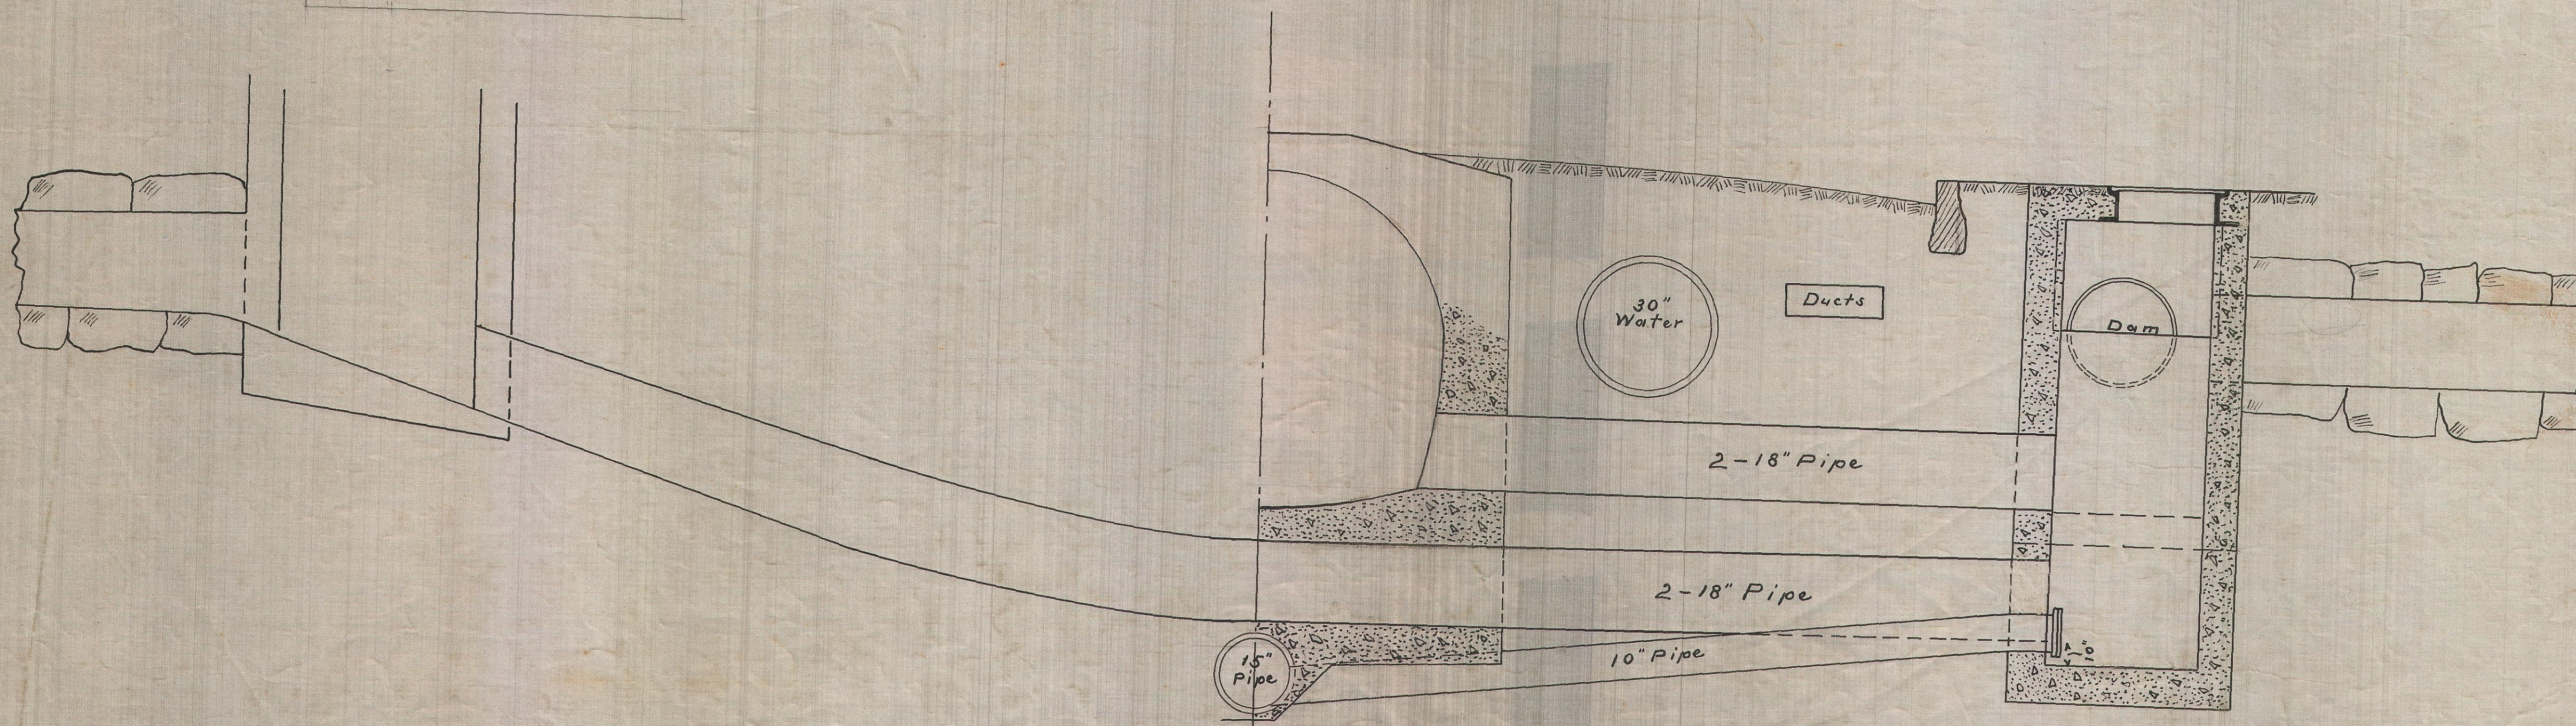


NOTE: See revised general (white paper) drawings of Intercepting Sewer showing special structure for Vera Brook Sewer at Second St. between Grinnell St. and Howland St. as constructed.

City of New Bedford
Intercepting Sewer
VERA BROOK SYPHON
Feb. 3, 1914

NOTE: See Note Book 501-46, 48 showing location of center of manhole openings and details of special structure for Vera Brook Sewer as constructed.

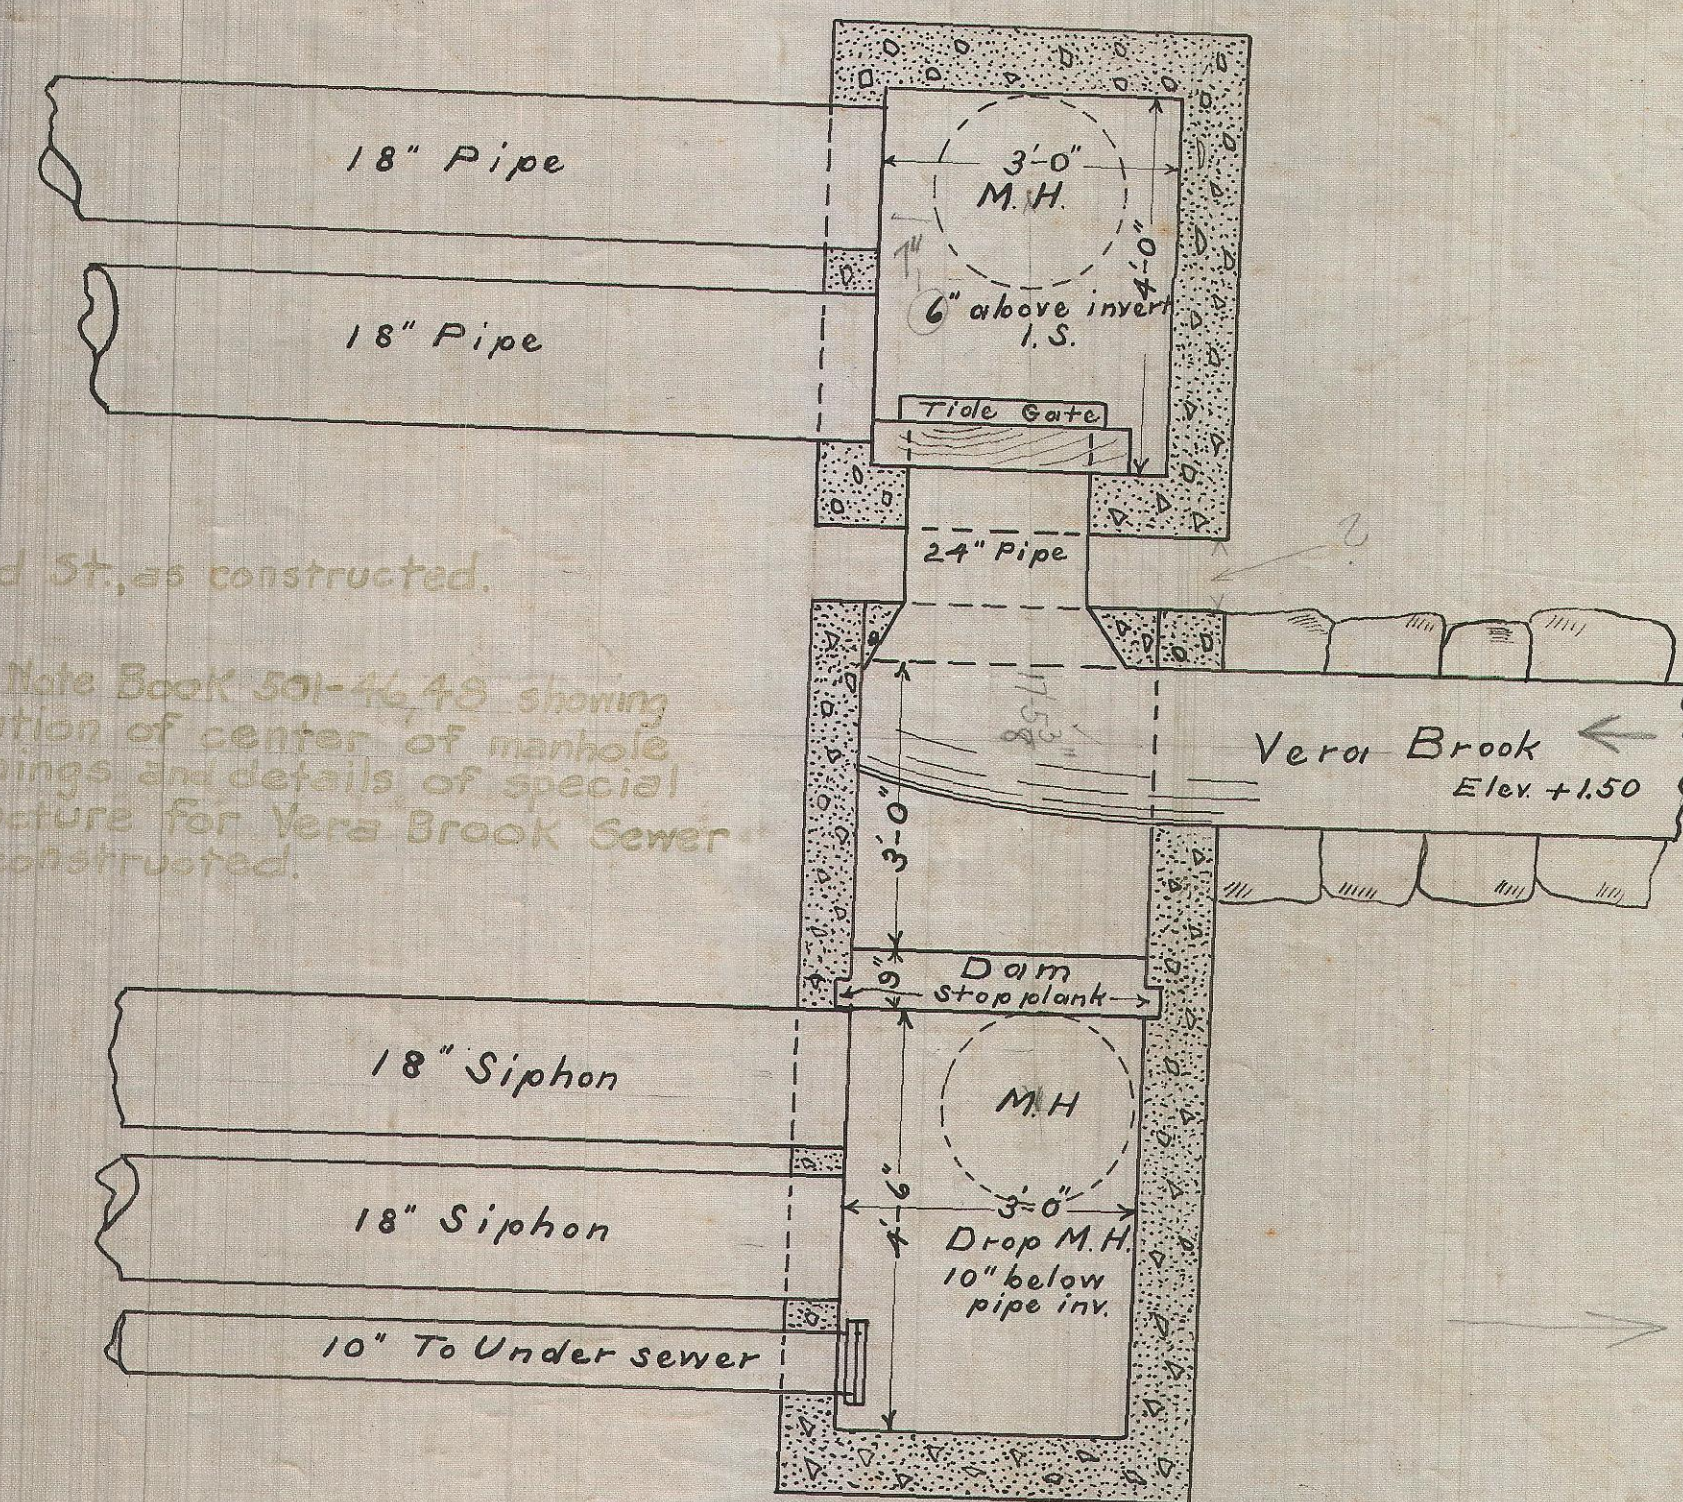

View looking south