


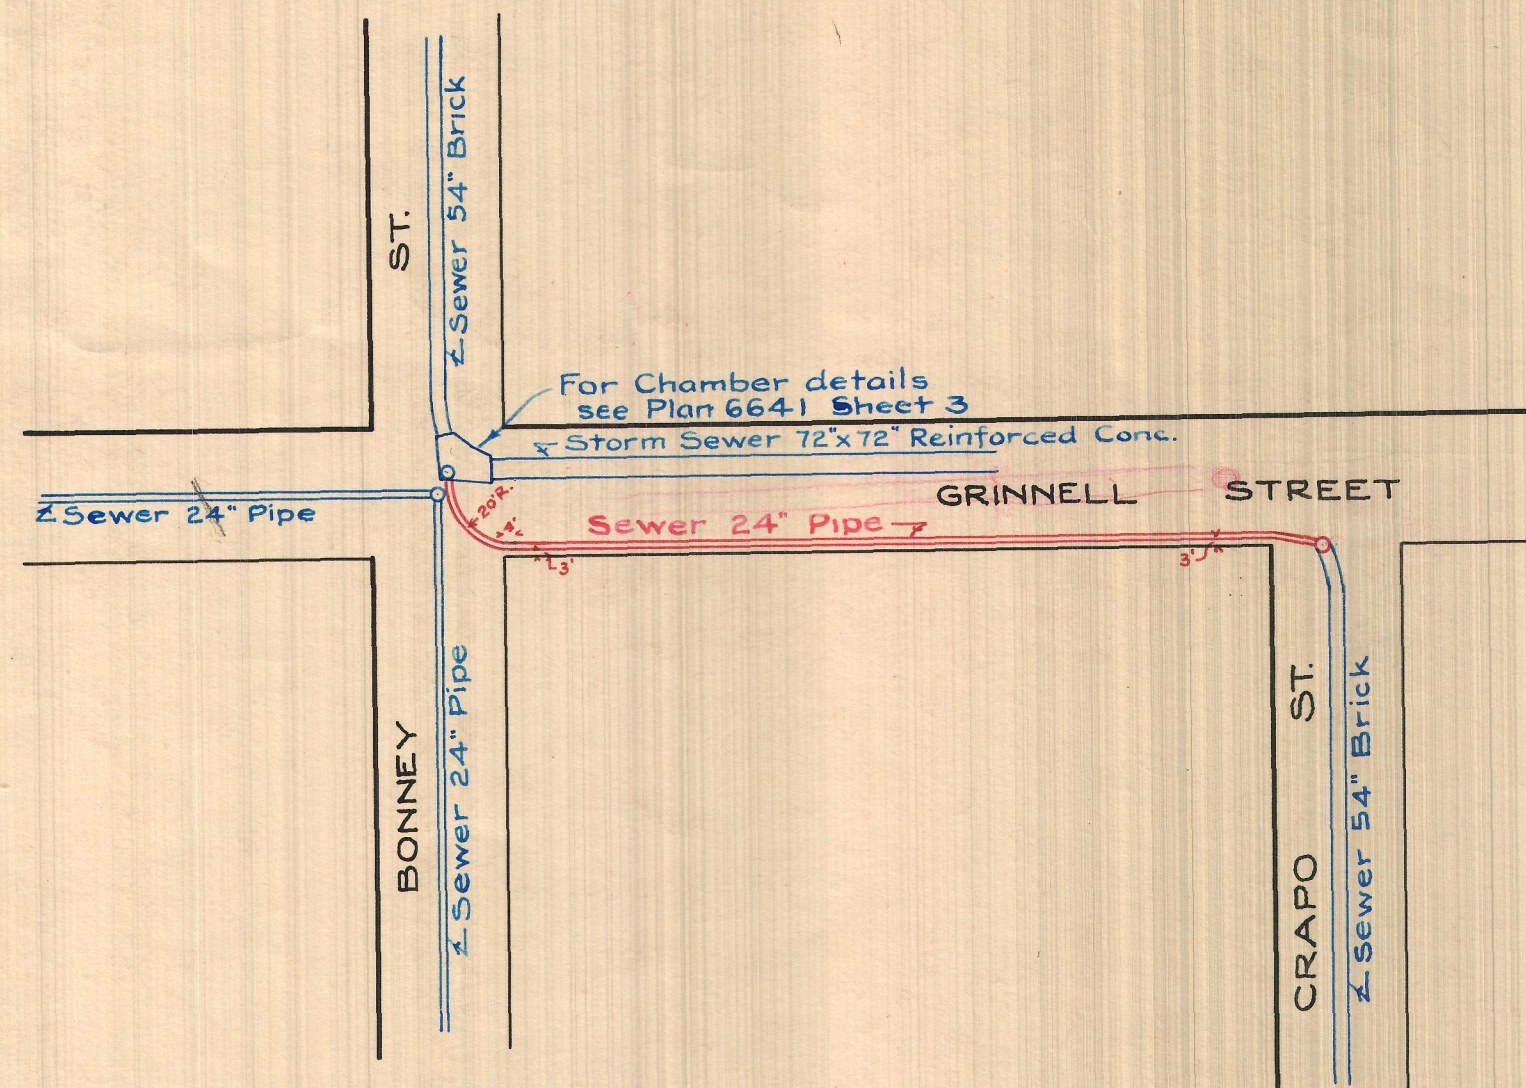

BRANCHES		
GRINNELL ST. SEWER		
N.	S.	W. of W.L. Crapo St.
85.1	6" Cement ent'd.	
115.0	6" V.C. ent'd.	
144.4	6" V.C. ent'd.	
166.4	6" V.C. ent'd.	

GRINNELL ST. SEWER

SCALE

Horizontal:- 1 inch = 60 feet Vertical:- 1 inch = 6 feet

BUILT UNDER W.P.A.

1941 - 1942

Patrick J. Foley
COMMISSIONER

