




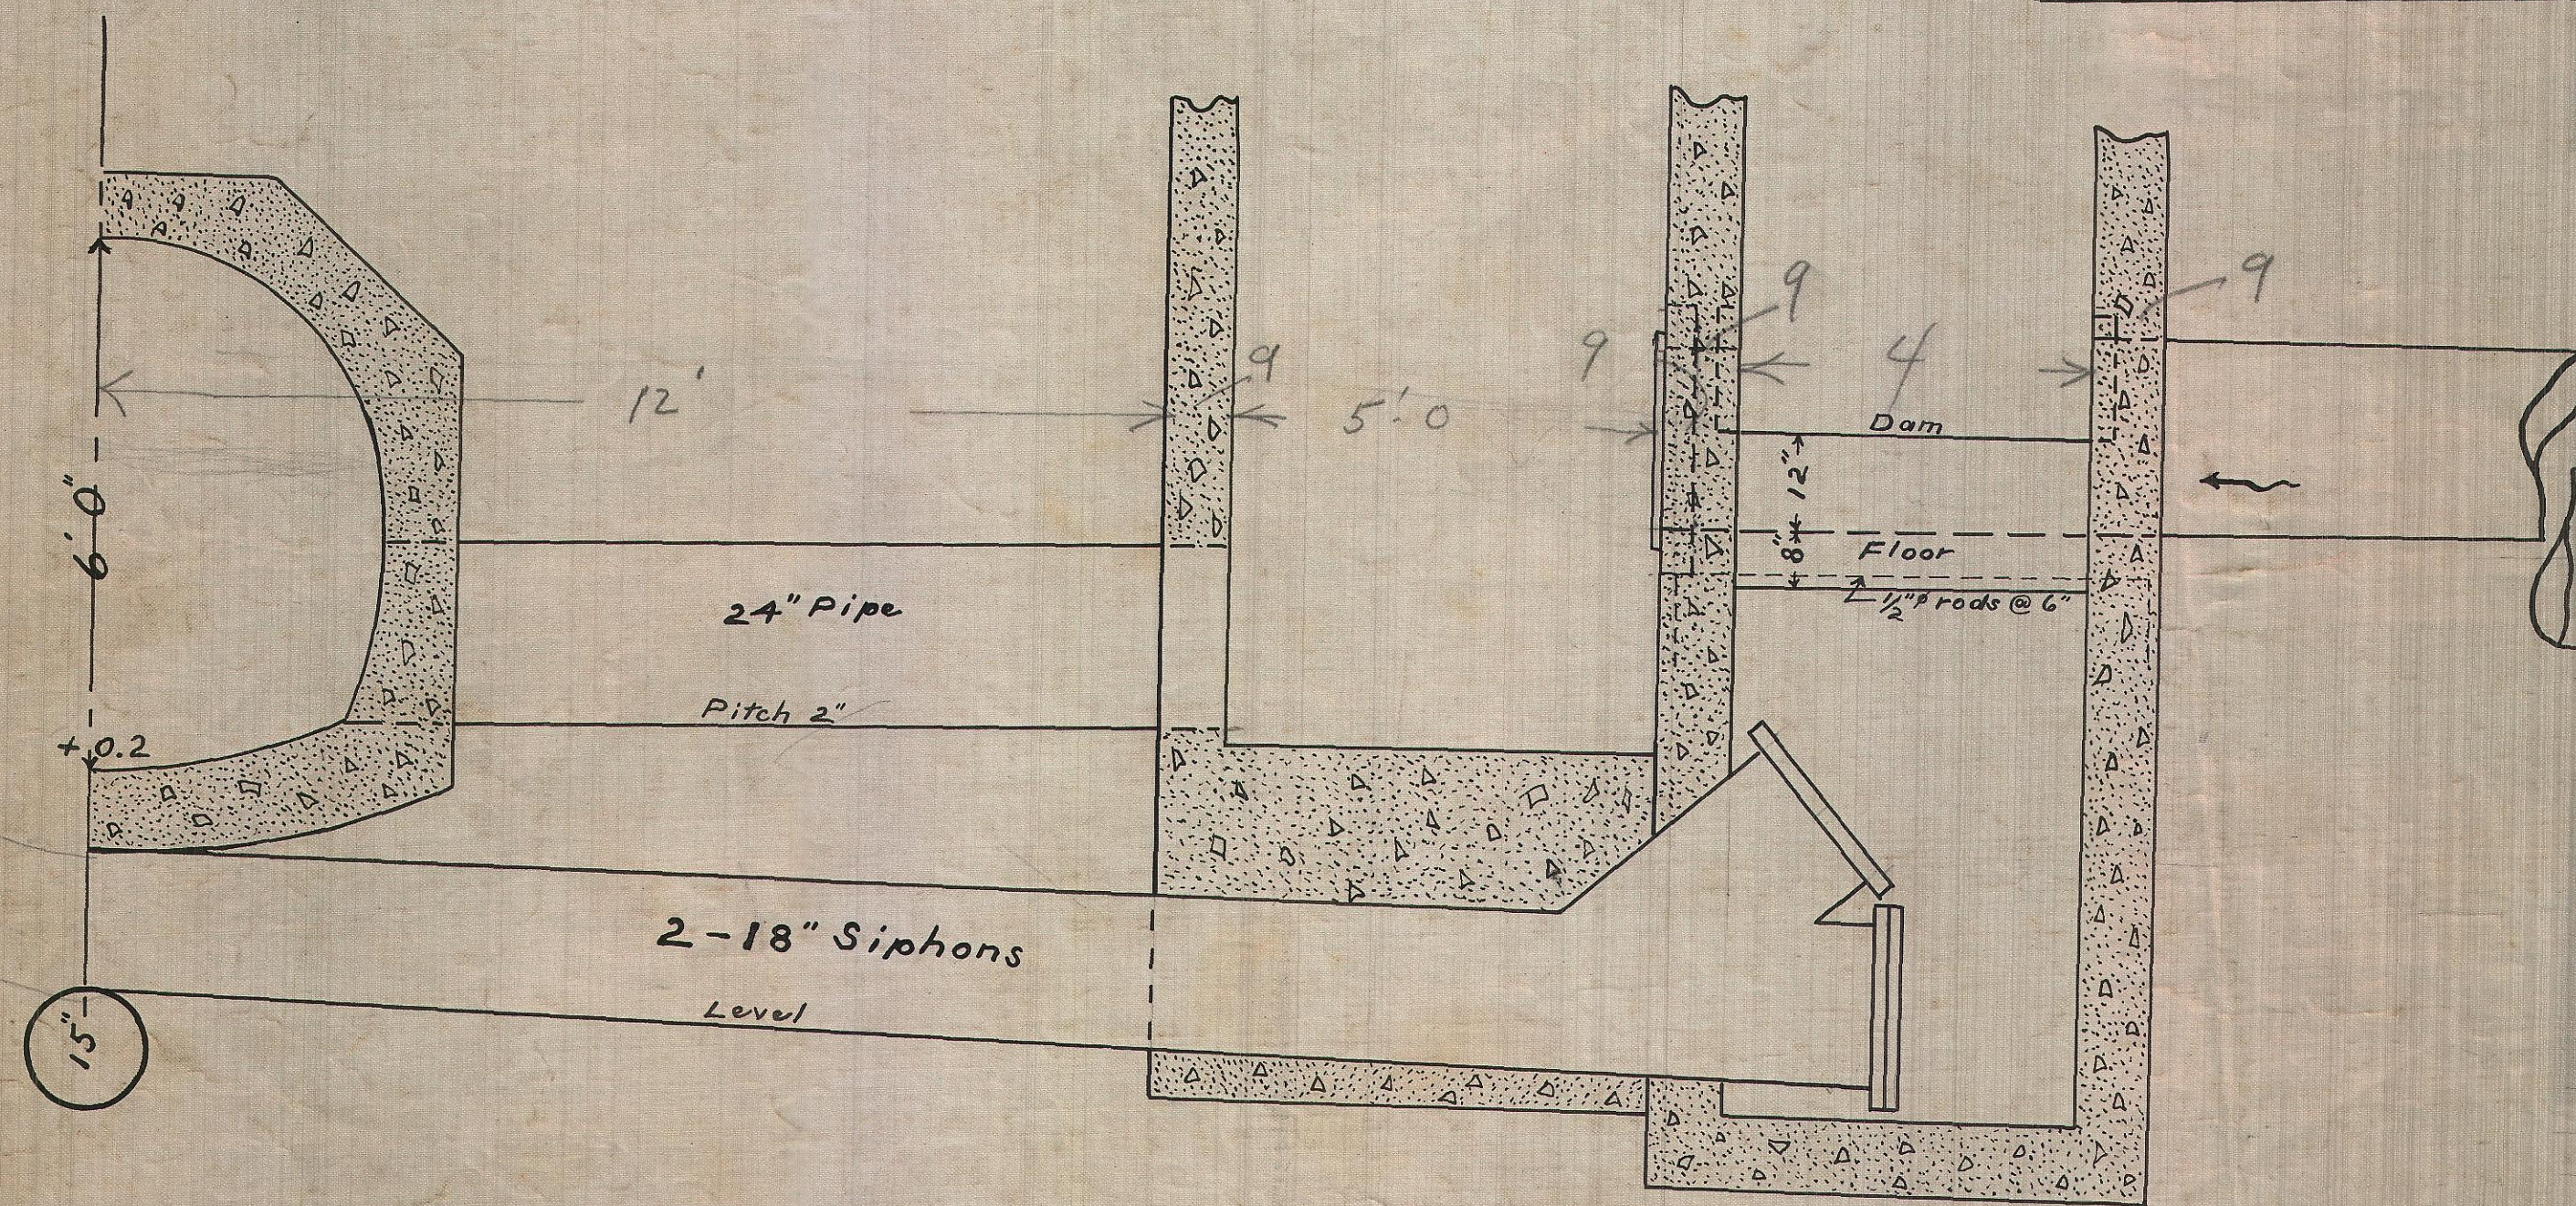

LONG-SECTION

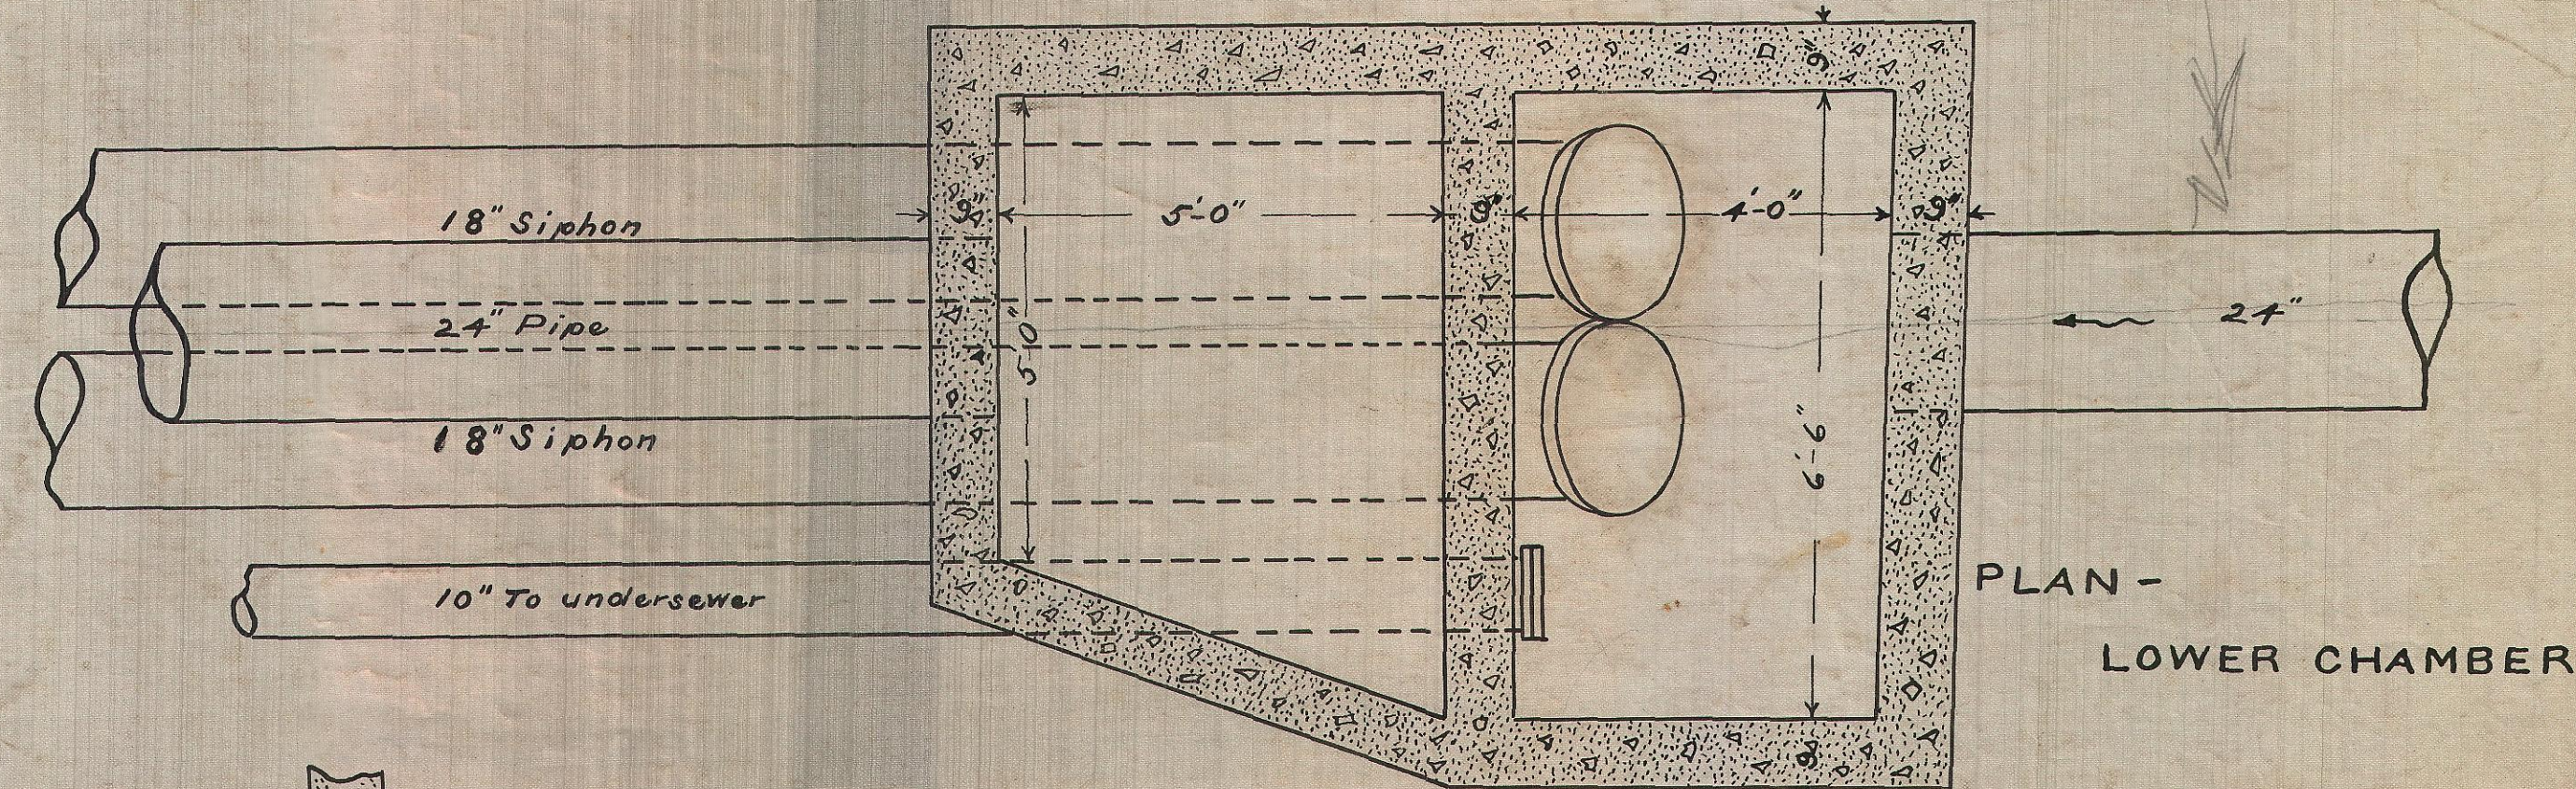

PLAN -
LOWER CHAMBER

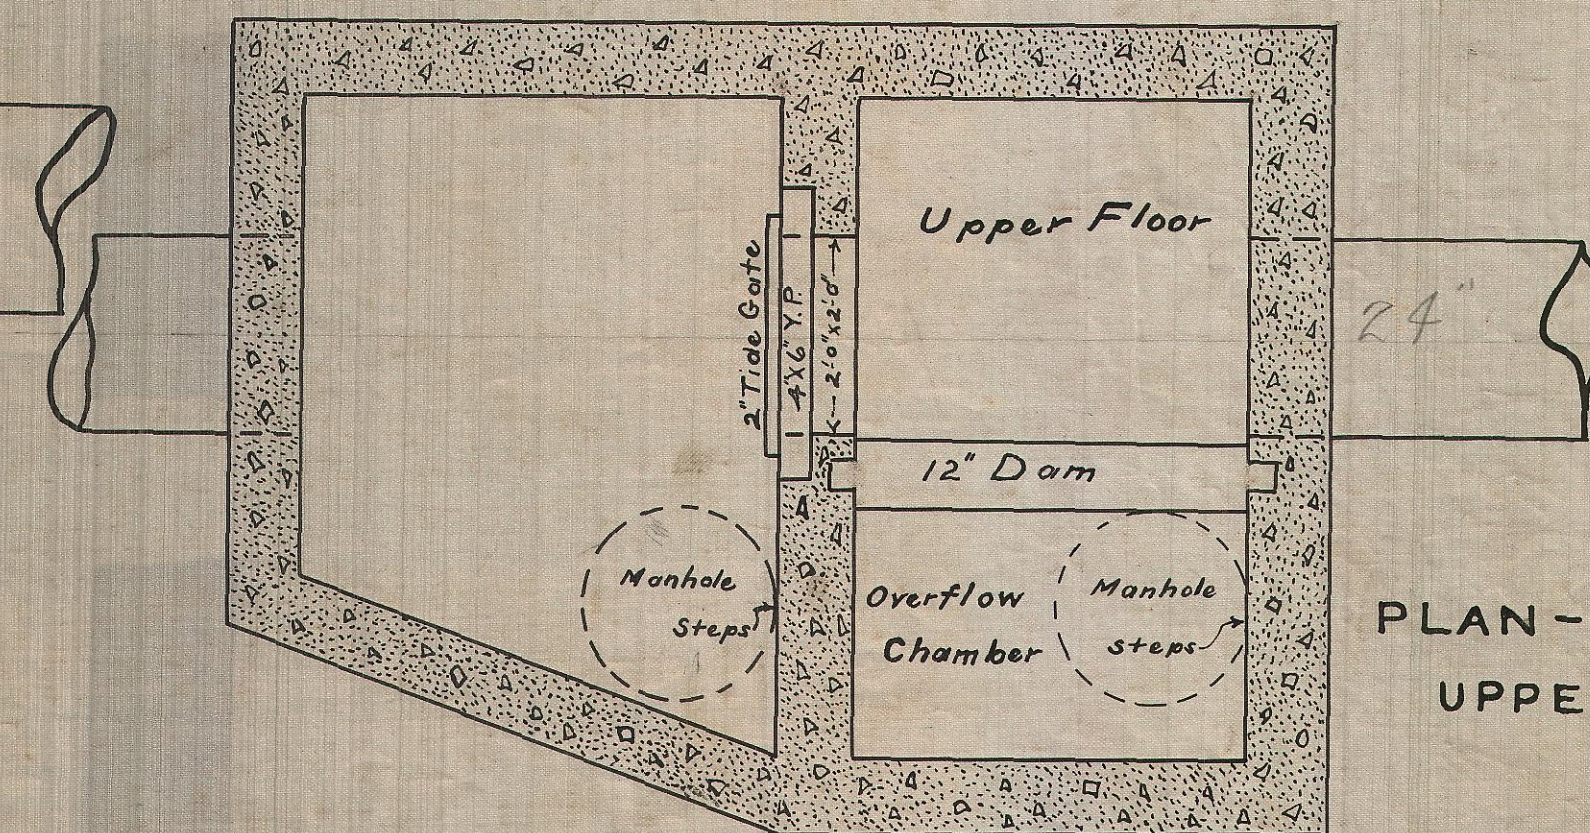

PLAN -
UPPER CHAMBER

NOTE: See revised general (white paper) drawings of intercepting sewer showing special structure in Cannon St. at Second St. as constructed.

CANNON ST SIPHON

March-1914 ~ Scale 1/2"=1'-0