



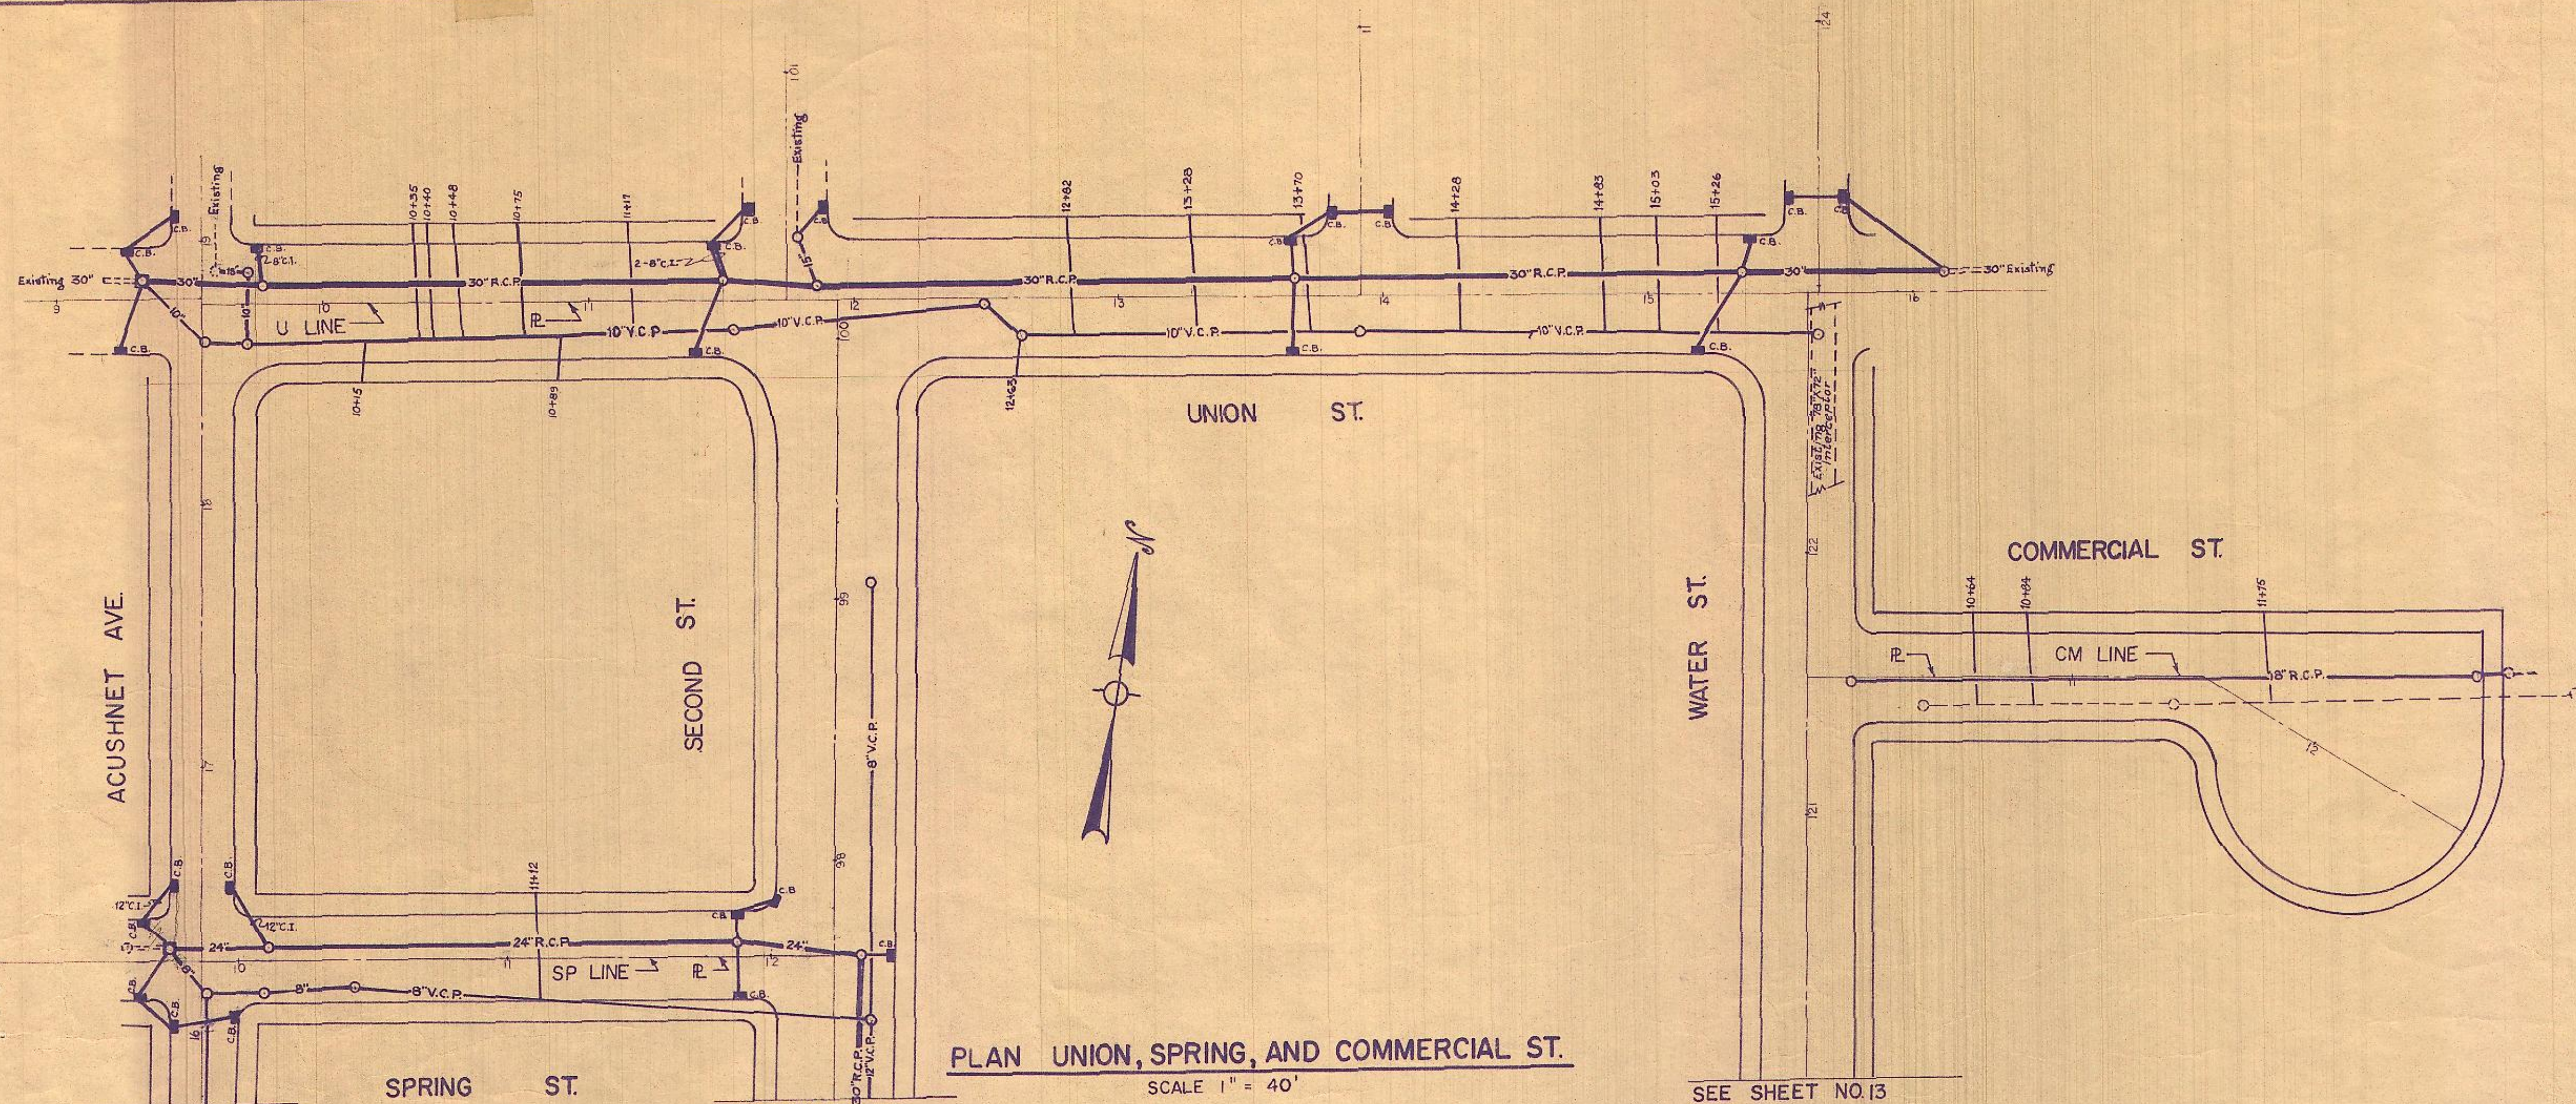

Notes:  
 1. Sanitary sewer connections and stubs 6" V.C.P. unless otherwise noted.  
 2. All connecting pipes to catch basins 15" R.C.P.

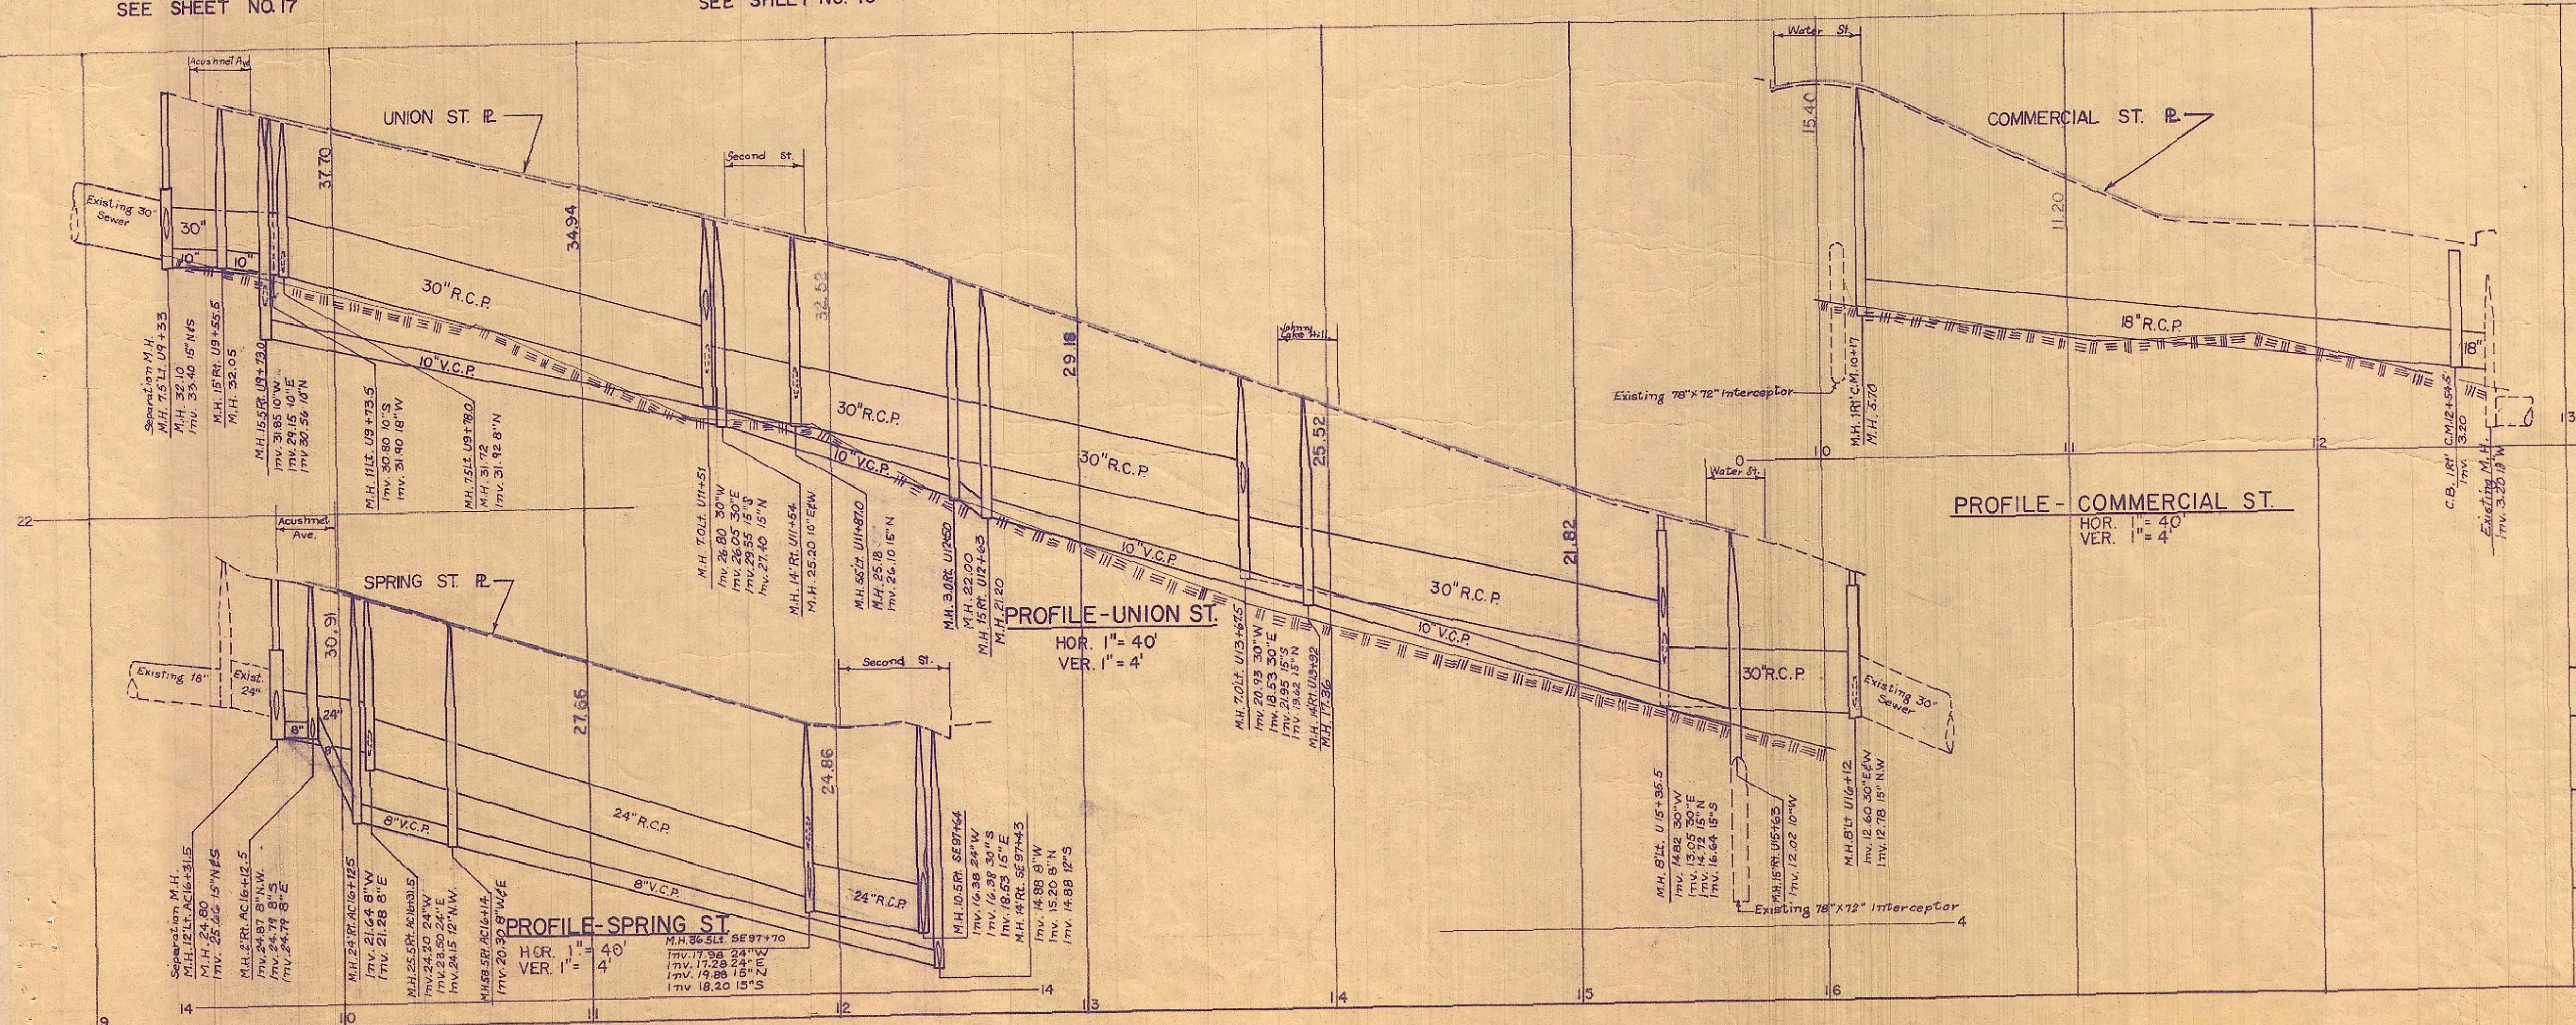

NEW BEDFORD REDEVELOPMENT AUTHORITY

SOUTH TERMINAL URBAN RENEWAL PROJECT

UNION ST.-SPRING ST.  
 COMMERCIAL ST.

AS BUILT DRAWINGS  
 PREPARED BY  
 NEW BEDFORD REDEVELOPMENT AUTHORITY

SHEET  
 NO. 18