

1. COORDINATE WORK BETWEEN JOHNNY CAKE HILL AND PURCHASE STREET, NORTH SIDE OF UNION STREET (CURB TO PROPERTY LINE) WITH THE CITY OF NEW BEDFORD AND NATIONAL PARK SERVICE. WORK NEEDED FOR ACCESS TO BUILDING, INCLUDING REPLACEMENT OF LEAD SERVICE, AND/OR EXTENSION OF FIRE SERVICES SHOULD BE COORDINATED WITH THE BUILDING OWNER AND THE CITY OF NEW BEDFORD WITH THE NATIONAL PARK SERVICE.

2. CATCH BASIN INVERTS AT MAIN LINE AND AT EXISTING BASINS AS WELL AS PIPE SLOPES ARE PROVIDED FOR BIDDING PURPOSES ONLY. EXACT SLOPES AND INVERTS TO BE FIELD VERIFIED BASED ON EXISTING UTILITIES.

3. PRIOR TO THE START OF CONSTRUCTION, VERIFY THE LOCATION AND ELEVATION OF EXISTING SEWER SERVICES.



4. COORDINATE WORK IN UNION STREET WITH EXTENET UTILITY.

5. RESTRAIN ALL JOINTS ON 24" DI DRAIN.

RECORD DRAWINGS

Note: See Water & Sewer Service Connection Forms for details of connections installed

- NOTES:
- COORDINATE WORK BETWEEN JOHNNY CAKE HILL AND PURCHASE STREET, NORTH SIDE OF UNION STREET (CURB TO PROPERTY LINE) WITH THE CITY OF NEW BEDFORD AND NATIONAL PARK SERVICE. WORK NEEDED FOR ACCESS TO BUILDING, INCLUDING REPLACEMENT OF LEAD SERVICE, AND/OR EXTENSION OF FIRE SERVICES SHOULD BE COORDINATED WITH THE BUILDING OWNER AND THE CITY OF NEW BEDFORD WITH THE NATIONAL PARK SERVICE.
 - CATCH BASIN INVERTS AT MAIN LINE AND AT EXISTING BASINS AS WELL AS PIPE SLOPES ARE PROVIDED FOR BIDDING PURPOSES ONLY. EXACT SLOPES AND INVERTS TO BE FIELD VERIFIED BASED ON EXISTING UTILITIES.
 - PRIOR TO THE START OF CONSTRUCTION, VERIFY THE LOCATION AND ELEVATION OF EXISTING SEWER SERVICES.
 - COORDINATE WORK IN UNION STREET WITH EXTENET UTILITY.
 - RESTRAIN ALL JOINTS ON 24" DI DRAIN.

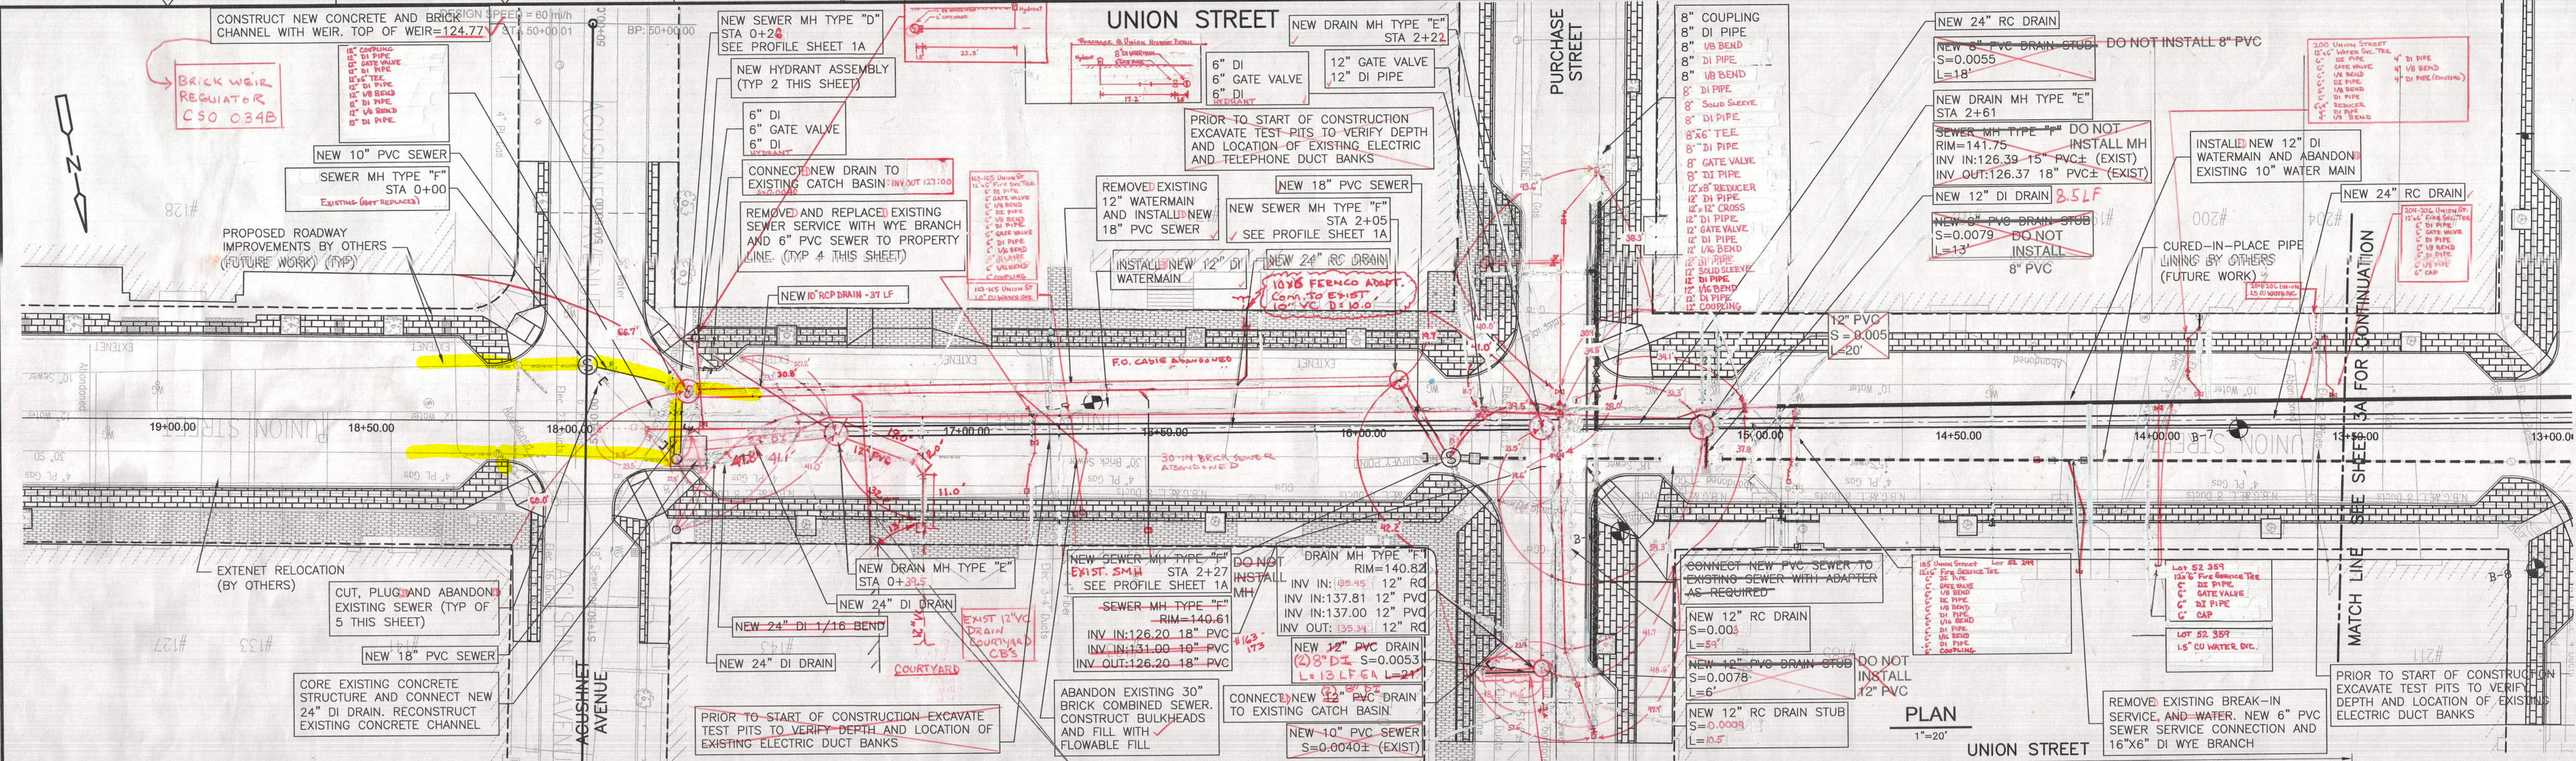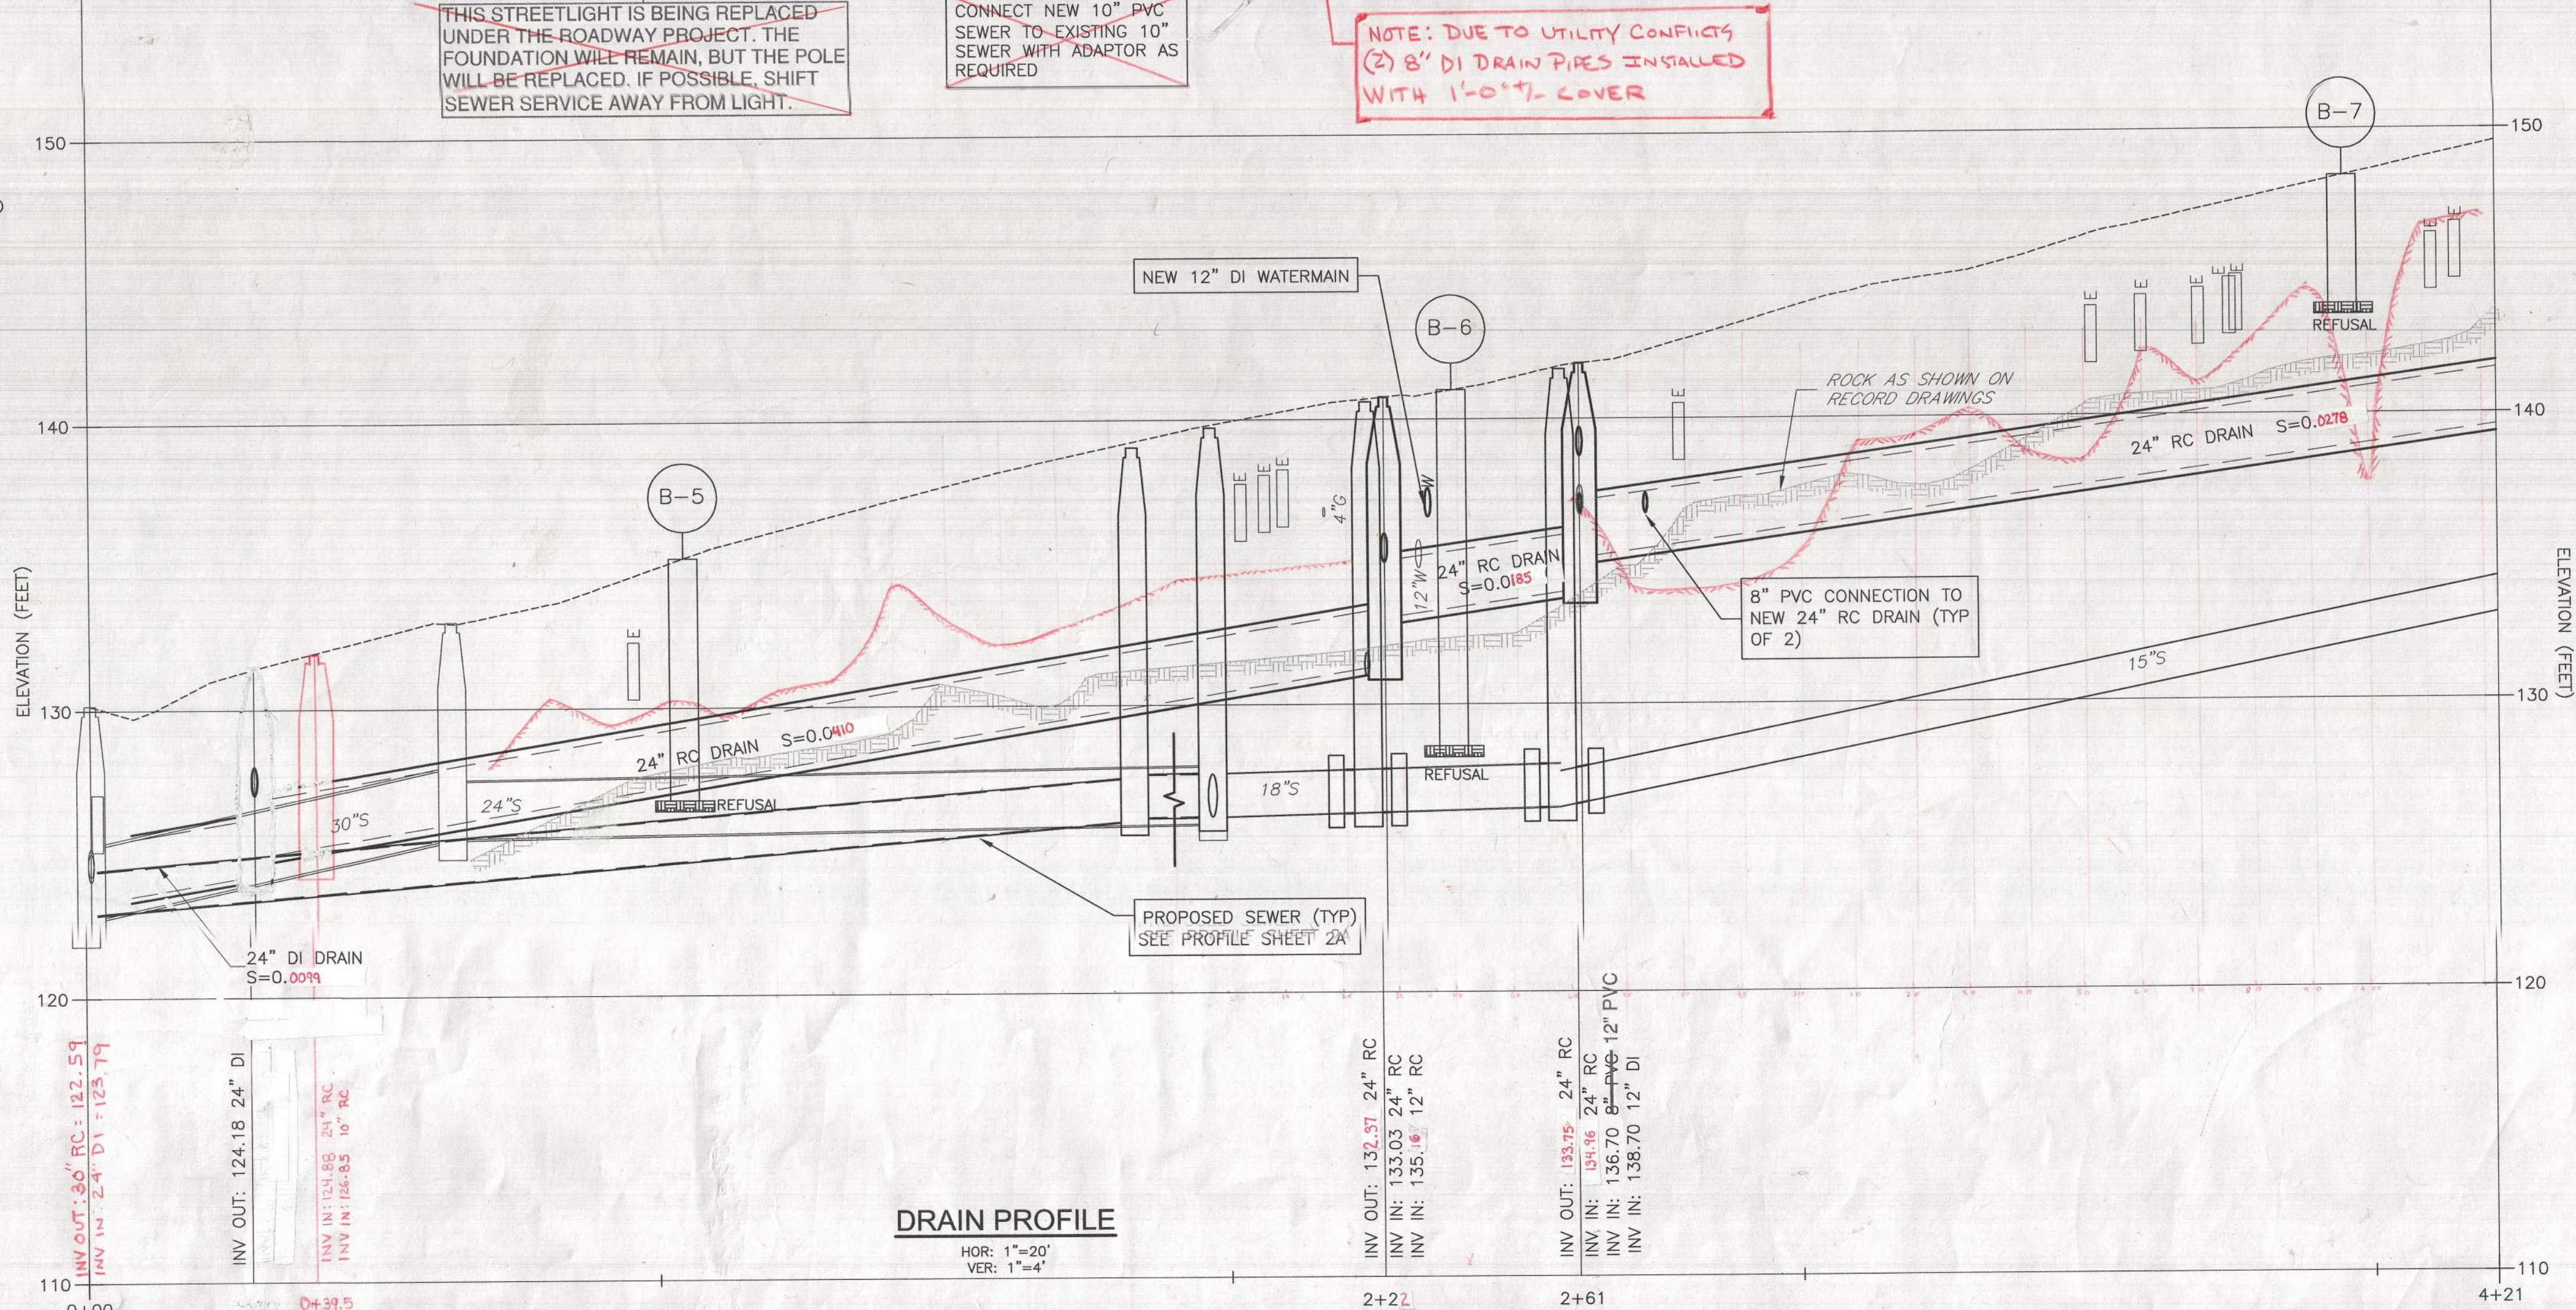

REV. NO.	DATE	DRWN	CHKD	REMARKS
3/8				UPDATED FOR RECORD DRAWINGS

DESIGNED BY: C. KERSHAW
DRAWN BY: E. COREY
SHEET CHK'D BY: N. BEATON
CROSS CHK'D BY: S. SYDE
APPROVED BY: R. NORTON
DATE: JANUARY 2016

CDM Smith
260 West Exchange Street, Suite 300
Providence, RI 02903
Tel: (401) 751-5360

CITY OF NEW BEDFORD, MASSACHUSETTS
WASTEWATER SYSTEM IMPROVEMENTS
UNION STREET SEWER SEPARATION

UNION STREET DRAIN
PLAN AND PROFILE II

PROJECT NO. 0309-107278
FILE NAME: C002ASTPP.DWG
SHEET NO. 2A