
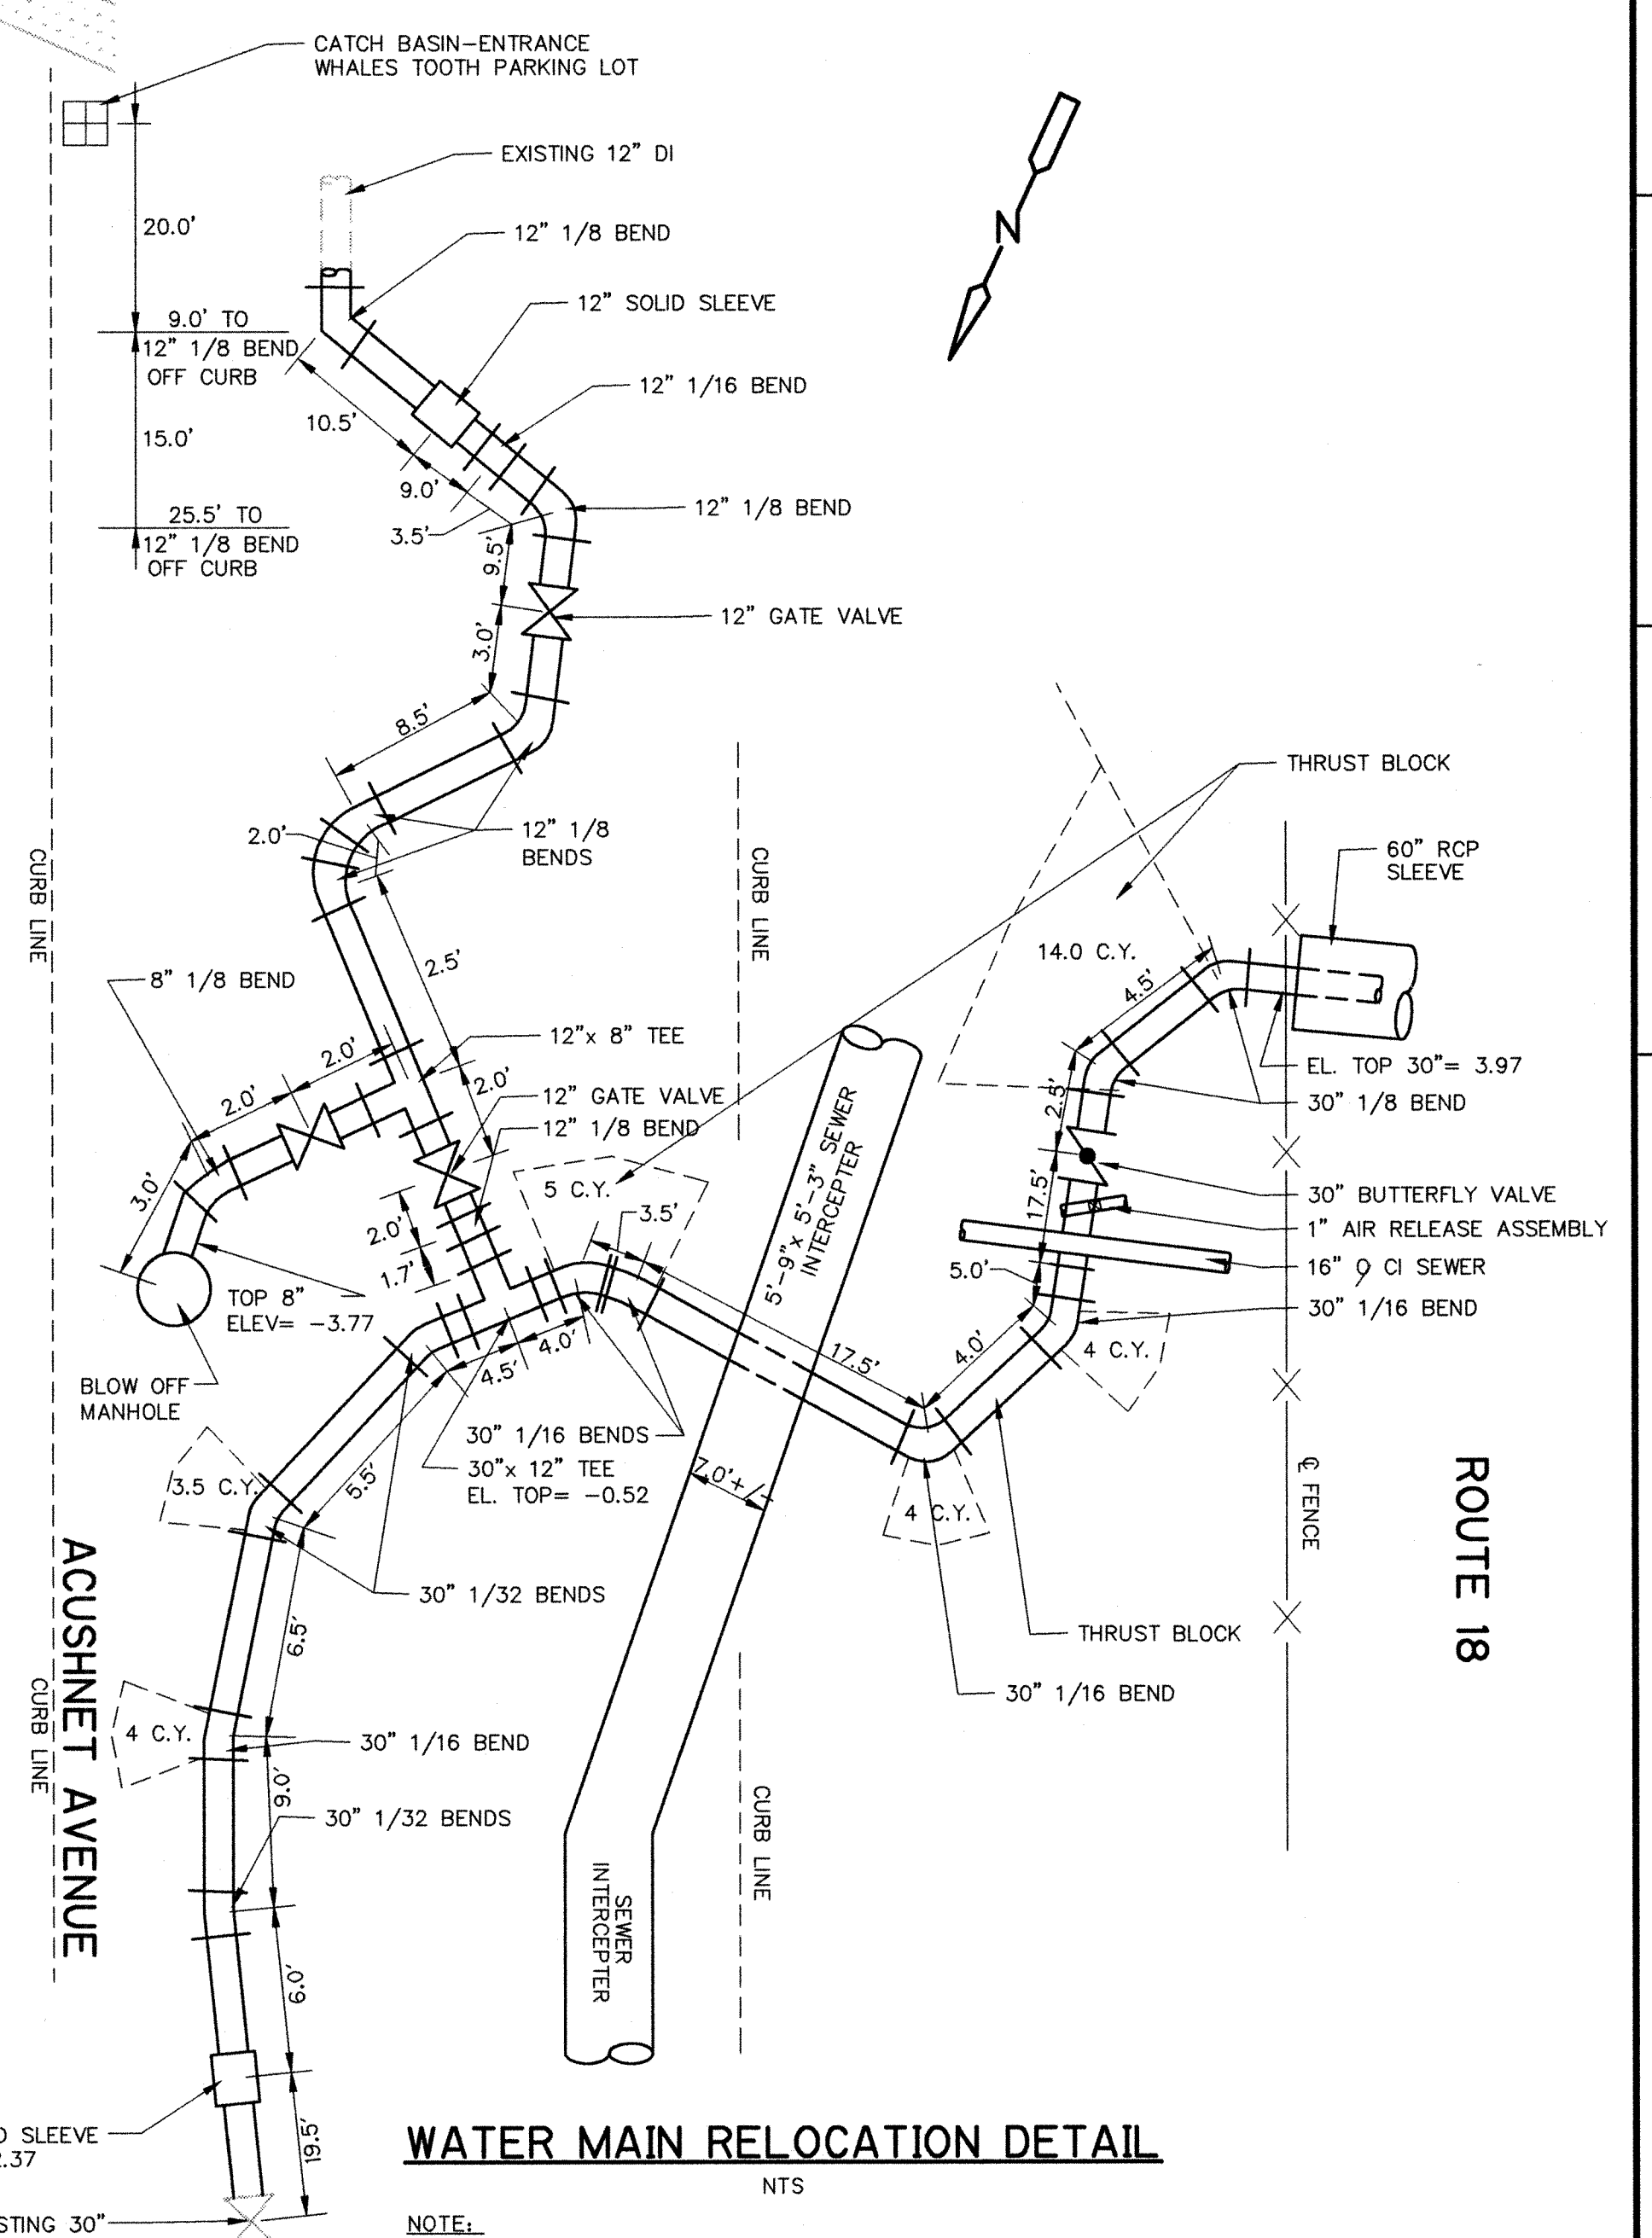
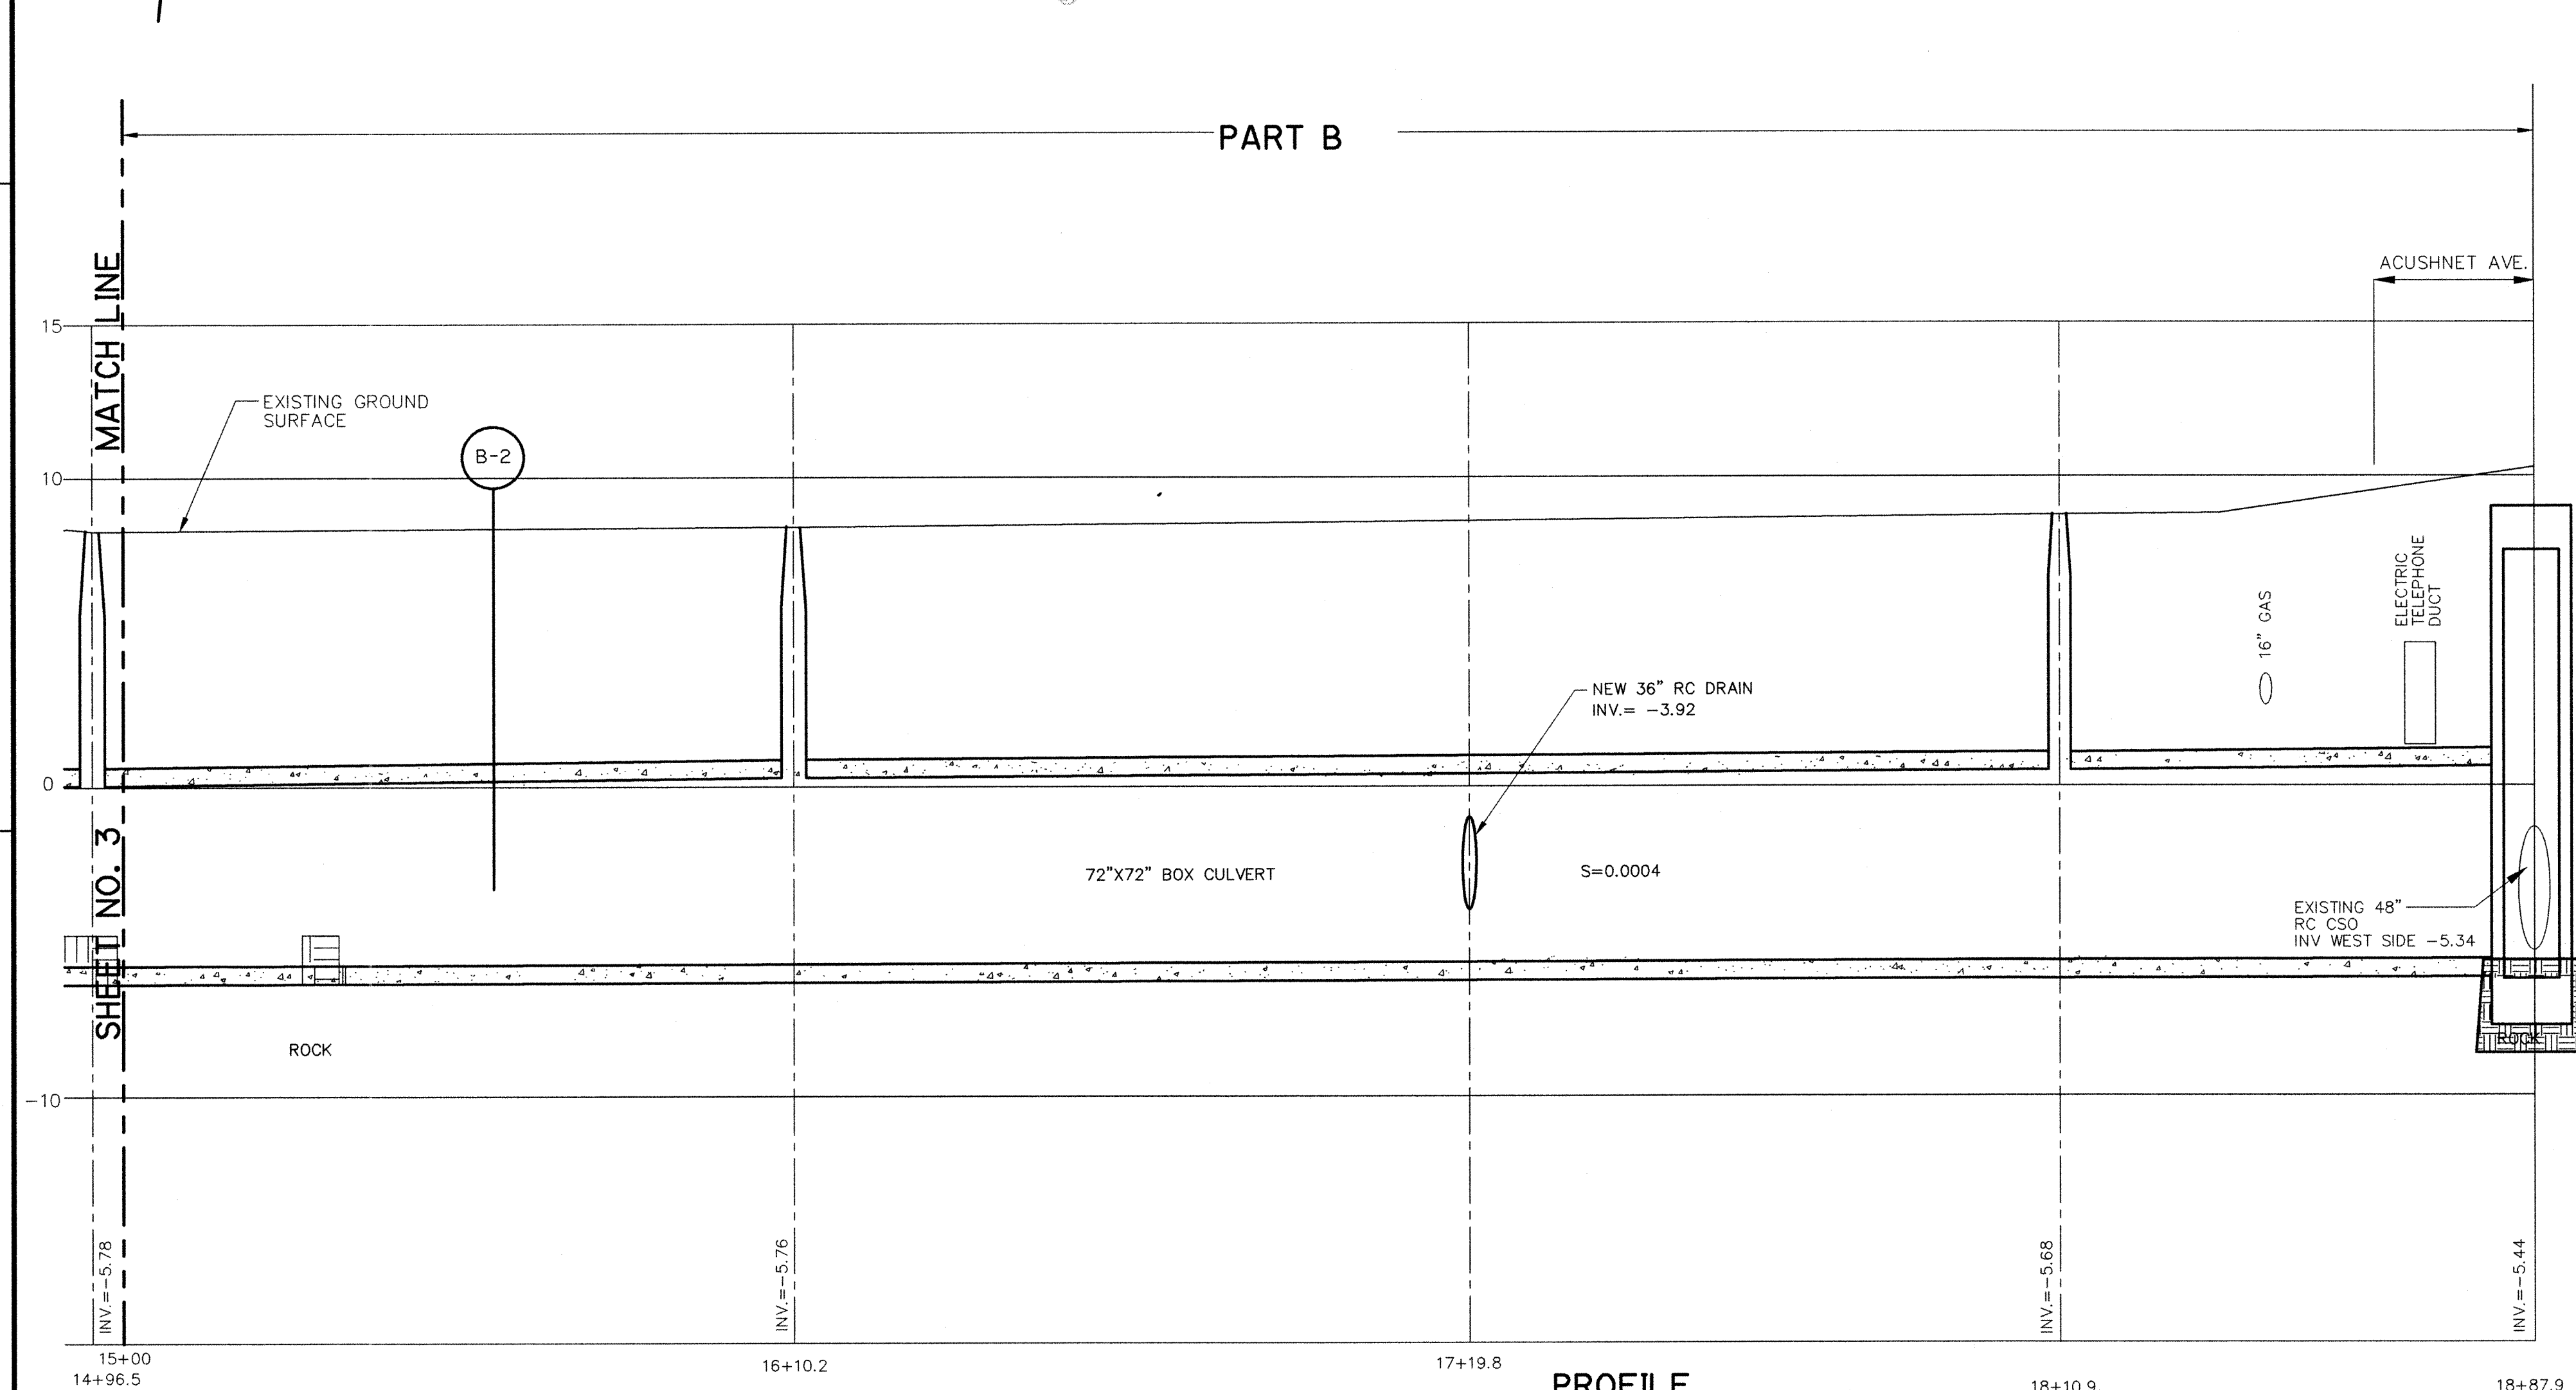


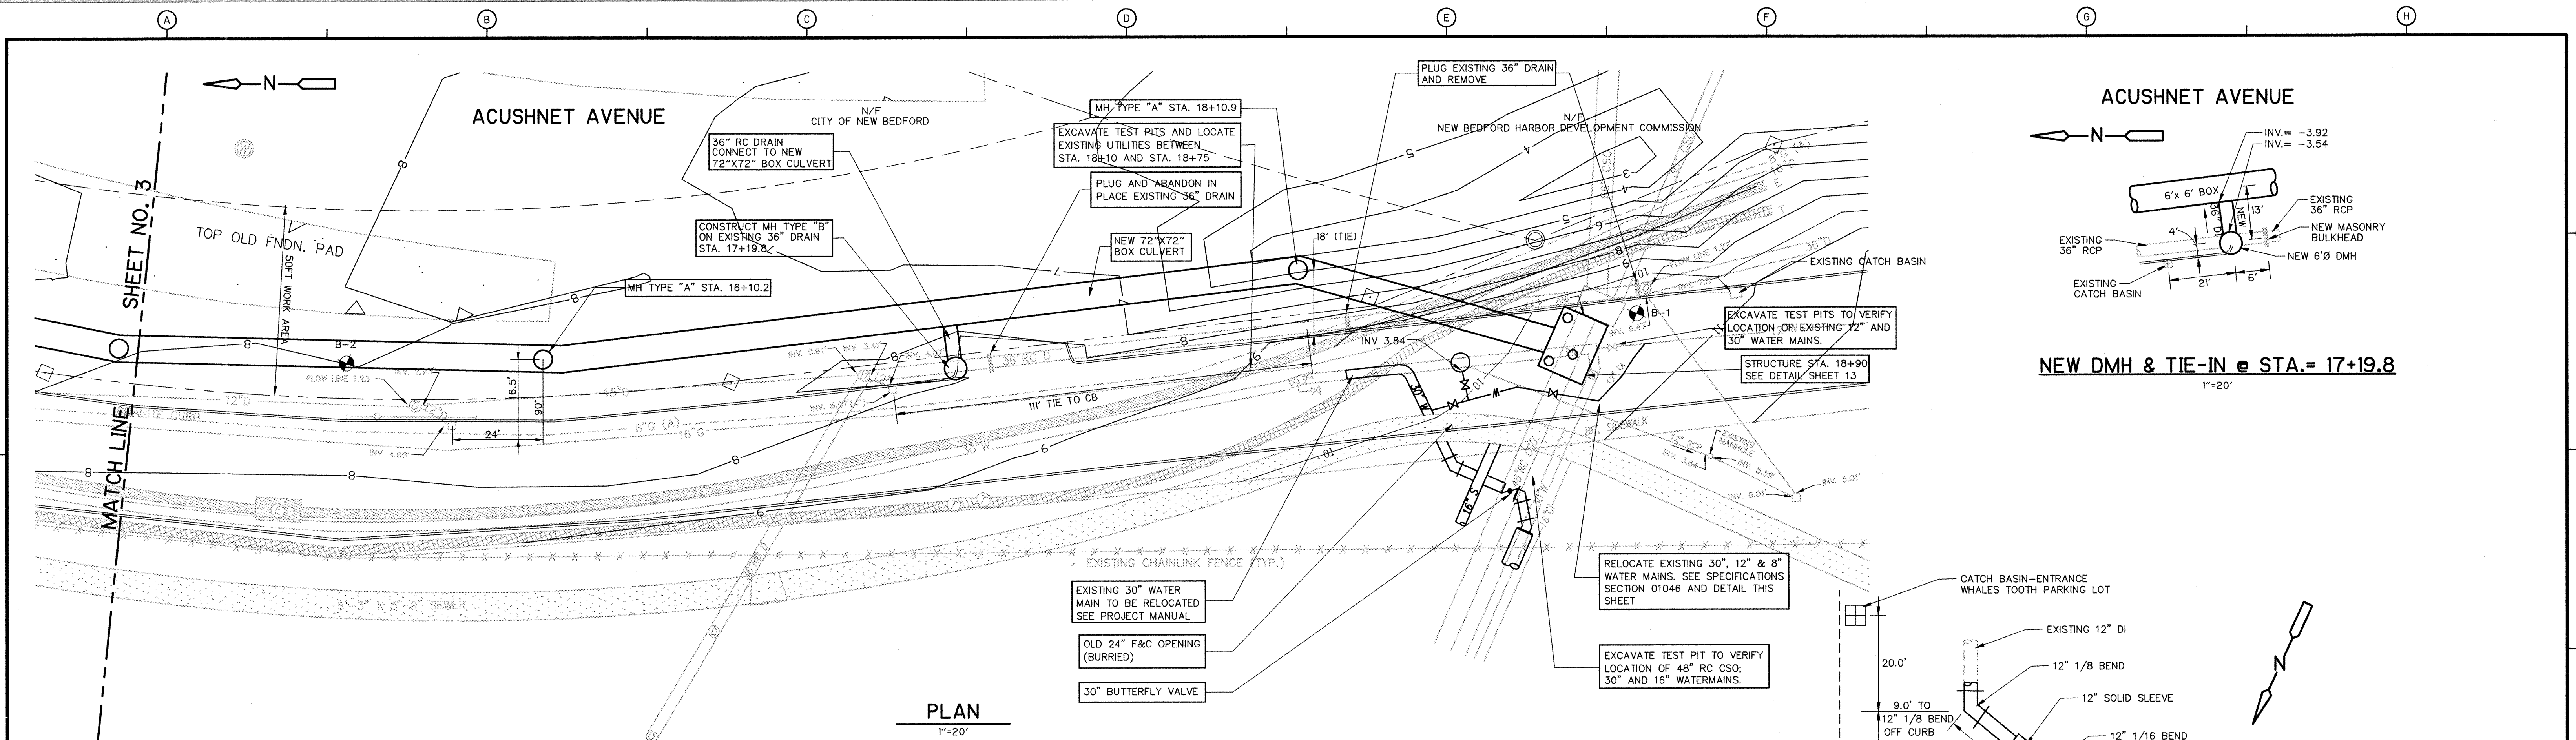

1					02-03	J.C.	S.T.S.	REVISED FOR RECORD DRAWING	DESIGNED BY: <u>BEYER S.</u>	CDM Camp Dresser & McKee Inc. consulting engineering construction operations	CITY OF NEW BEDFORD, MASSACHUSETTS WASTEWATER SYSTEM IMPROVEMENTS RAILYARD CSO PROJECT	PROJECT NO. 0309-31616 FILE NAME: CSTPL004	SHEET NO. 4
2					02-03	J.C.	S.T.S.	REVISED FOR RECORD DRAWING	DRAWN BY: <u>DIAS A.</u>				
									SHEET CHK'D BY: <u>SYDE S.</u>				
									CROSS CHK'D BY: <u>BEYER S.</u>				
									APPROVED BY: <u>HICKOX S.</u>				
									DATE: <u>JULY 2001</u>				
REV. NO.	DATE	DRWN	CHKD	REMARKS									