



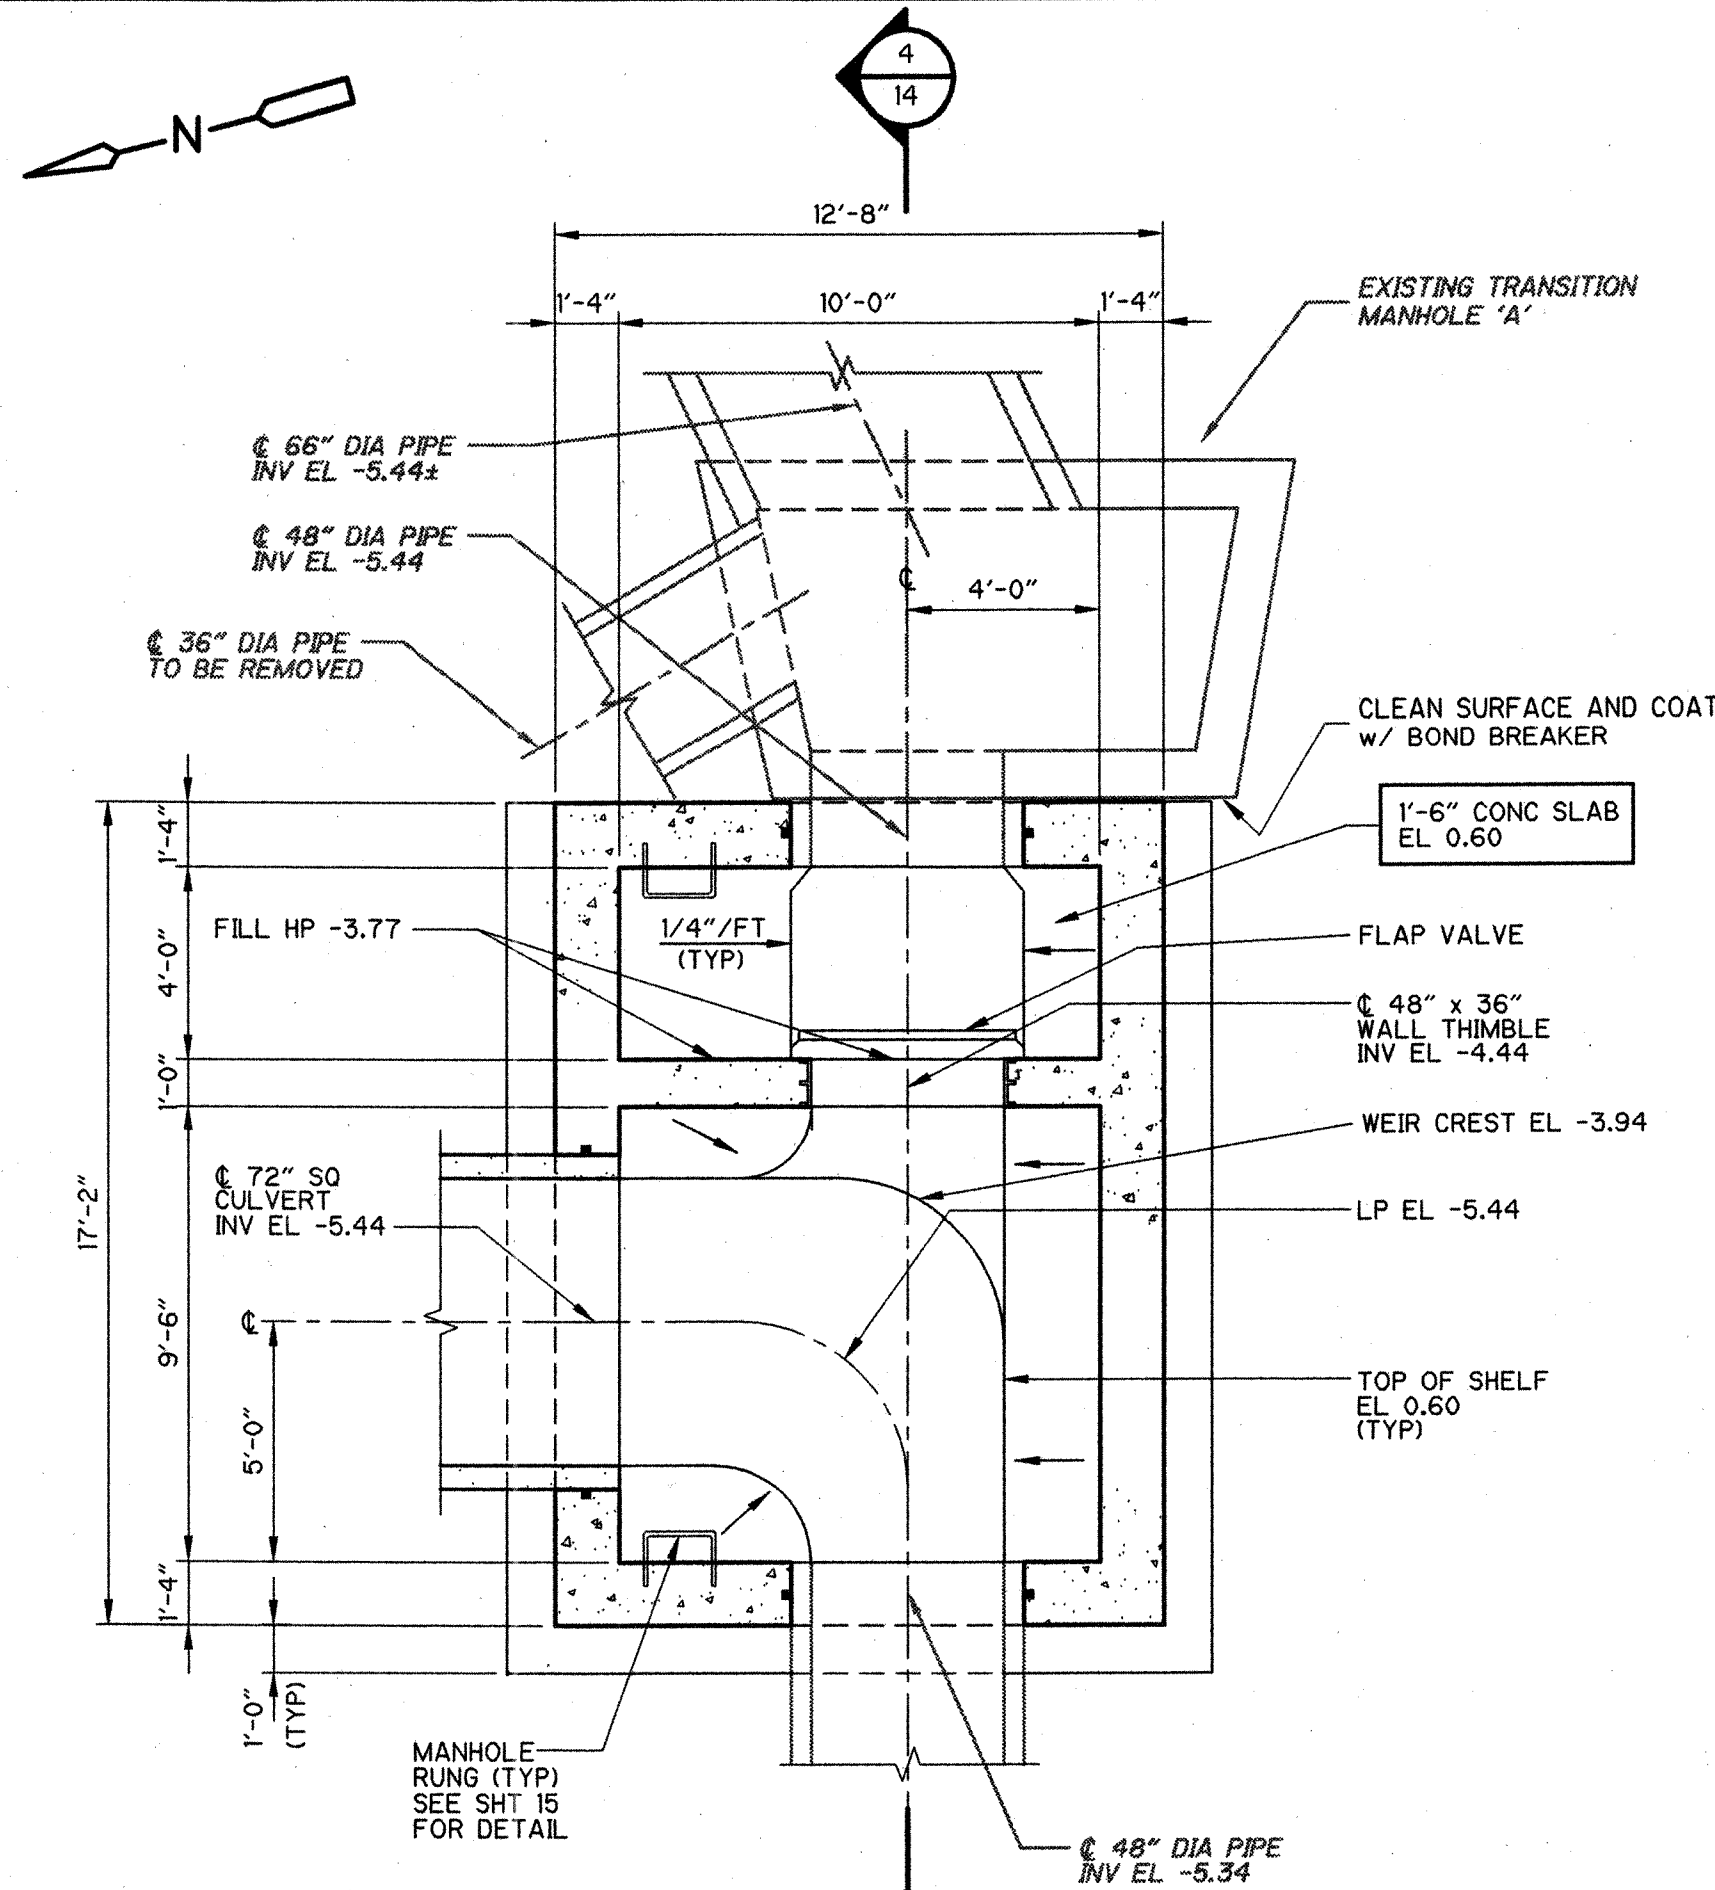

NOTE:
SUPPORT AND PROTECT EXISTING 48\"/>

BASE
PLAN


1/4\"/>

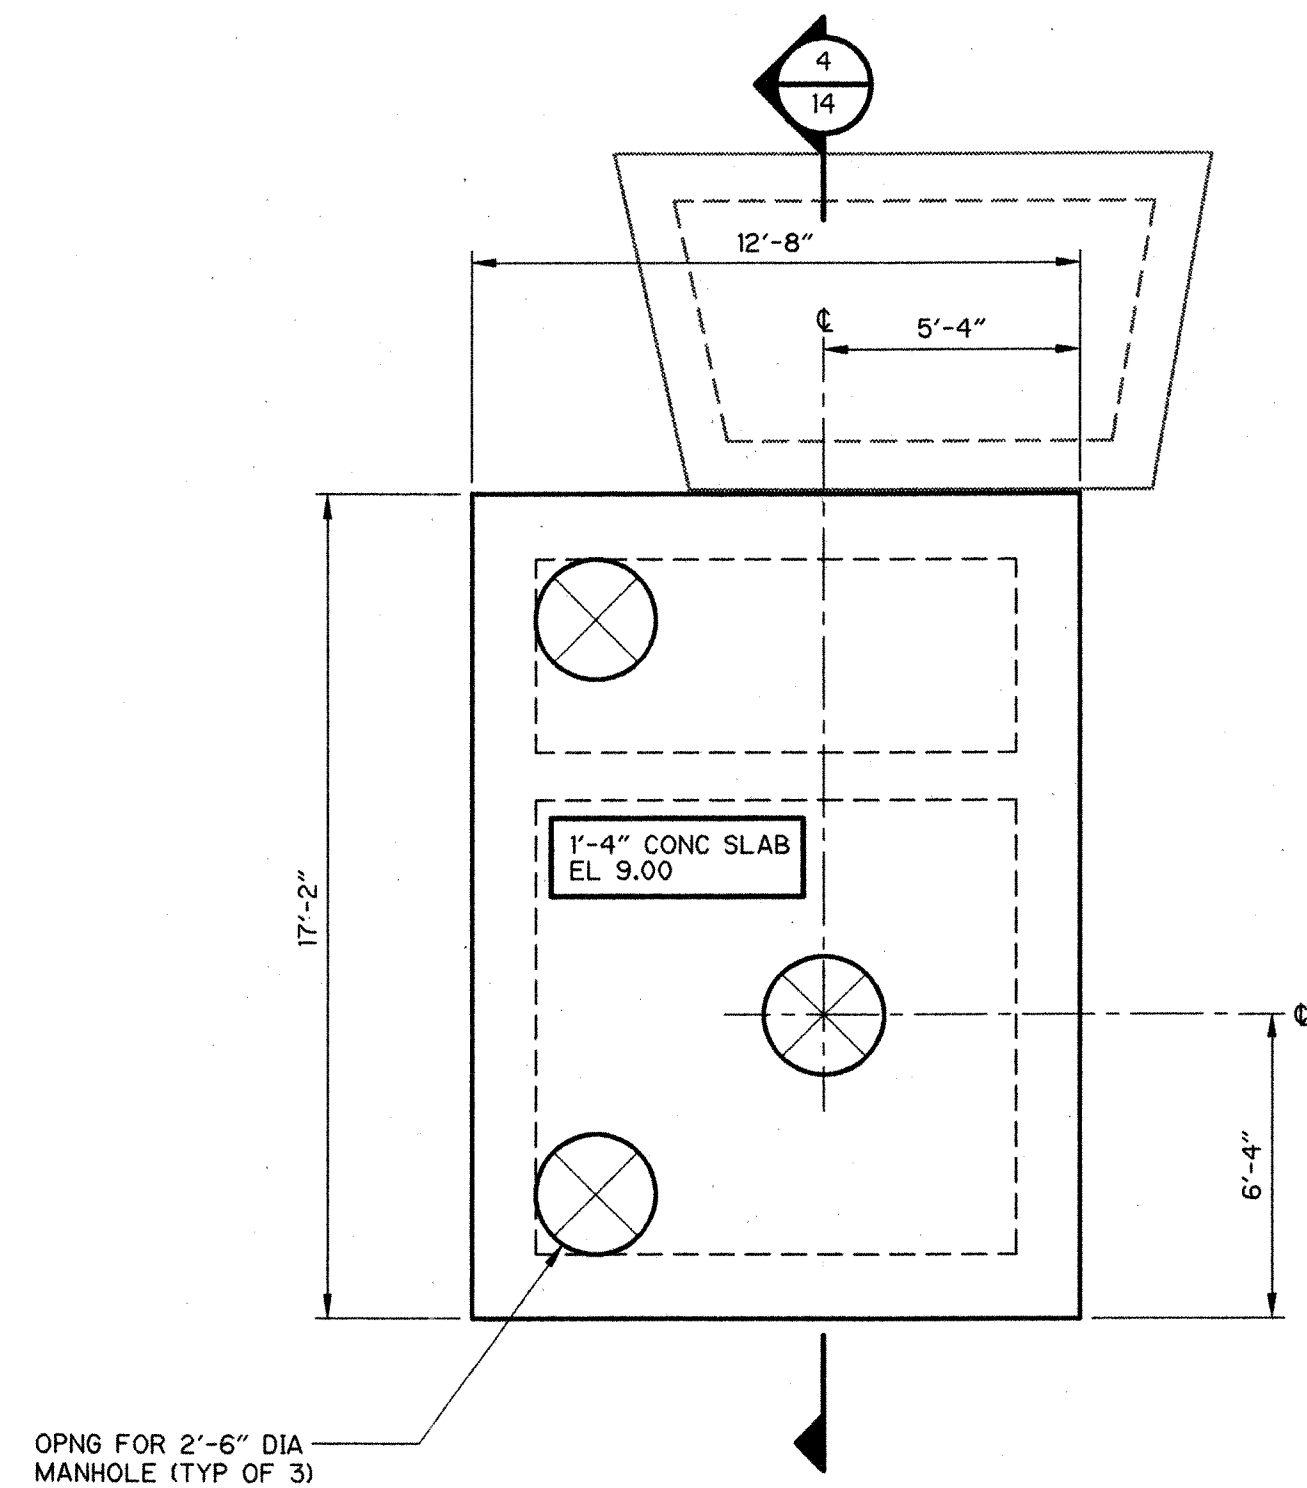

TOP
PLAN


1/4\"/>

STA 18 + 90

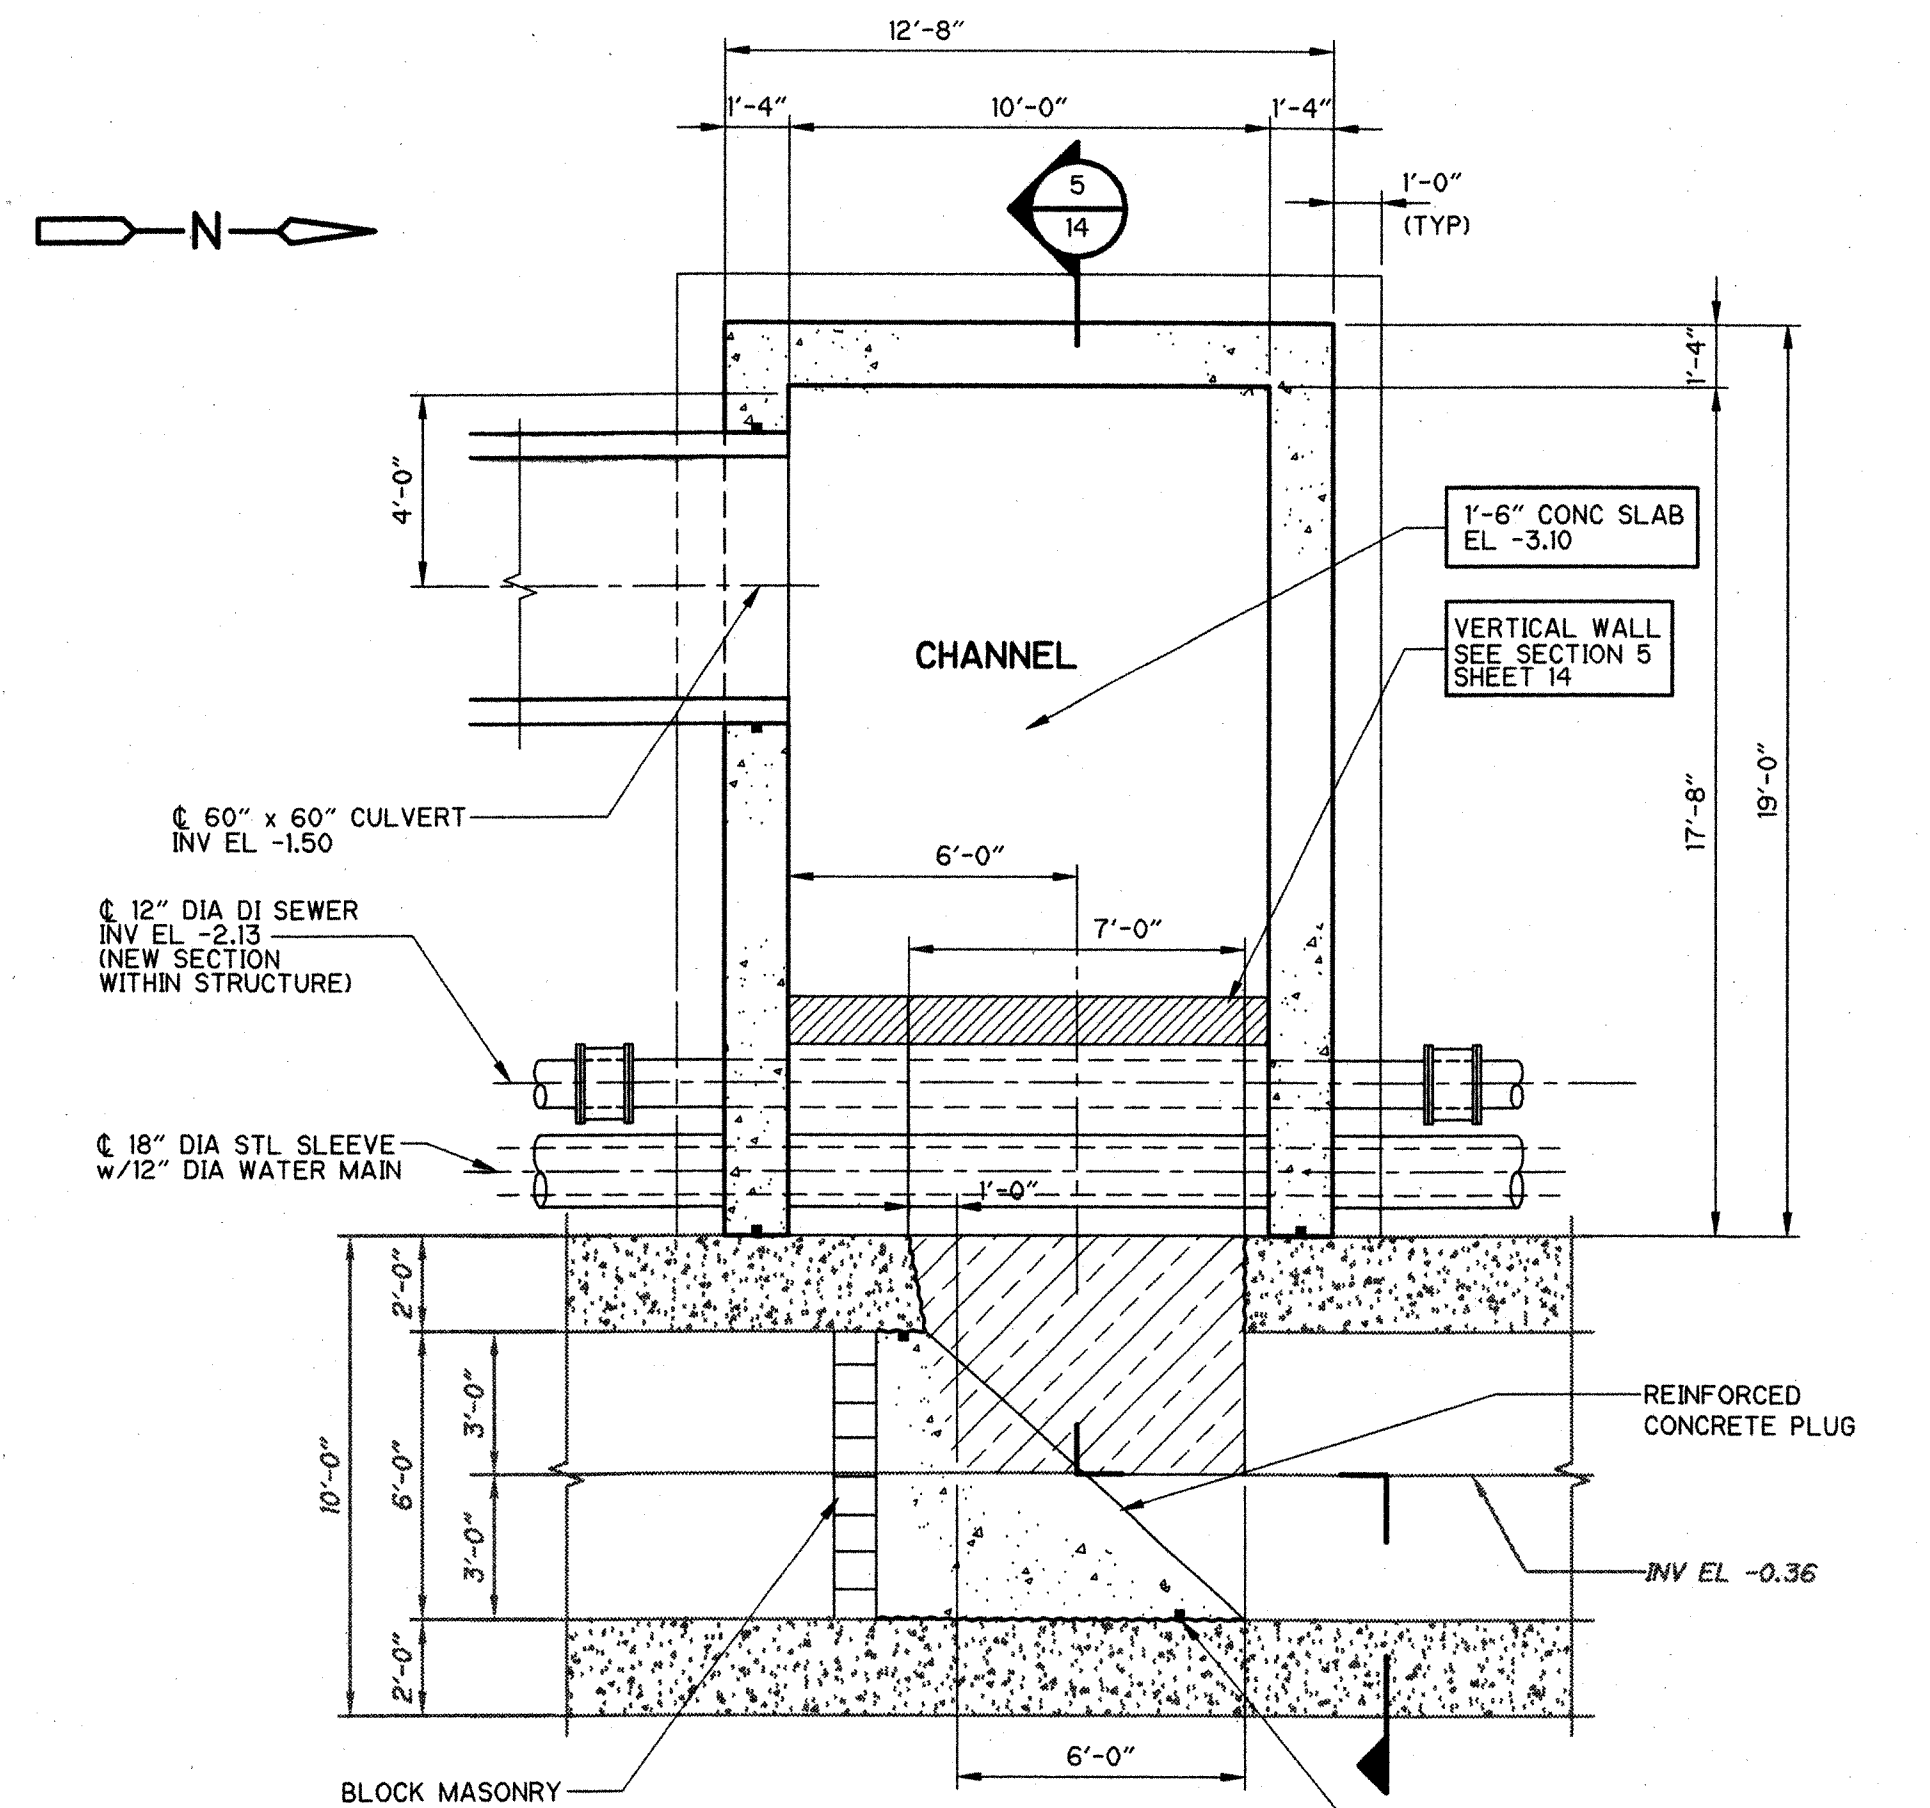

BASE
PLAN

1/4\"/>

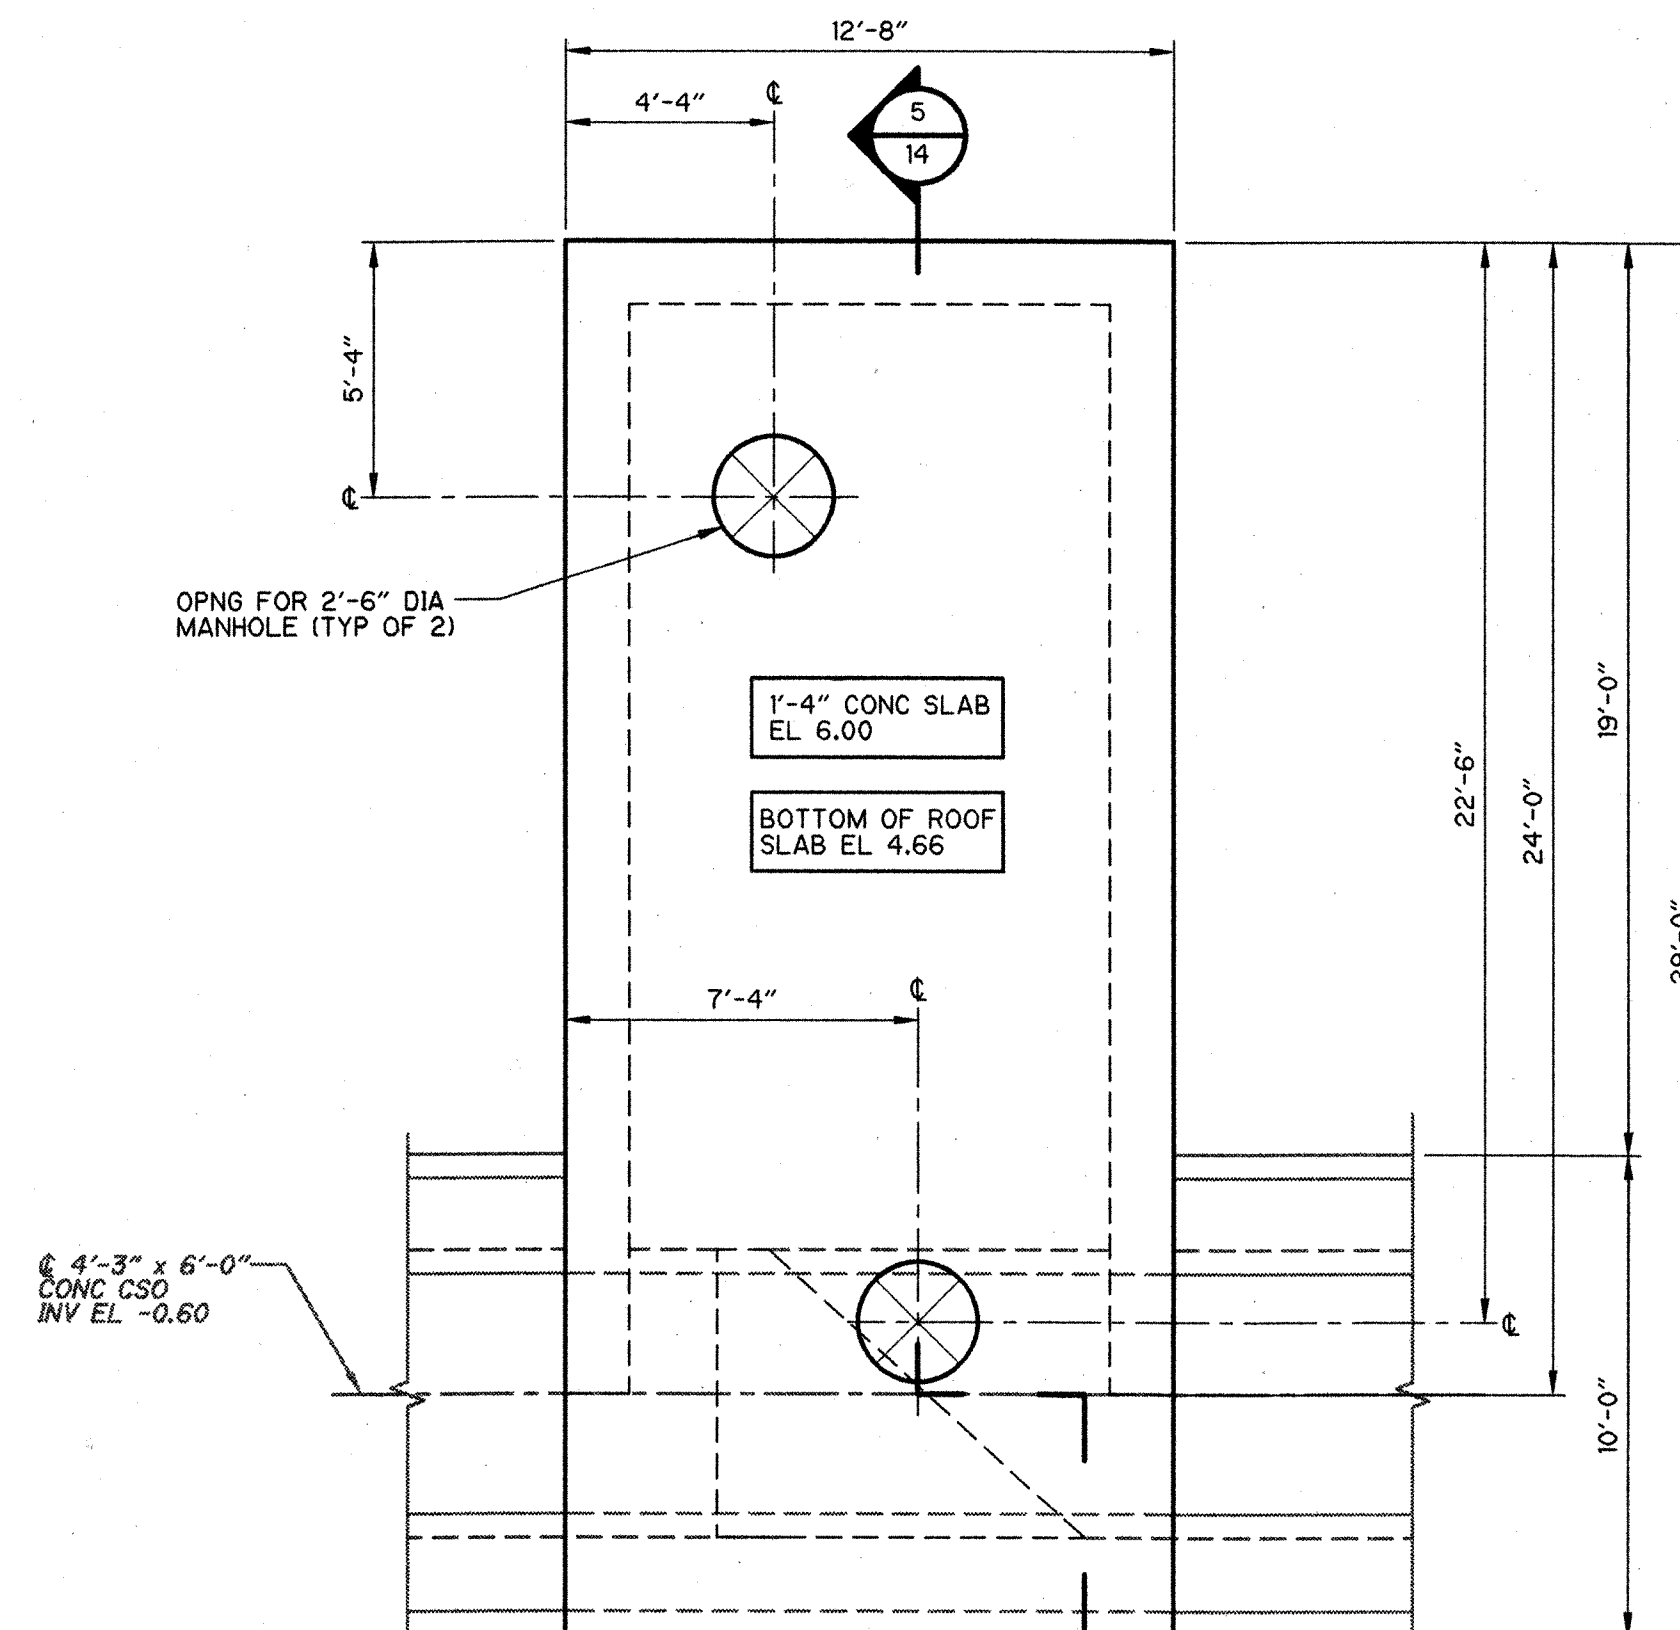

TOP
PLAN

1/4\"/>

STA 14 + 32.8

NOTES:

1. SLANTED TEXT INDICATES INFORMATION AND DIMENSIONS THAT SHALL BE VERIFIED BY THE CONTRACTOR PRIOR TO FABRICATION AND CONSTRUCTION.
2. AT THE JUNCTION STRUCTURE AT STA 14 + 51, THE CONTRACTOR SHALL SUPPORT AND MAINTAIN THE STRUCTURAL INTEGRITY OF THE EXISTING CONCRETE CSO WITHOUT INTERRUPTING THE FLOW DURING THE CONSTRUCTION OF THE JUNCTION STRUCTURE.
3. FOR THE LOCATIONS OF THE JUNCTION STRUCTURES SEE CIVIL DRAWINGS.

1/4\"/>

RECORD DRAWING

REV. NO.	DATE	DRWN	CHKD	REMARKS
1	02-03	J.C.	S.T.S.	REVISED FOR RECORD DRAWING

DESIGNED BY: K. MCGINTY
 DRAWN BY: B.S. HORNER
 SHEET CHK'D BY: K. MCGINTY
 CROSS CHK'D BY: S. BEYER
 APPROVED BY: K. KRAWIEC
 DATE: JULY 2001

CDM Camp Dresser & McKee Inc.



CITY OF NEW BEDFORD, MASSACHUSETTS
 WASTEWATER SYSTEM IMPROVEMENTS

RAILYARD CSO PROJECT

SPECIAL STRUCTURES
 PLANS II

PROJECT NO. 0309-31616
 FILE NAME: SSSPL002

SHEET NO.

13

Accession No: 0309-0756