




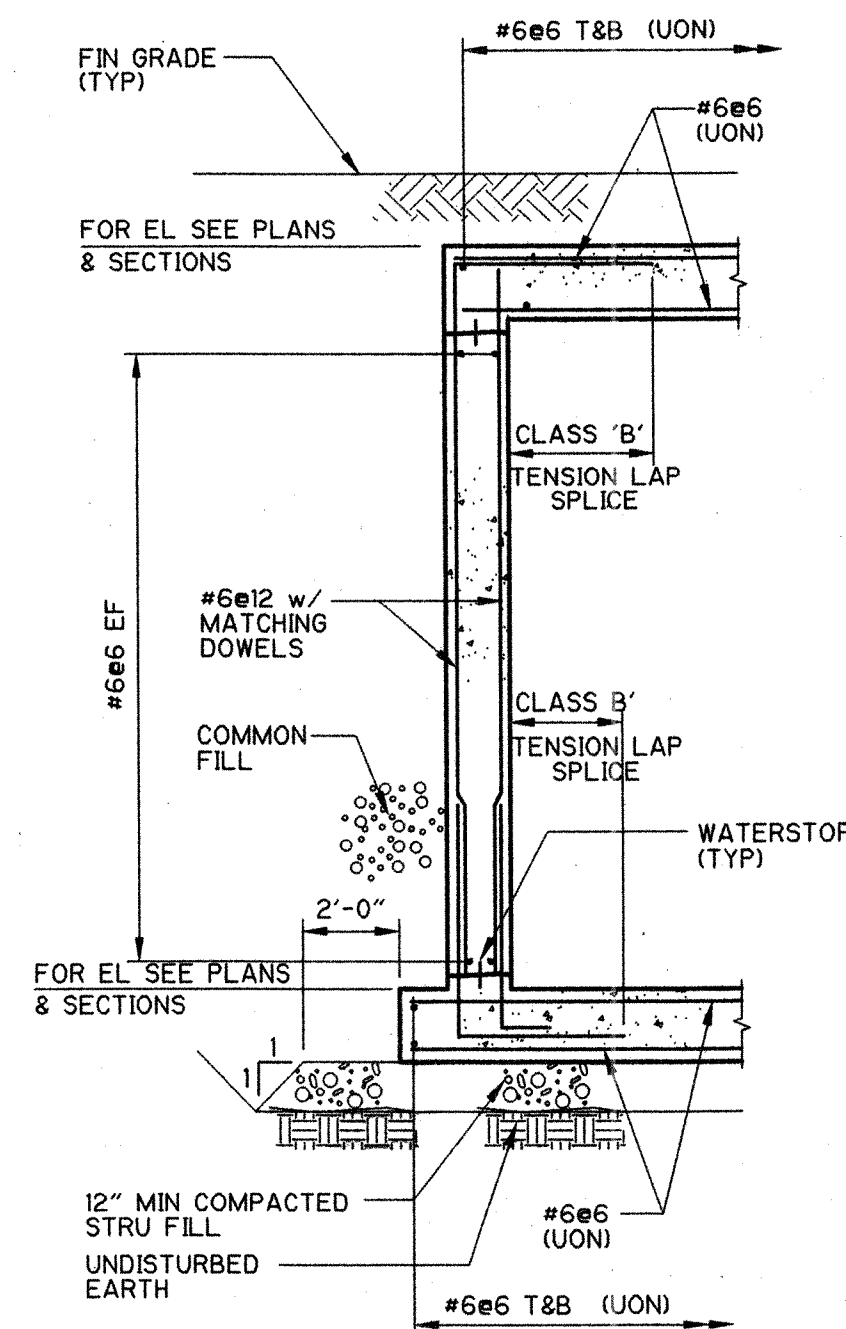


TYPICAL SECTION UON
1/4" = 1'-0"

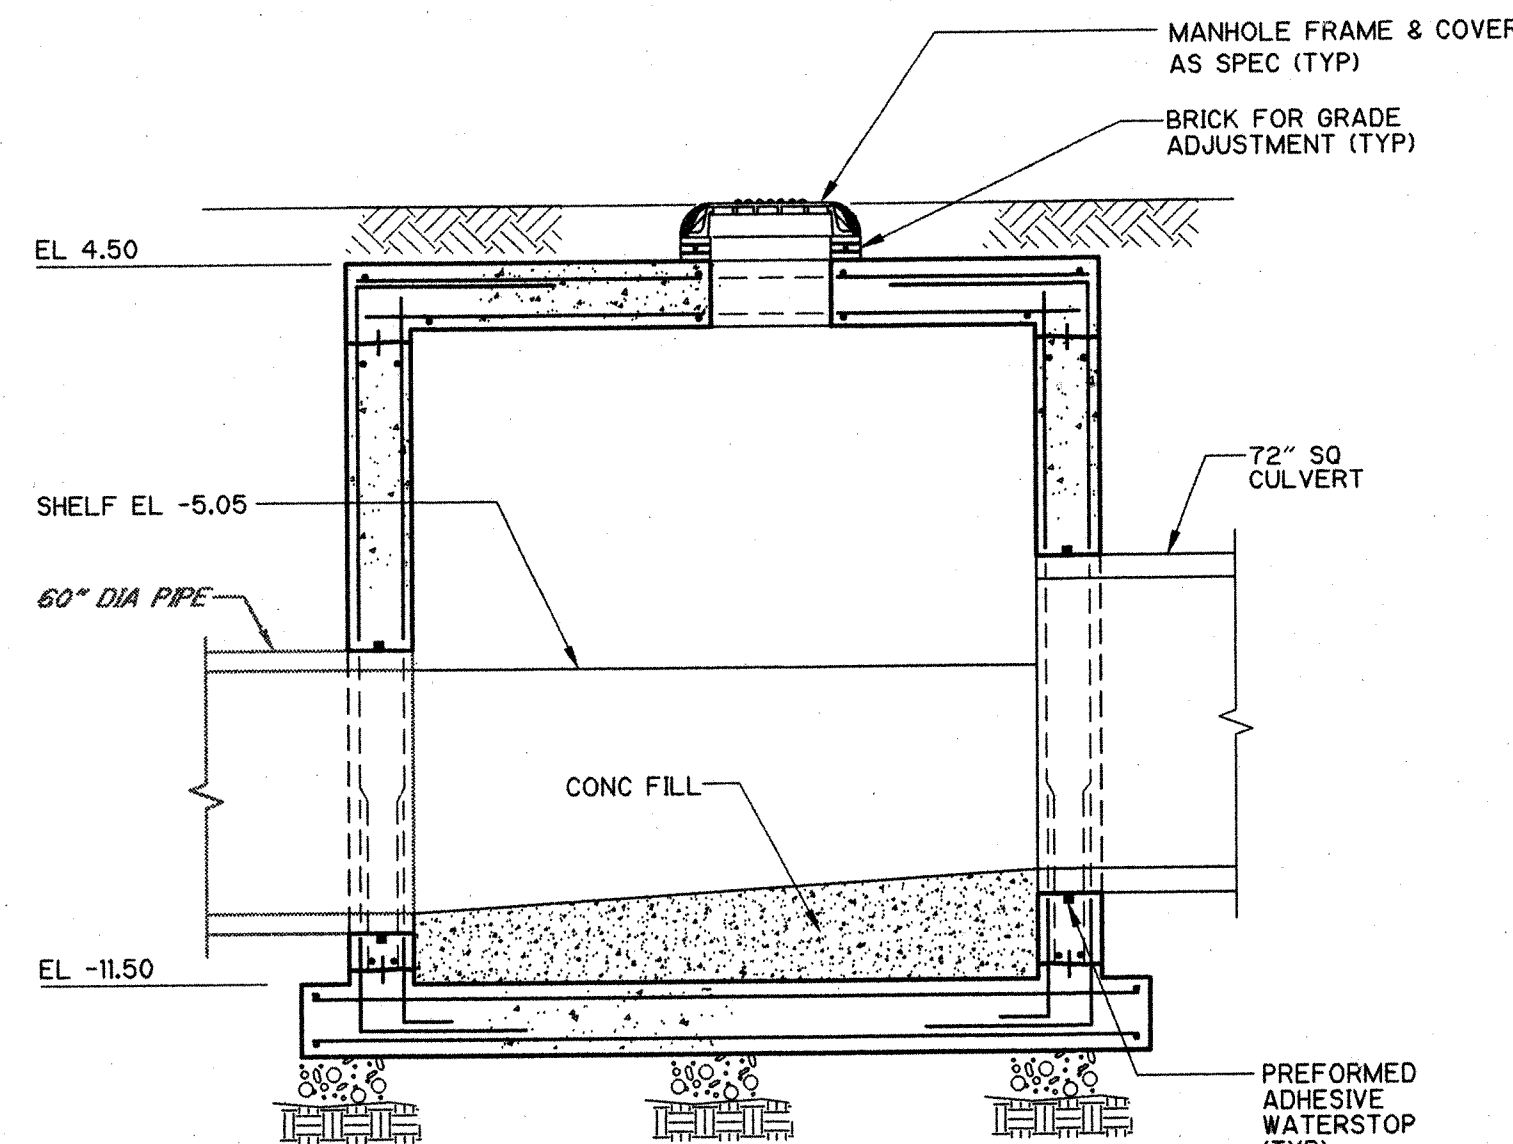


SECTION 1
1/4" = 1'-0"

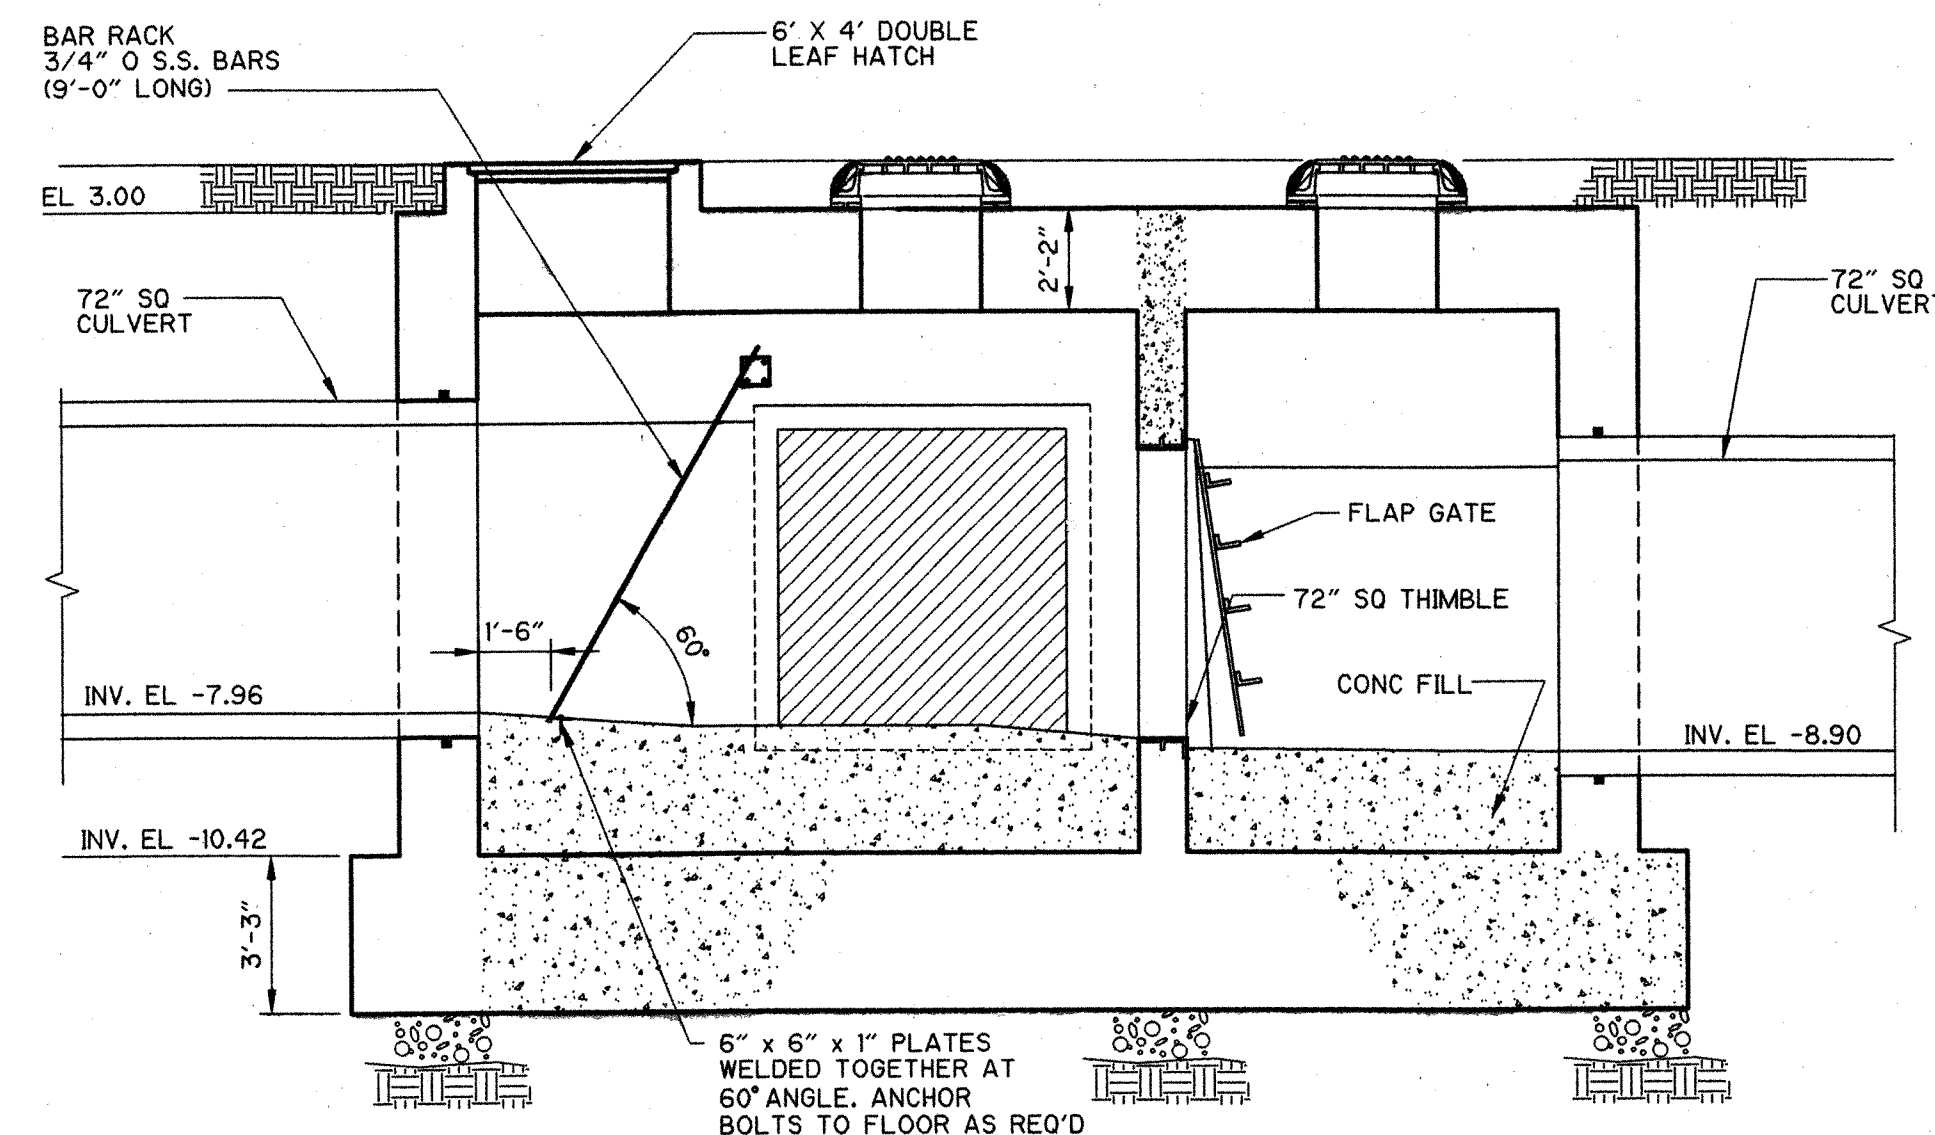


SECTION 2
1/4" = 1'-0"

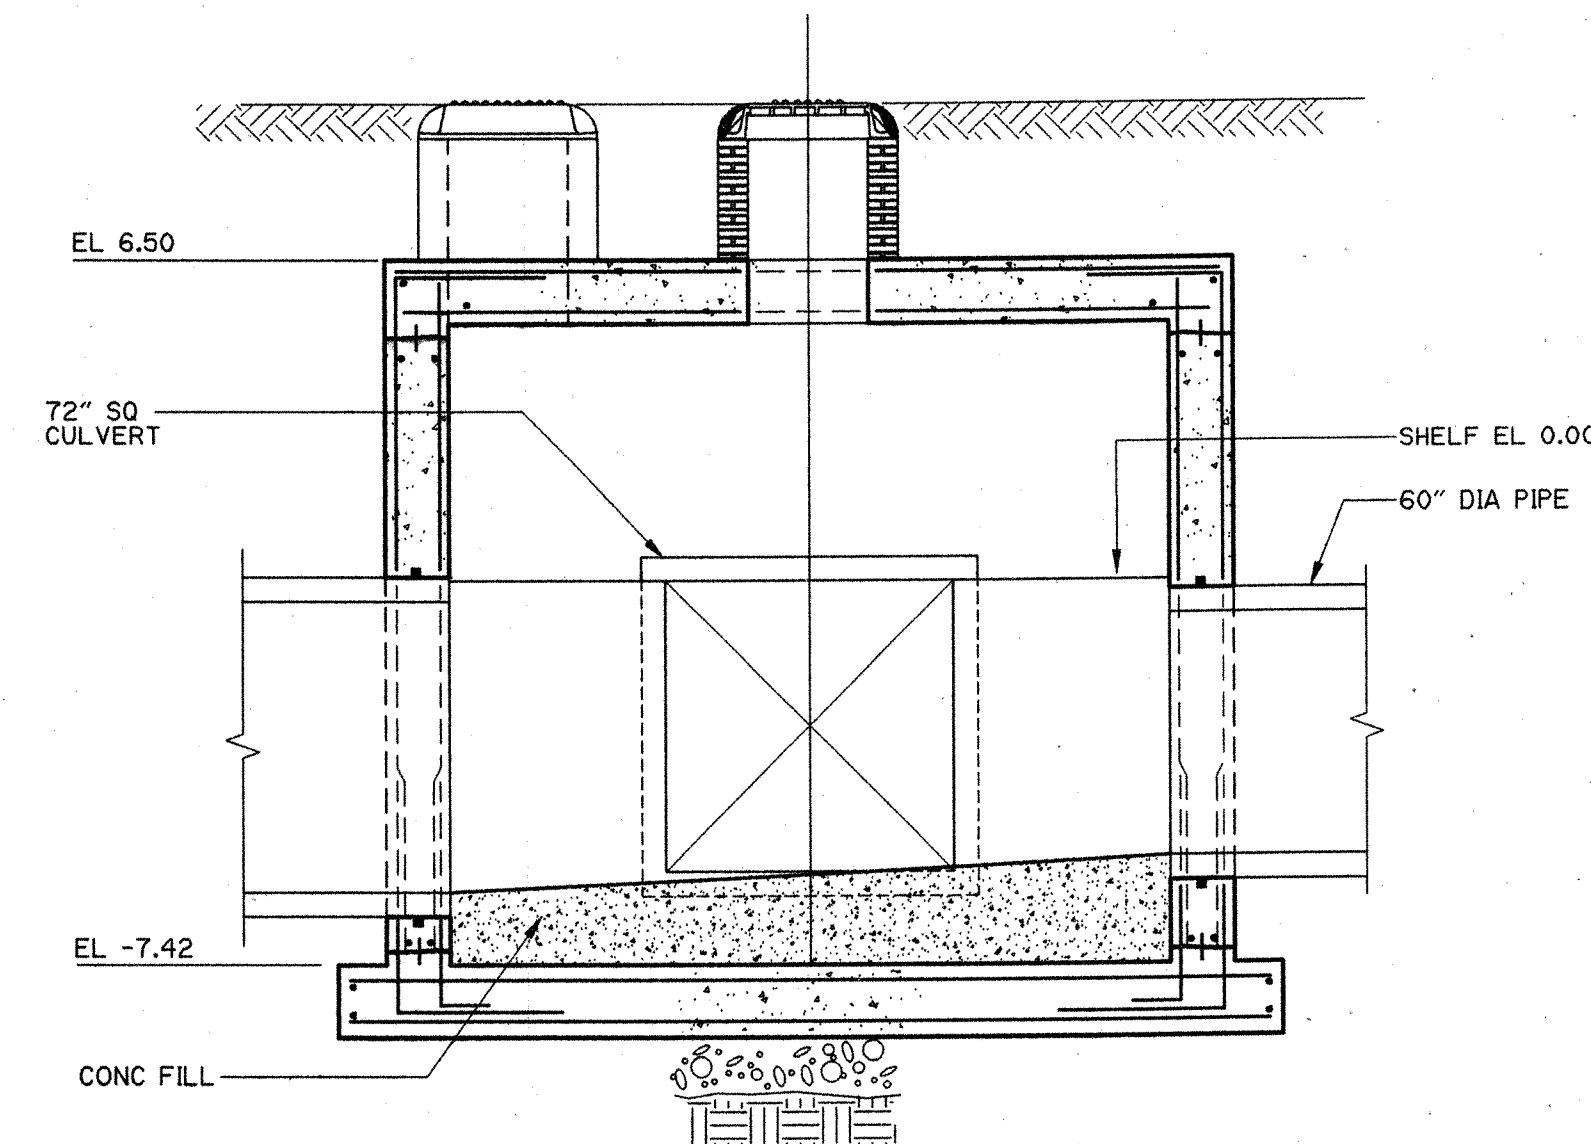

SECTION 3
1/4" = 1'-0"

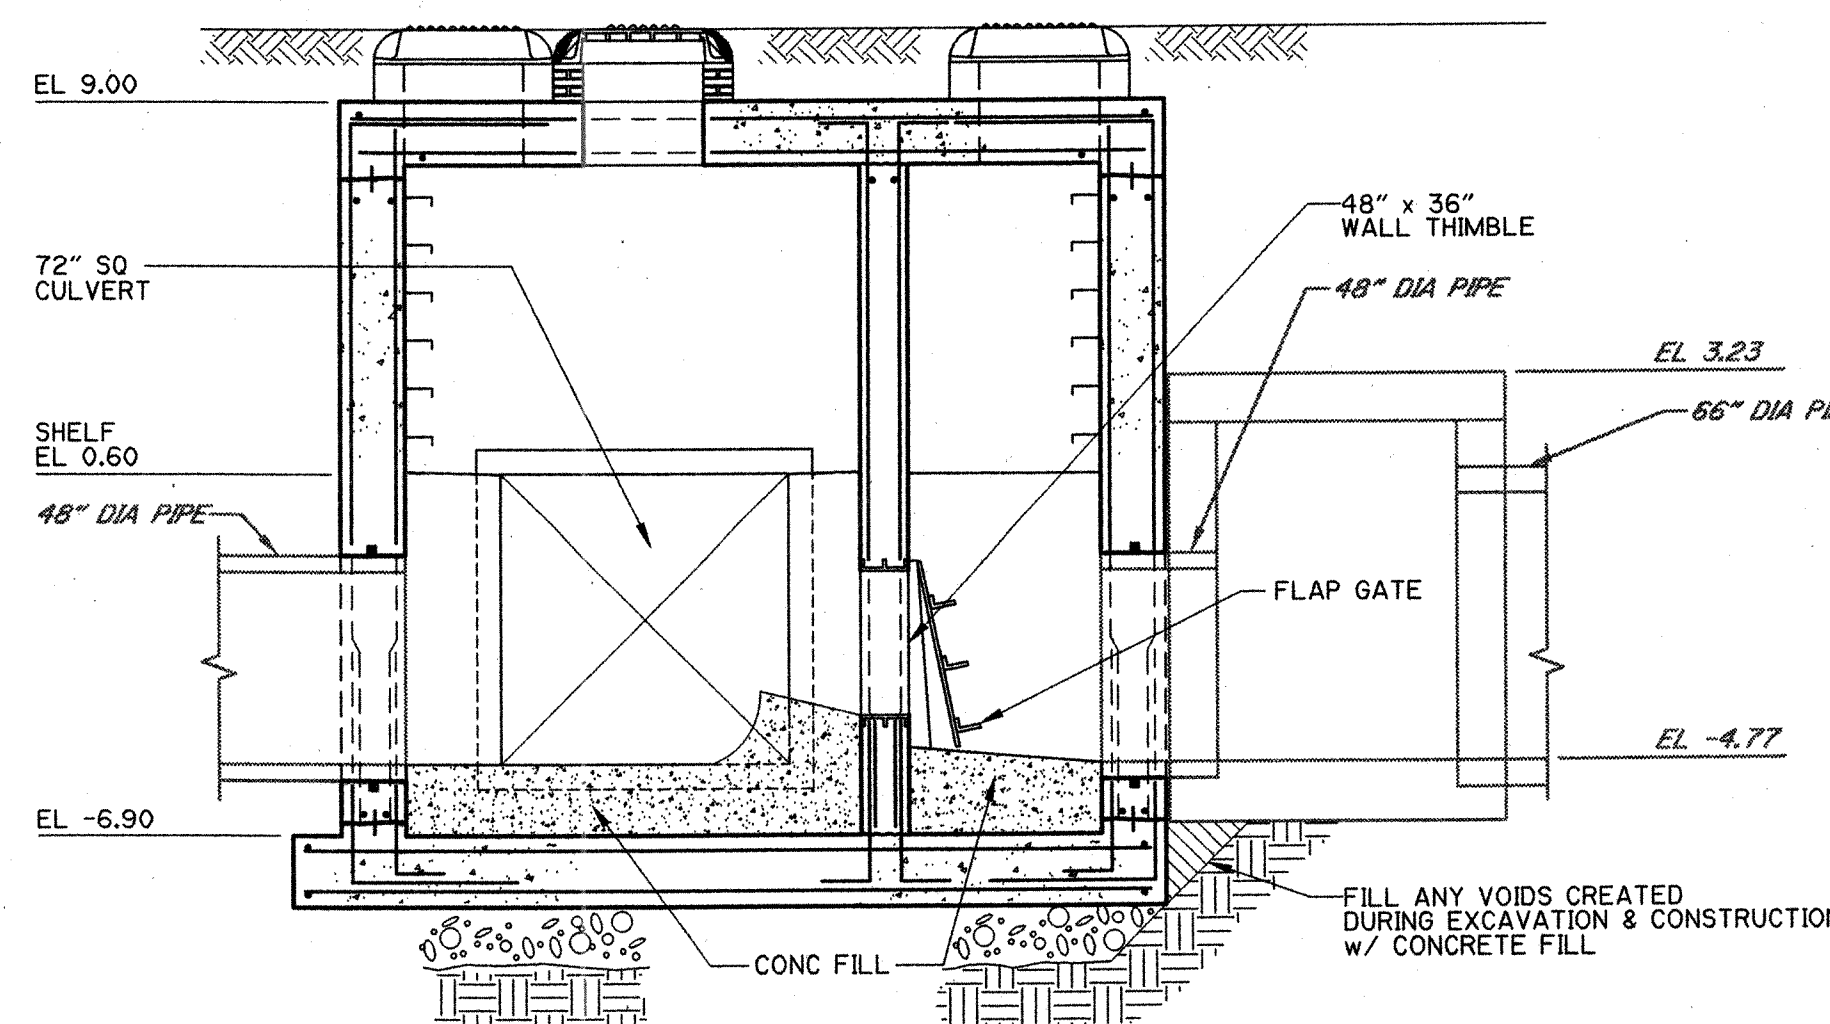

SECTION 4
1/4" = 1'-0"

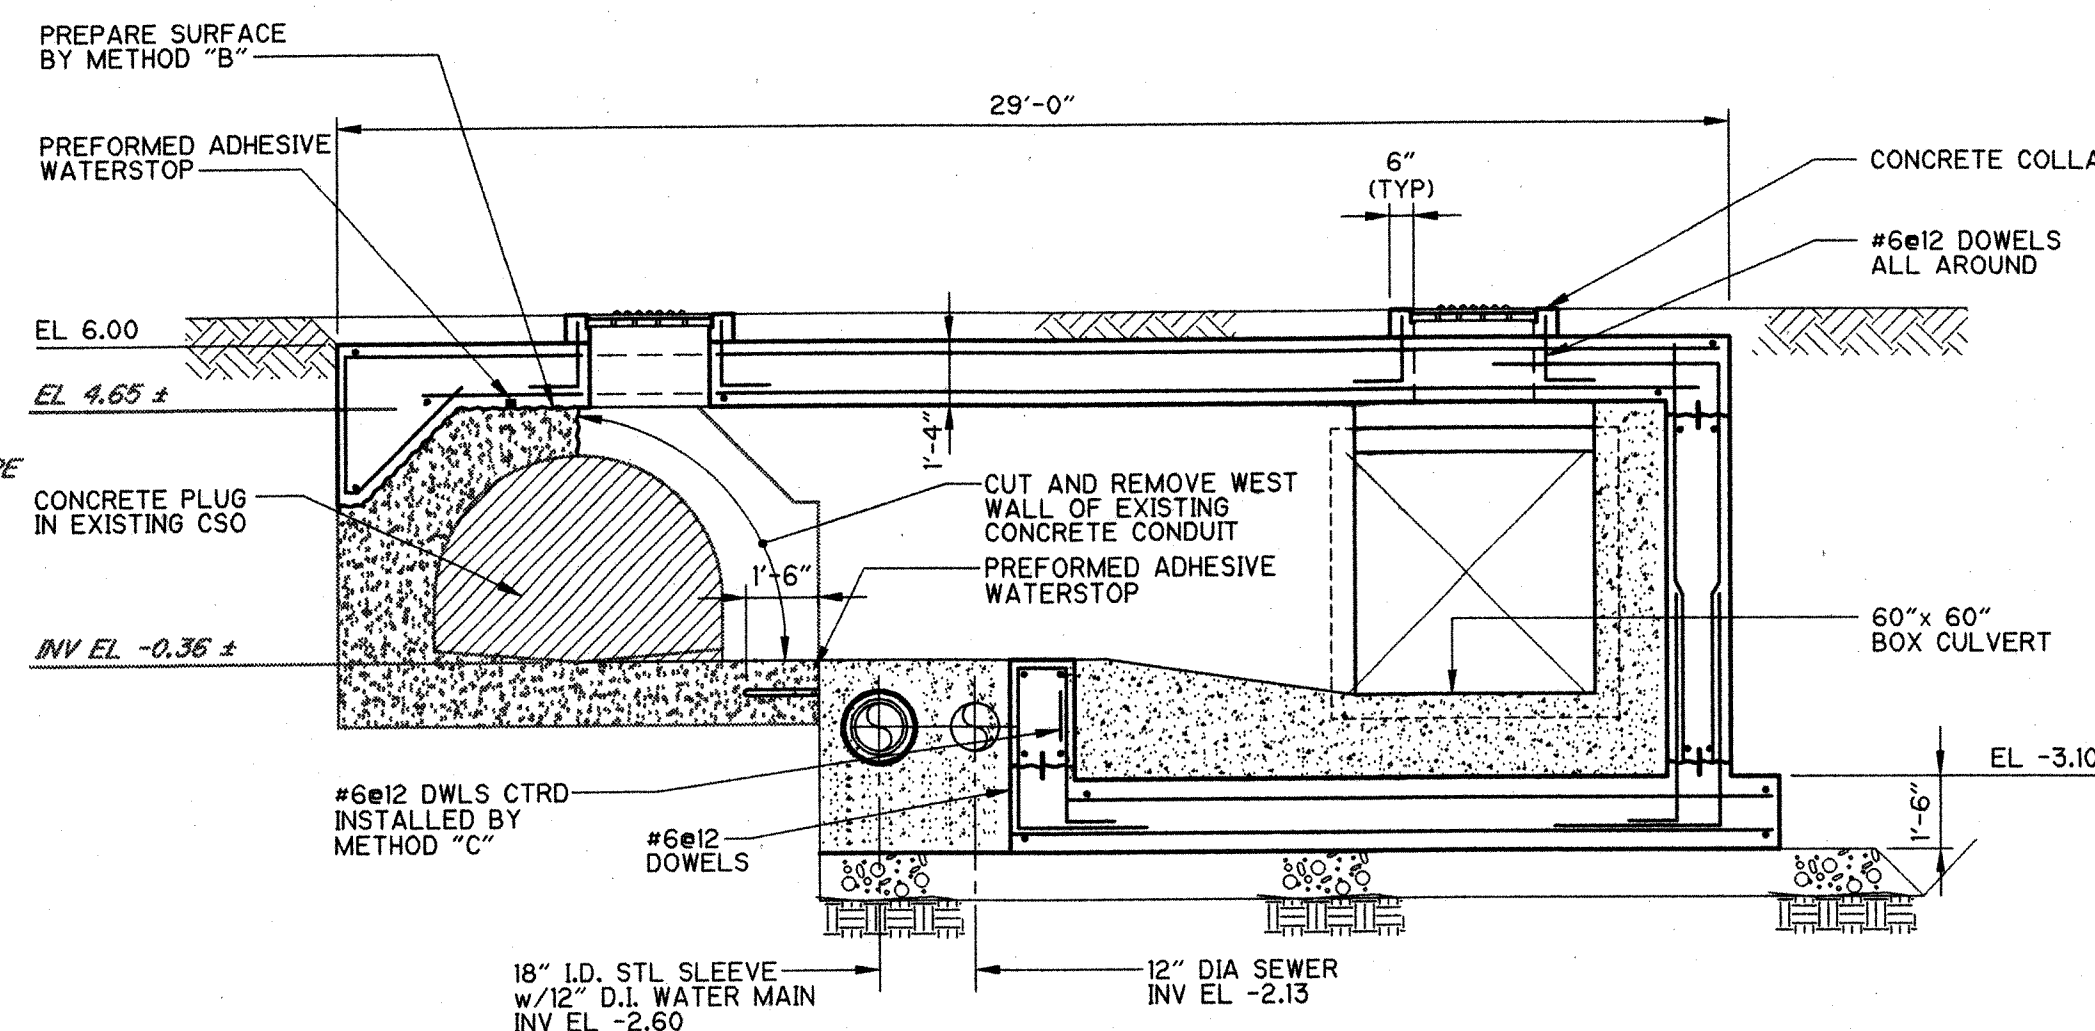

SECTION 5
1/4" = 1'-0"

1/4" = 1'-0"

RECORD DRAWING

REV. NO.	DATE	DRWN	CHKD	REMARKS
1	02-03	J.C.	S.T.S.	REVISED FOR RECORD DRAWING

DESIGNED BY: K. McGINTY
DRAWN BY: B.S. HORNER
SHEET CHK'D BY: K. McGINTY
CROSS CHK'D BY: S. BEYER
APPROVED BY: K. KRAWIEC
DATE: JULY 2001

CDM Camp Dresser & McKee Inc.
consulting
engineering
construction
operations

**CITY OF NEW BEDFORD, MASSACHUSETTS
WASTEWATER SYSTEM IMPROVEMENTS
RAILYARD CSO PROJECT**

**SPECIAL STRUCTURES
SECTIONS I**

PROJECT NO. 0309-31616
FILE NAME: SSSSC001
SHEET NO.
14
Accession No: 0309-0757