


NEW BEDFORD RTE. 18 (CITY CONNECTOR)					
PUB. RD. DIV. NO.	STATE	FED. AID PROJ. NO.	FISCAL YEAR	SHEET NO.	TOTAL SHEETS
1	MASS.	U-143-001		35	287


DRAINAGE
MAXFIELD ST. - OUTFALL
(REVISED DEC 20, 1972)

Place 54" RCP Class II Sleeve for 30" Water Main (Between the East and West State Highway L.O. Lines).
The 54" Sleeve shall meet all requirements of storm drainage and shall be paid for at the contract bid price for 54" RCP (Item 243.54)

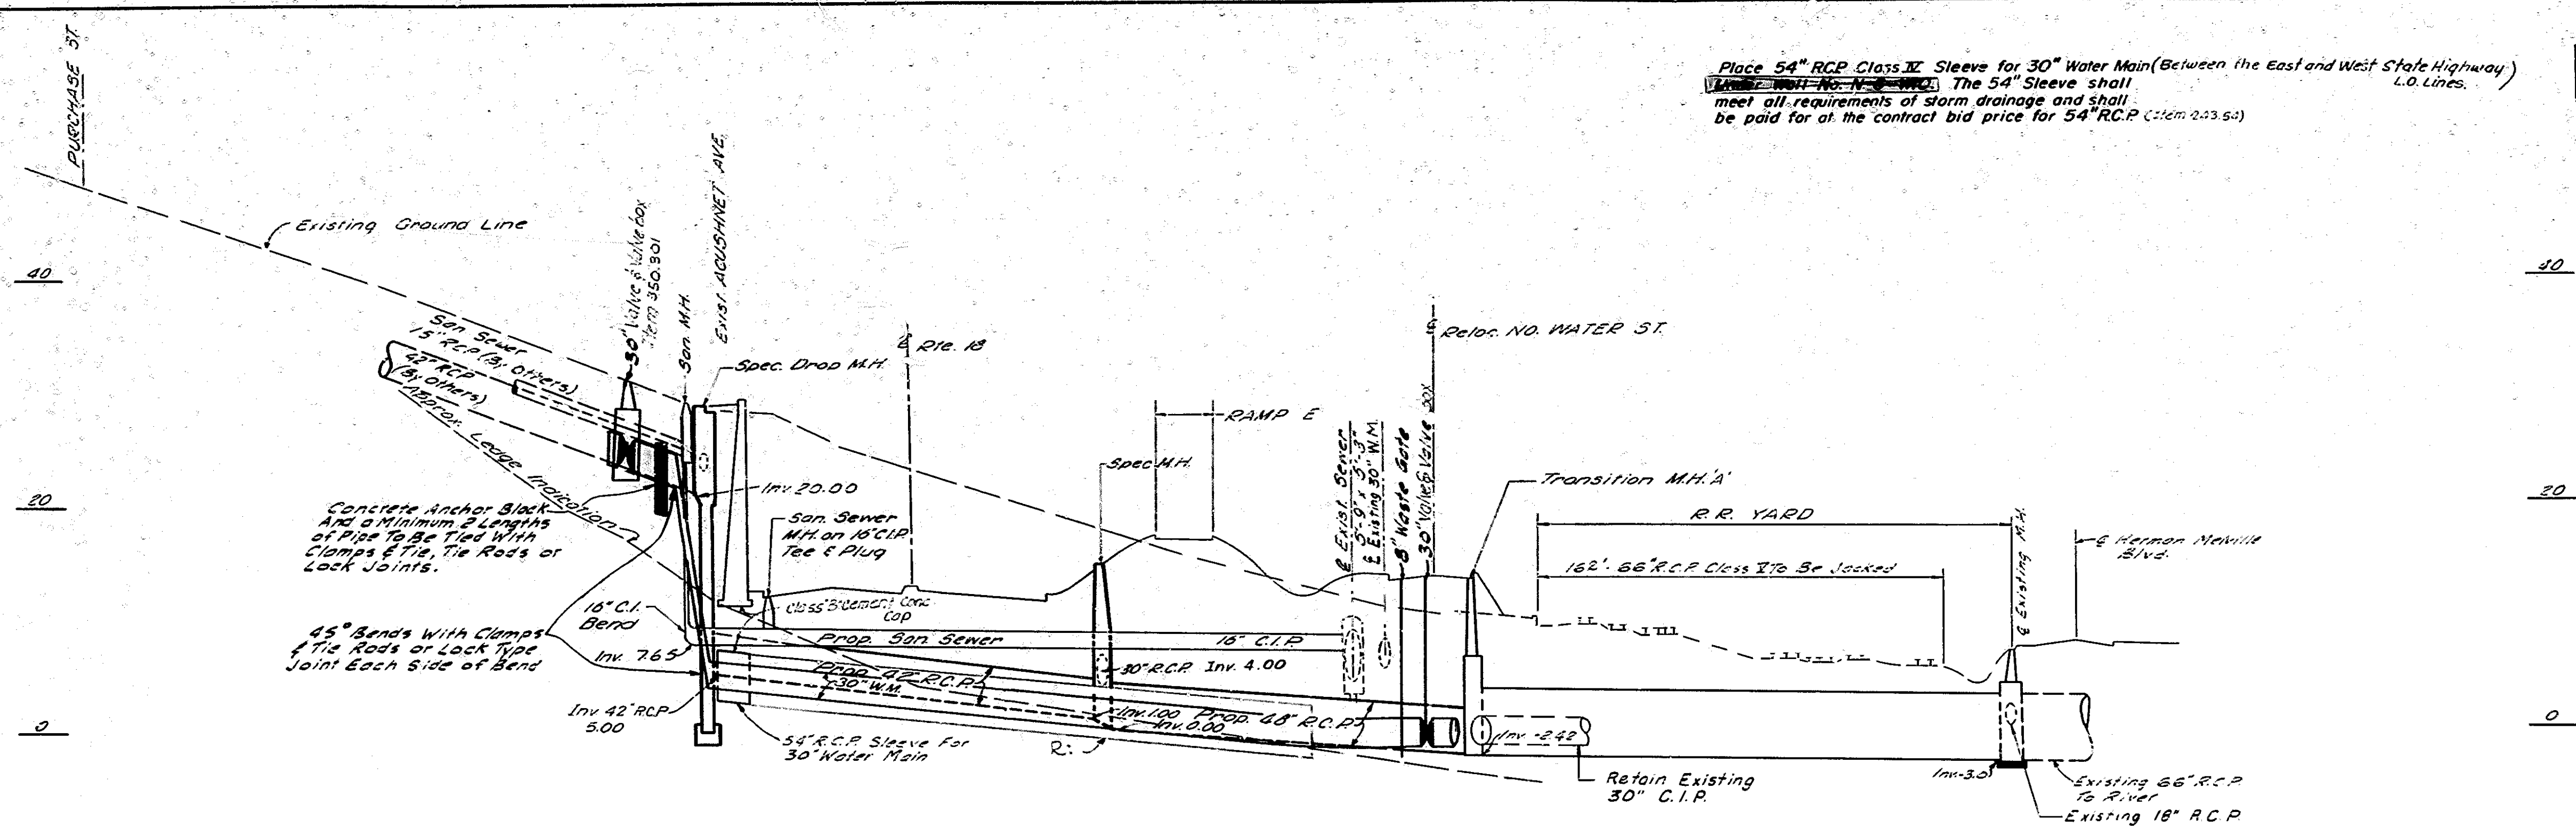


PROFILE - OUTFALL DRAIN AT MAXFIELD ST.

SCALE: 1" = 40' HORIZ.
1" = 8' VERT.

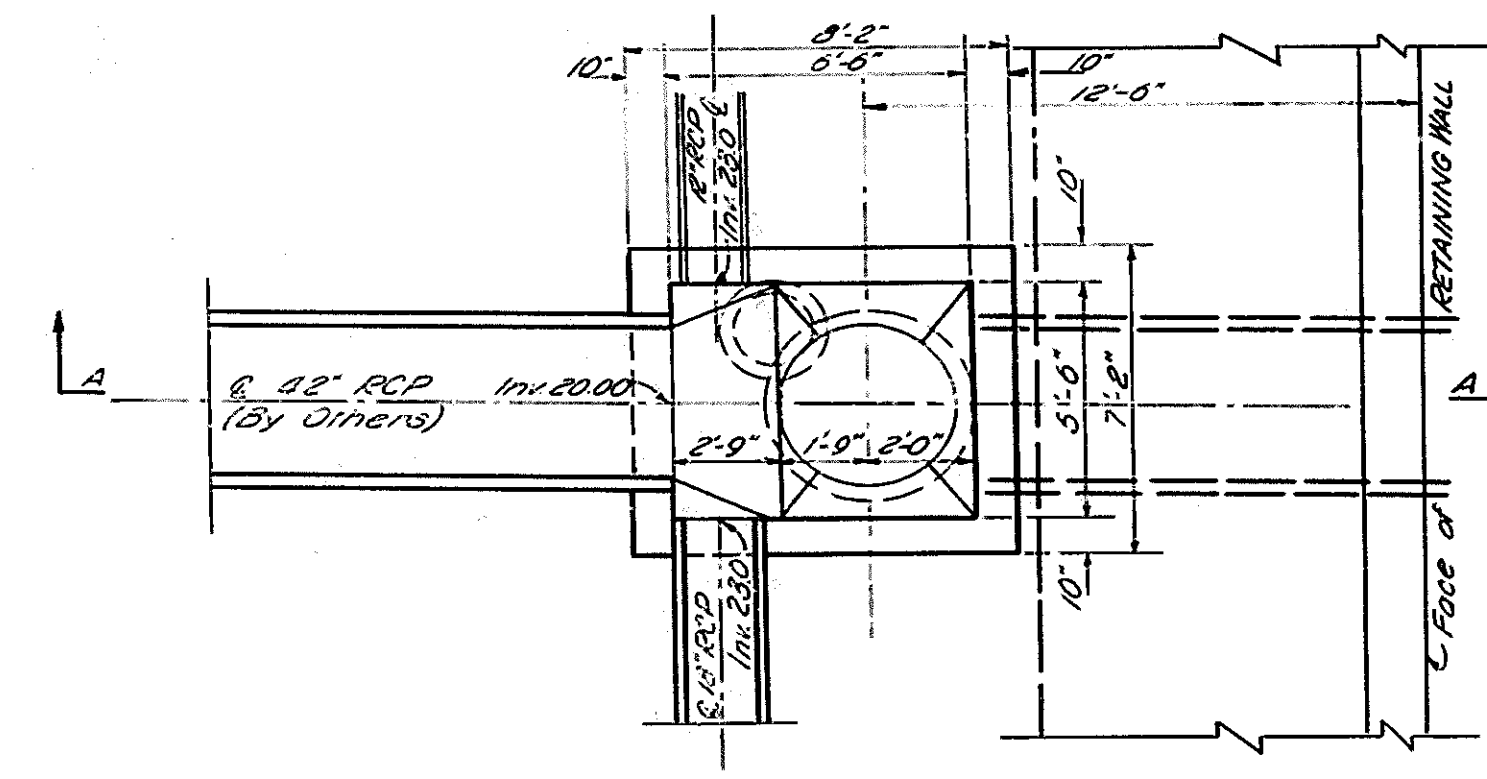


PLAN OF SPECIAL DROP MANHOLE

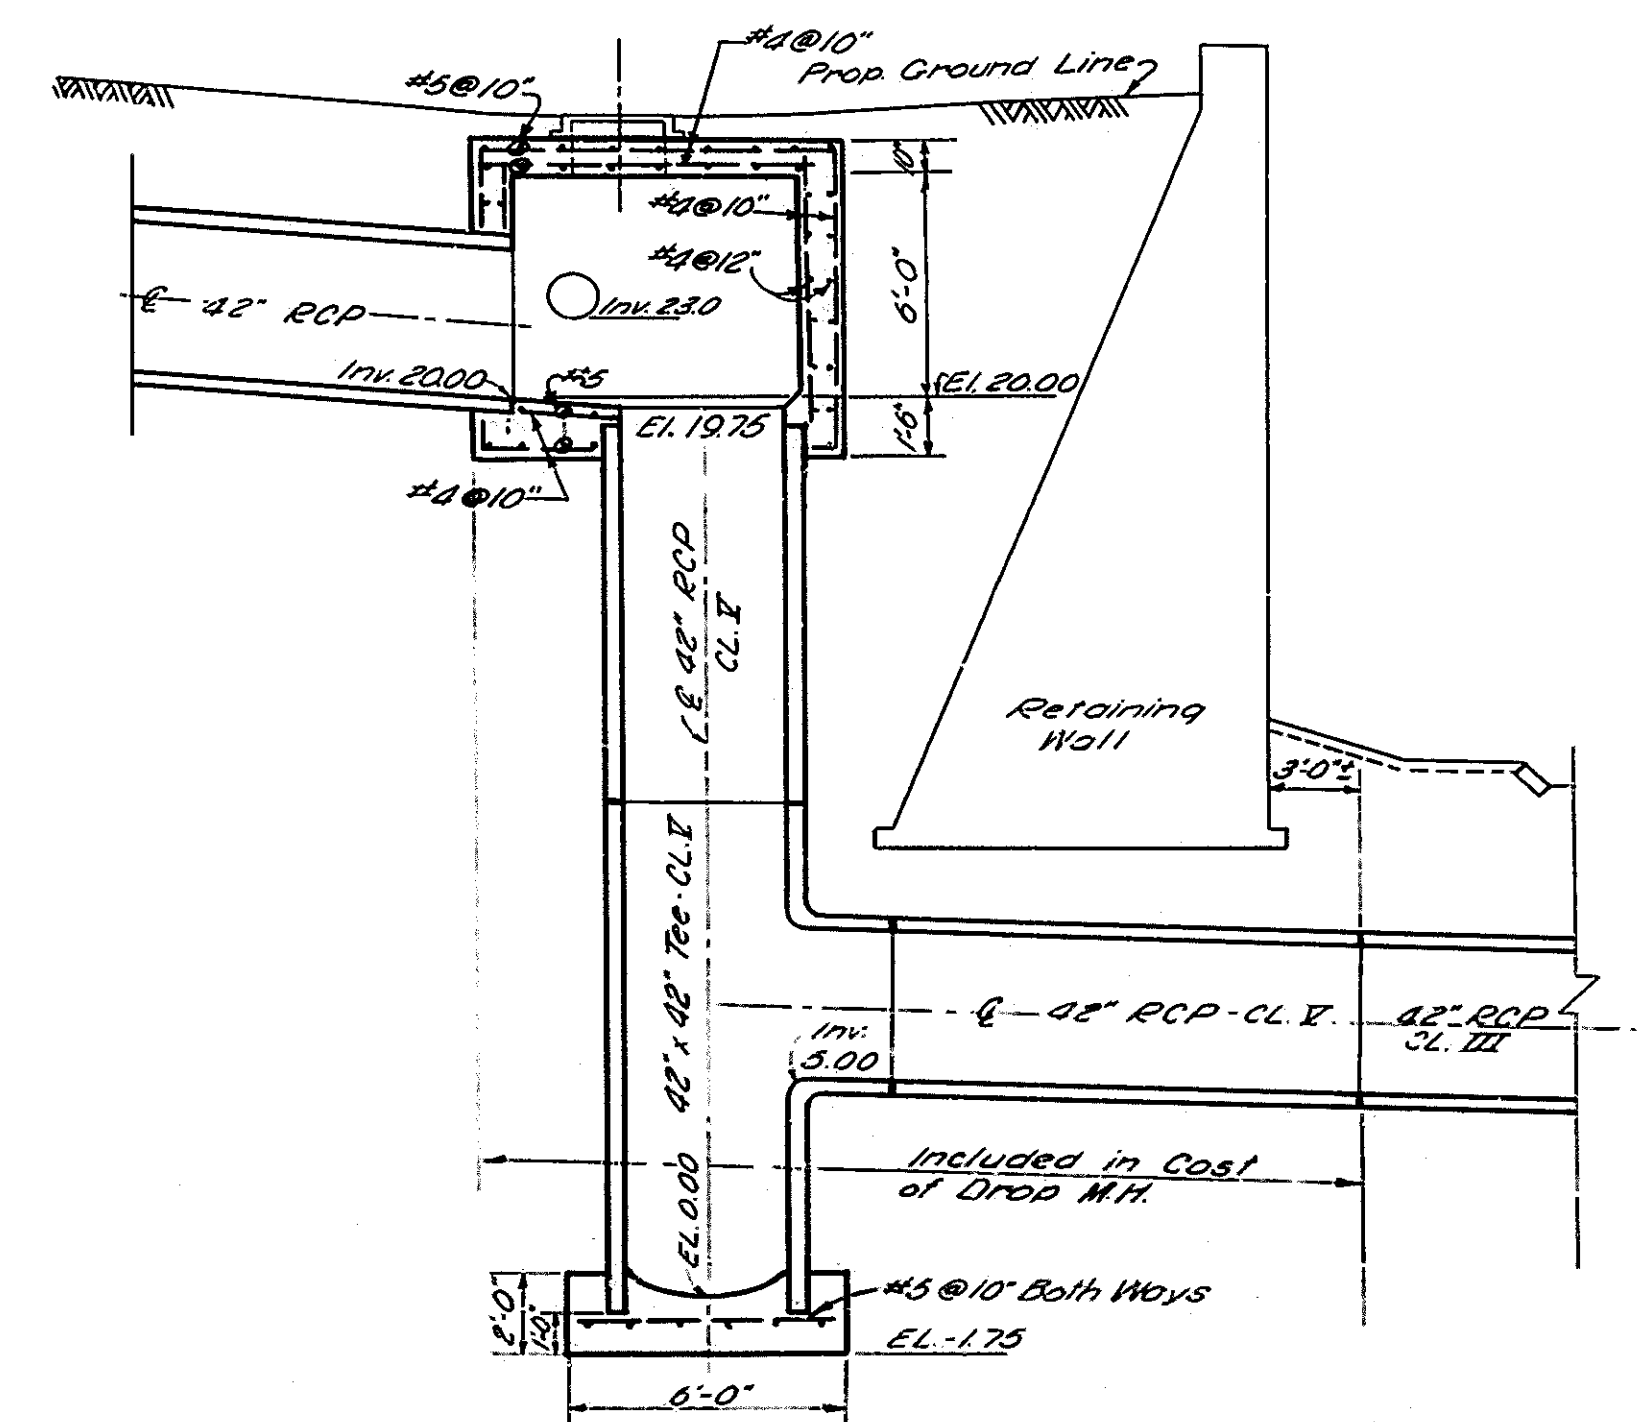


SECTION A-A

NOTE:
Concrete Class 'A'
Standard M.H. Cover & Frame
Dia 30"


SCALE: 1/4" = 1'-0"

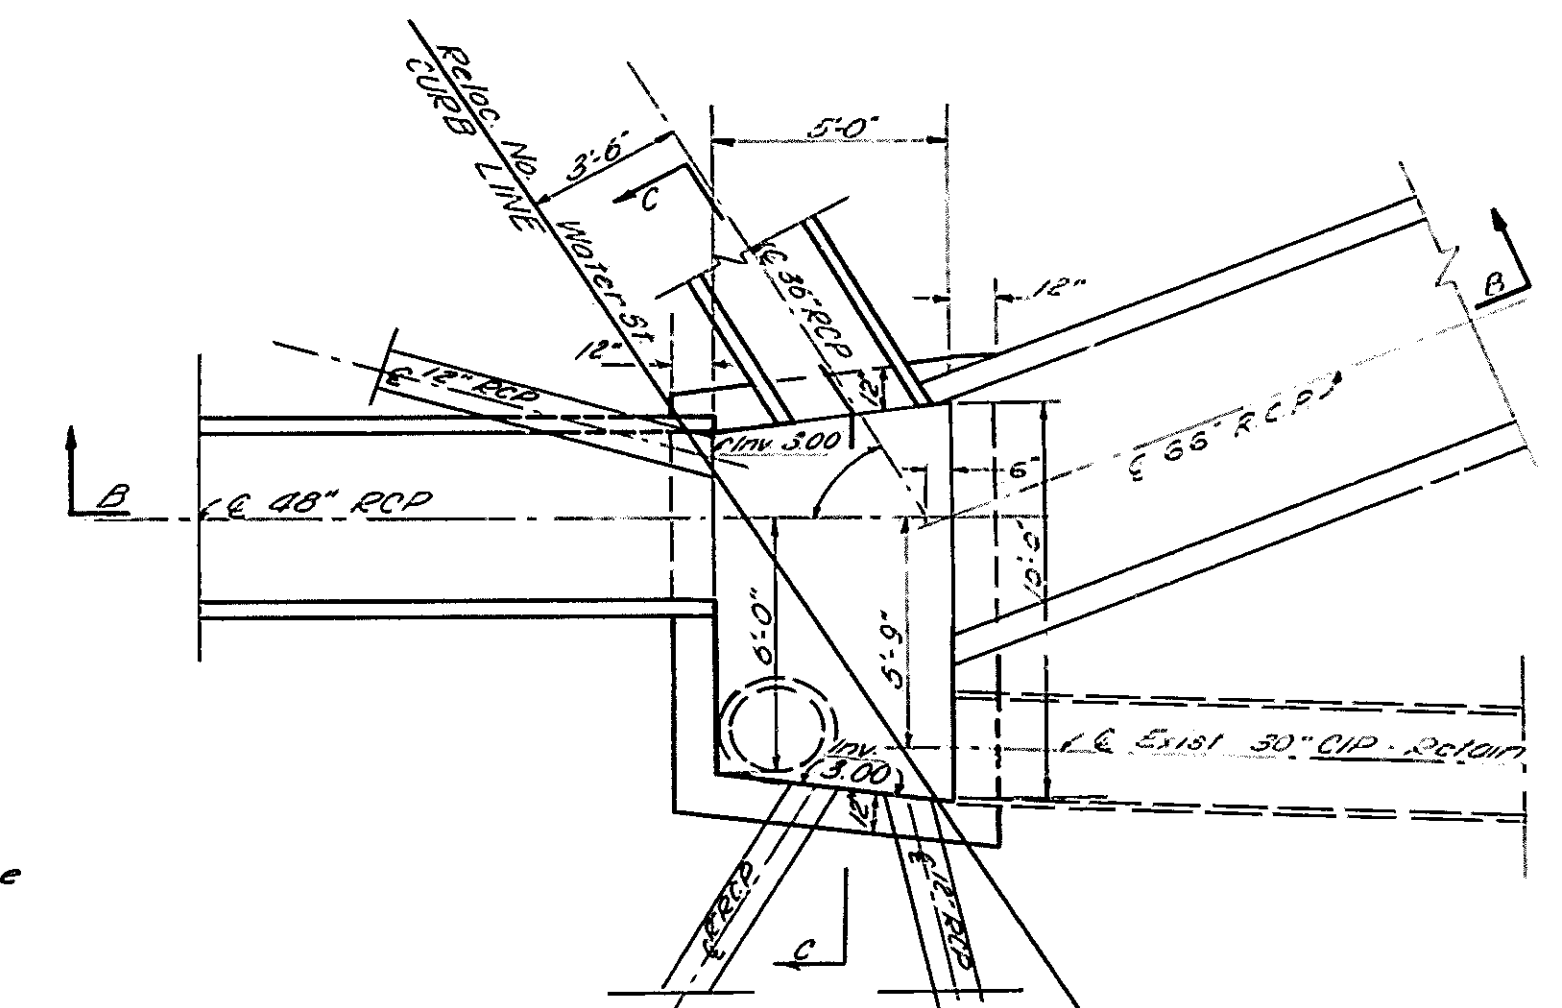

PLAN OF TRANSITION MANHOLE 'A'

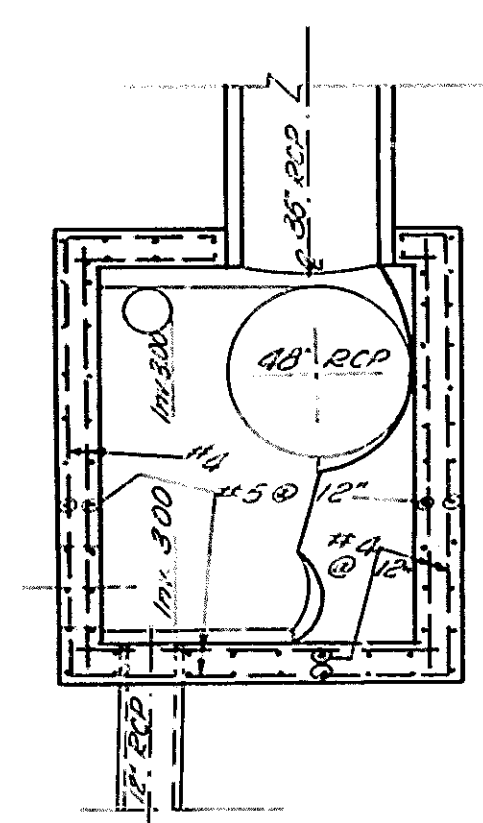

SECTION C-C

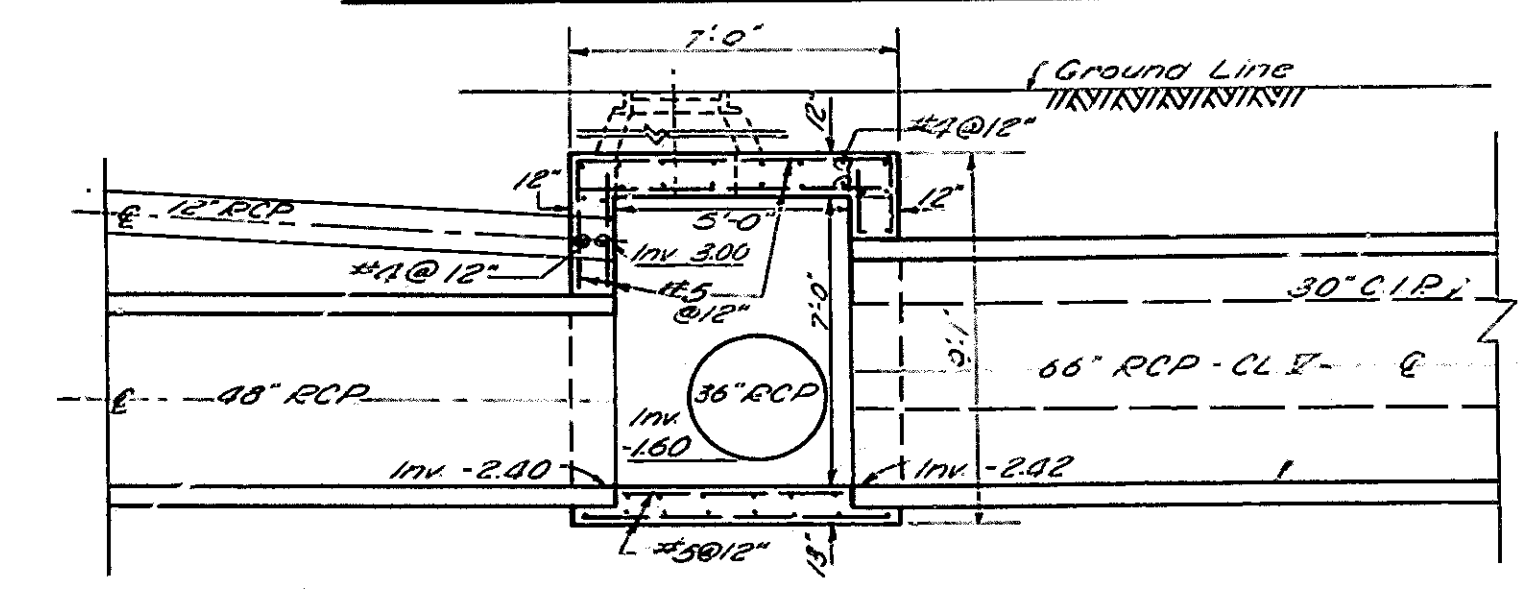

SECTION B-B

