
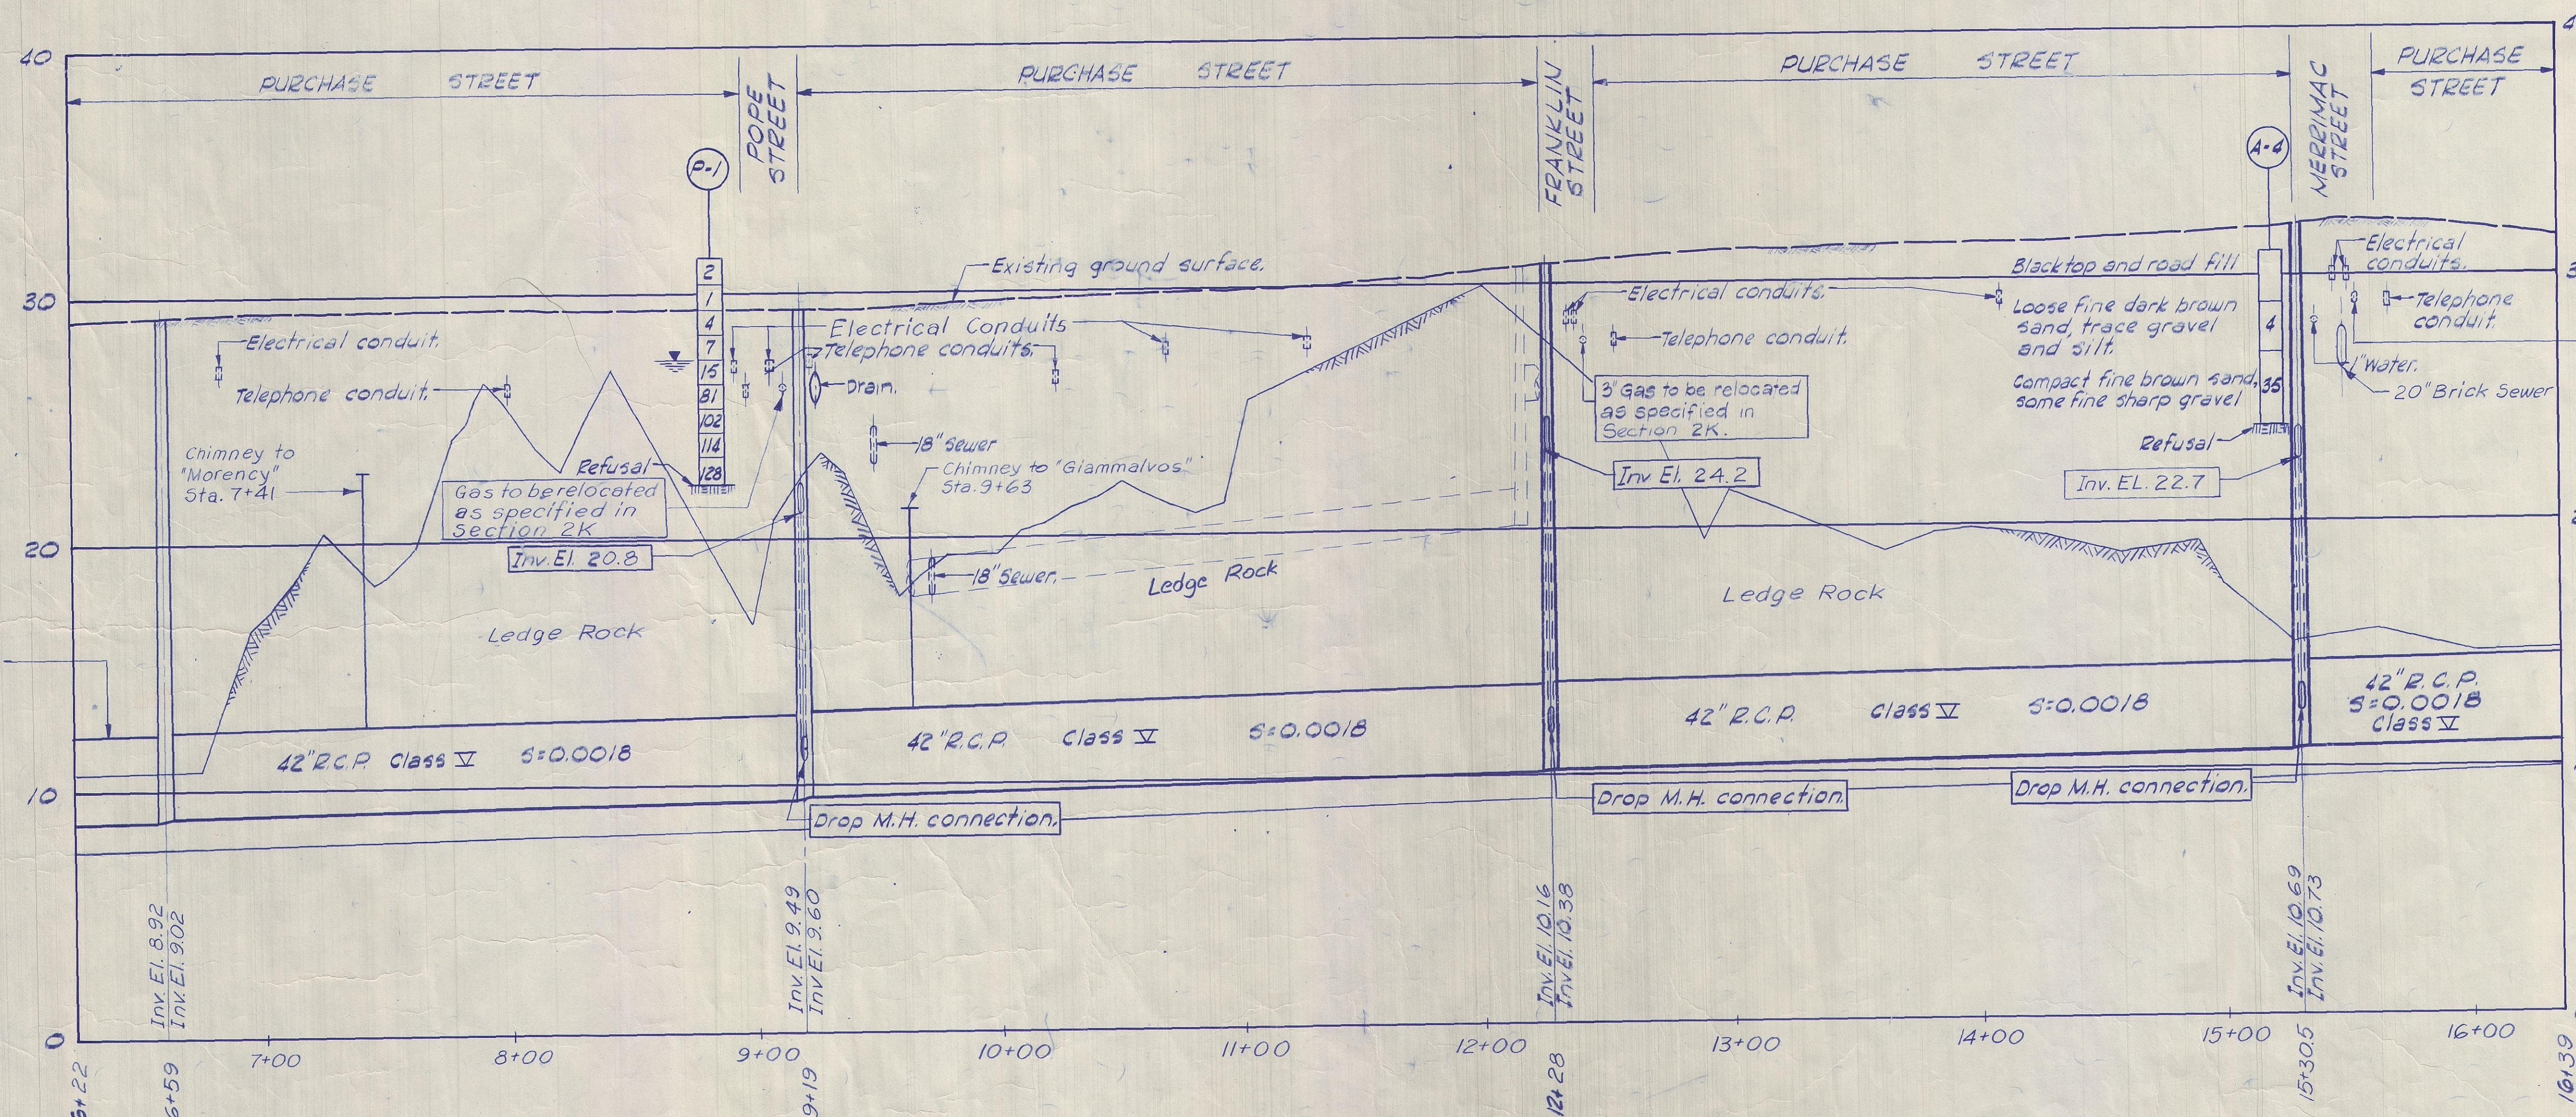


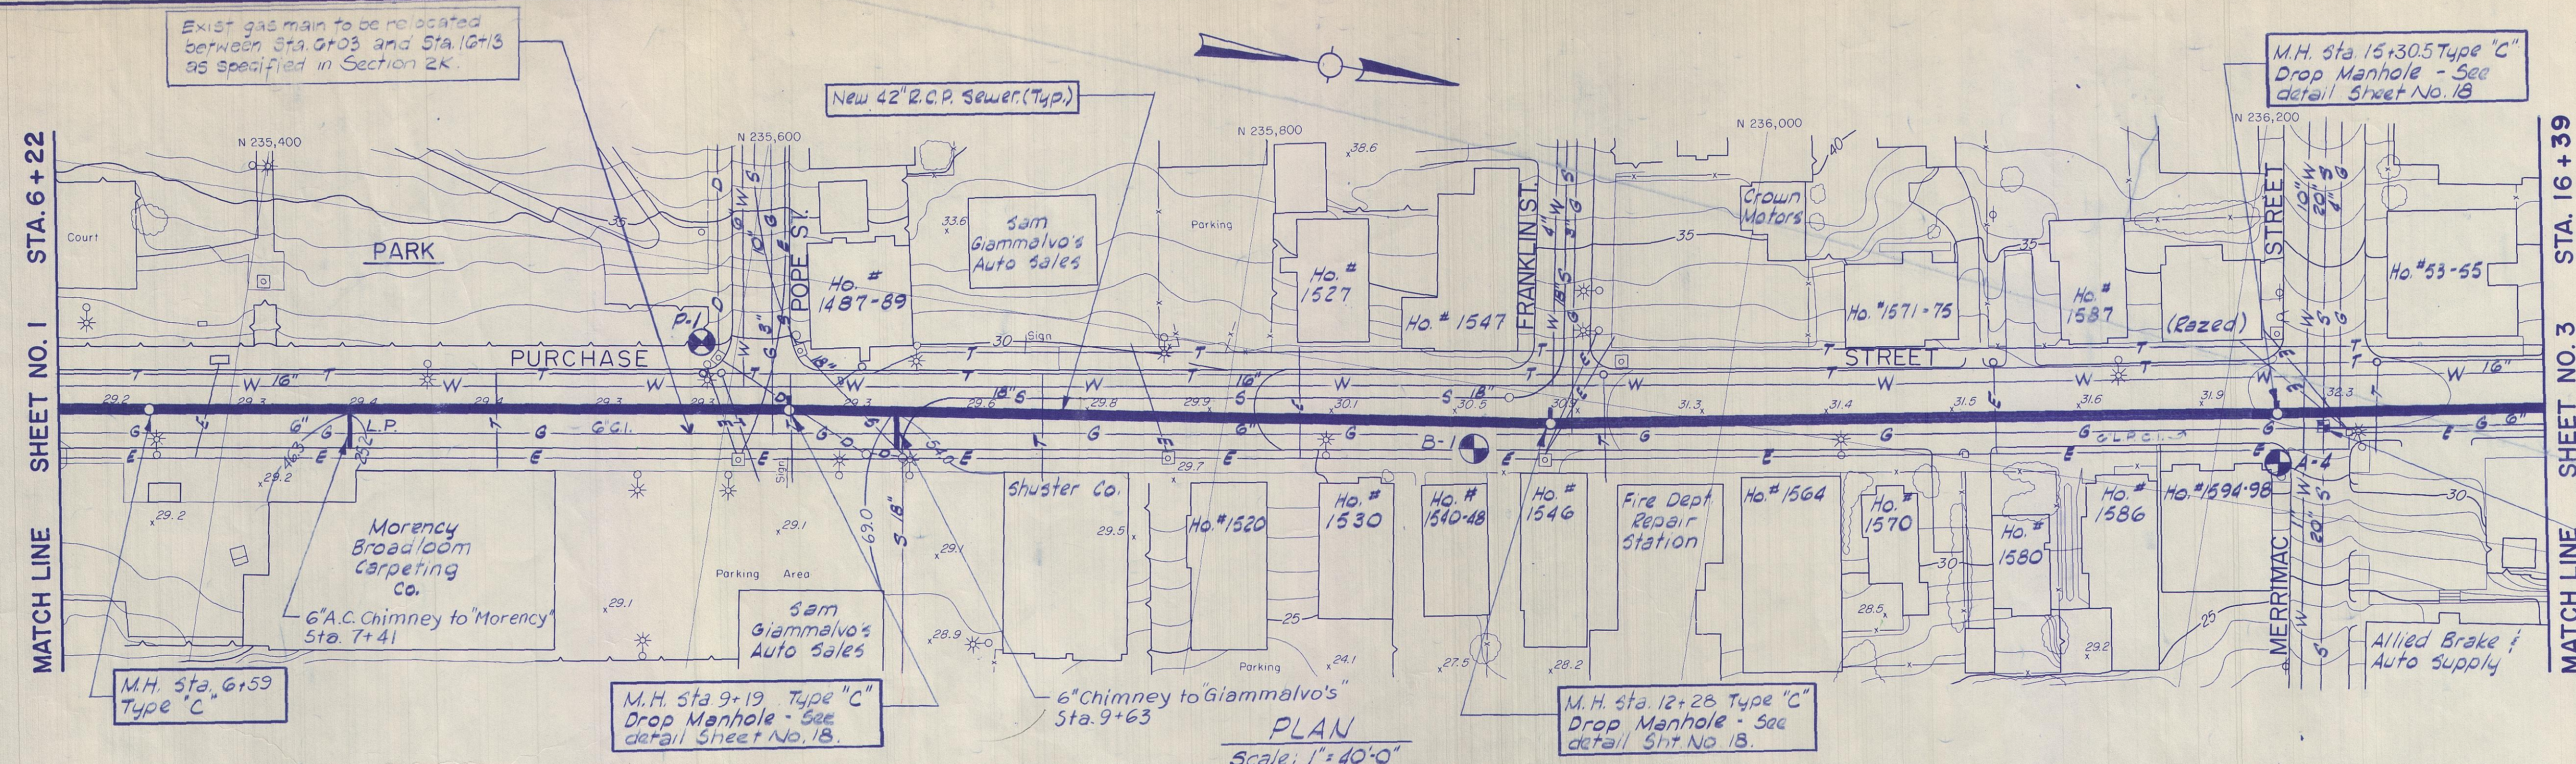

Approved by:	Date	Name
Structural		
Electrical		
HVAC		
Project Engineer	7/12/78	J. J. J.
Project Manager	7/12/78	J. J. J.

TELEDYNE GEOTRONICS
725 E. 3RD. ST.
LONG BEACH, CALIF. 90802

PROFILE
Scale: Hor. 1"=40'-0"
Vert. 1"=4'-0"

RECORD DRAWING



Date	10/9/13	W.J.G.	AS - BUILTS
Ch'kd.			
Designed by:	PBD		
Drawn by:	CHE		
Checked by:	PBD		
Approved by:	RCM		
Date:	December, 1978		
Scale:	As Noted		

CITY OF NEW BEDFORD, MASSACHUSETTS
DEPARTMENT OF PUBLIC WORKS
WATER POLLUTION ABATEMENT FACILITIES
NORTH END INTERCEPTOR RELIEF SEWER
PROJECT NO. B-21
STA. 6+22 TO STA. 16+39

CAMP DRESSER & McKEE Inc.
Consulting Engineers
Boston, Mass.

SHEET NO.
2
309-26282