



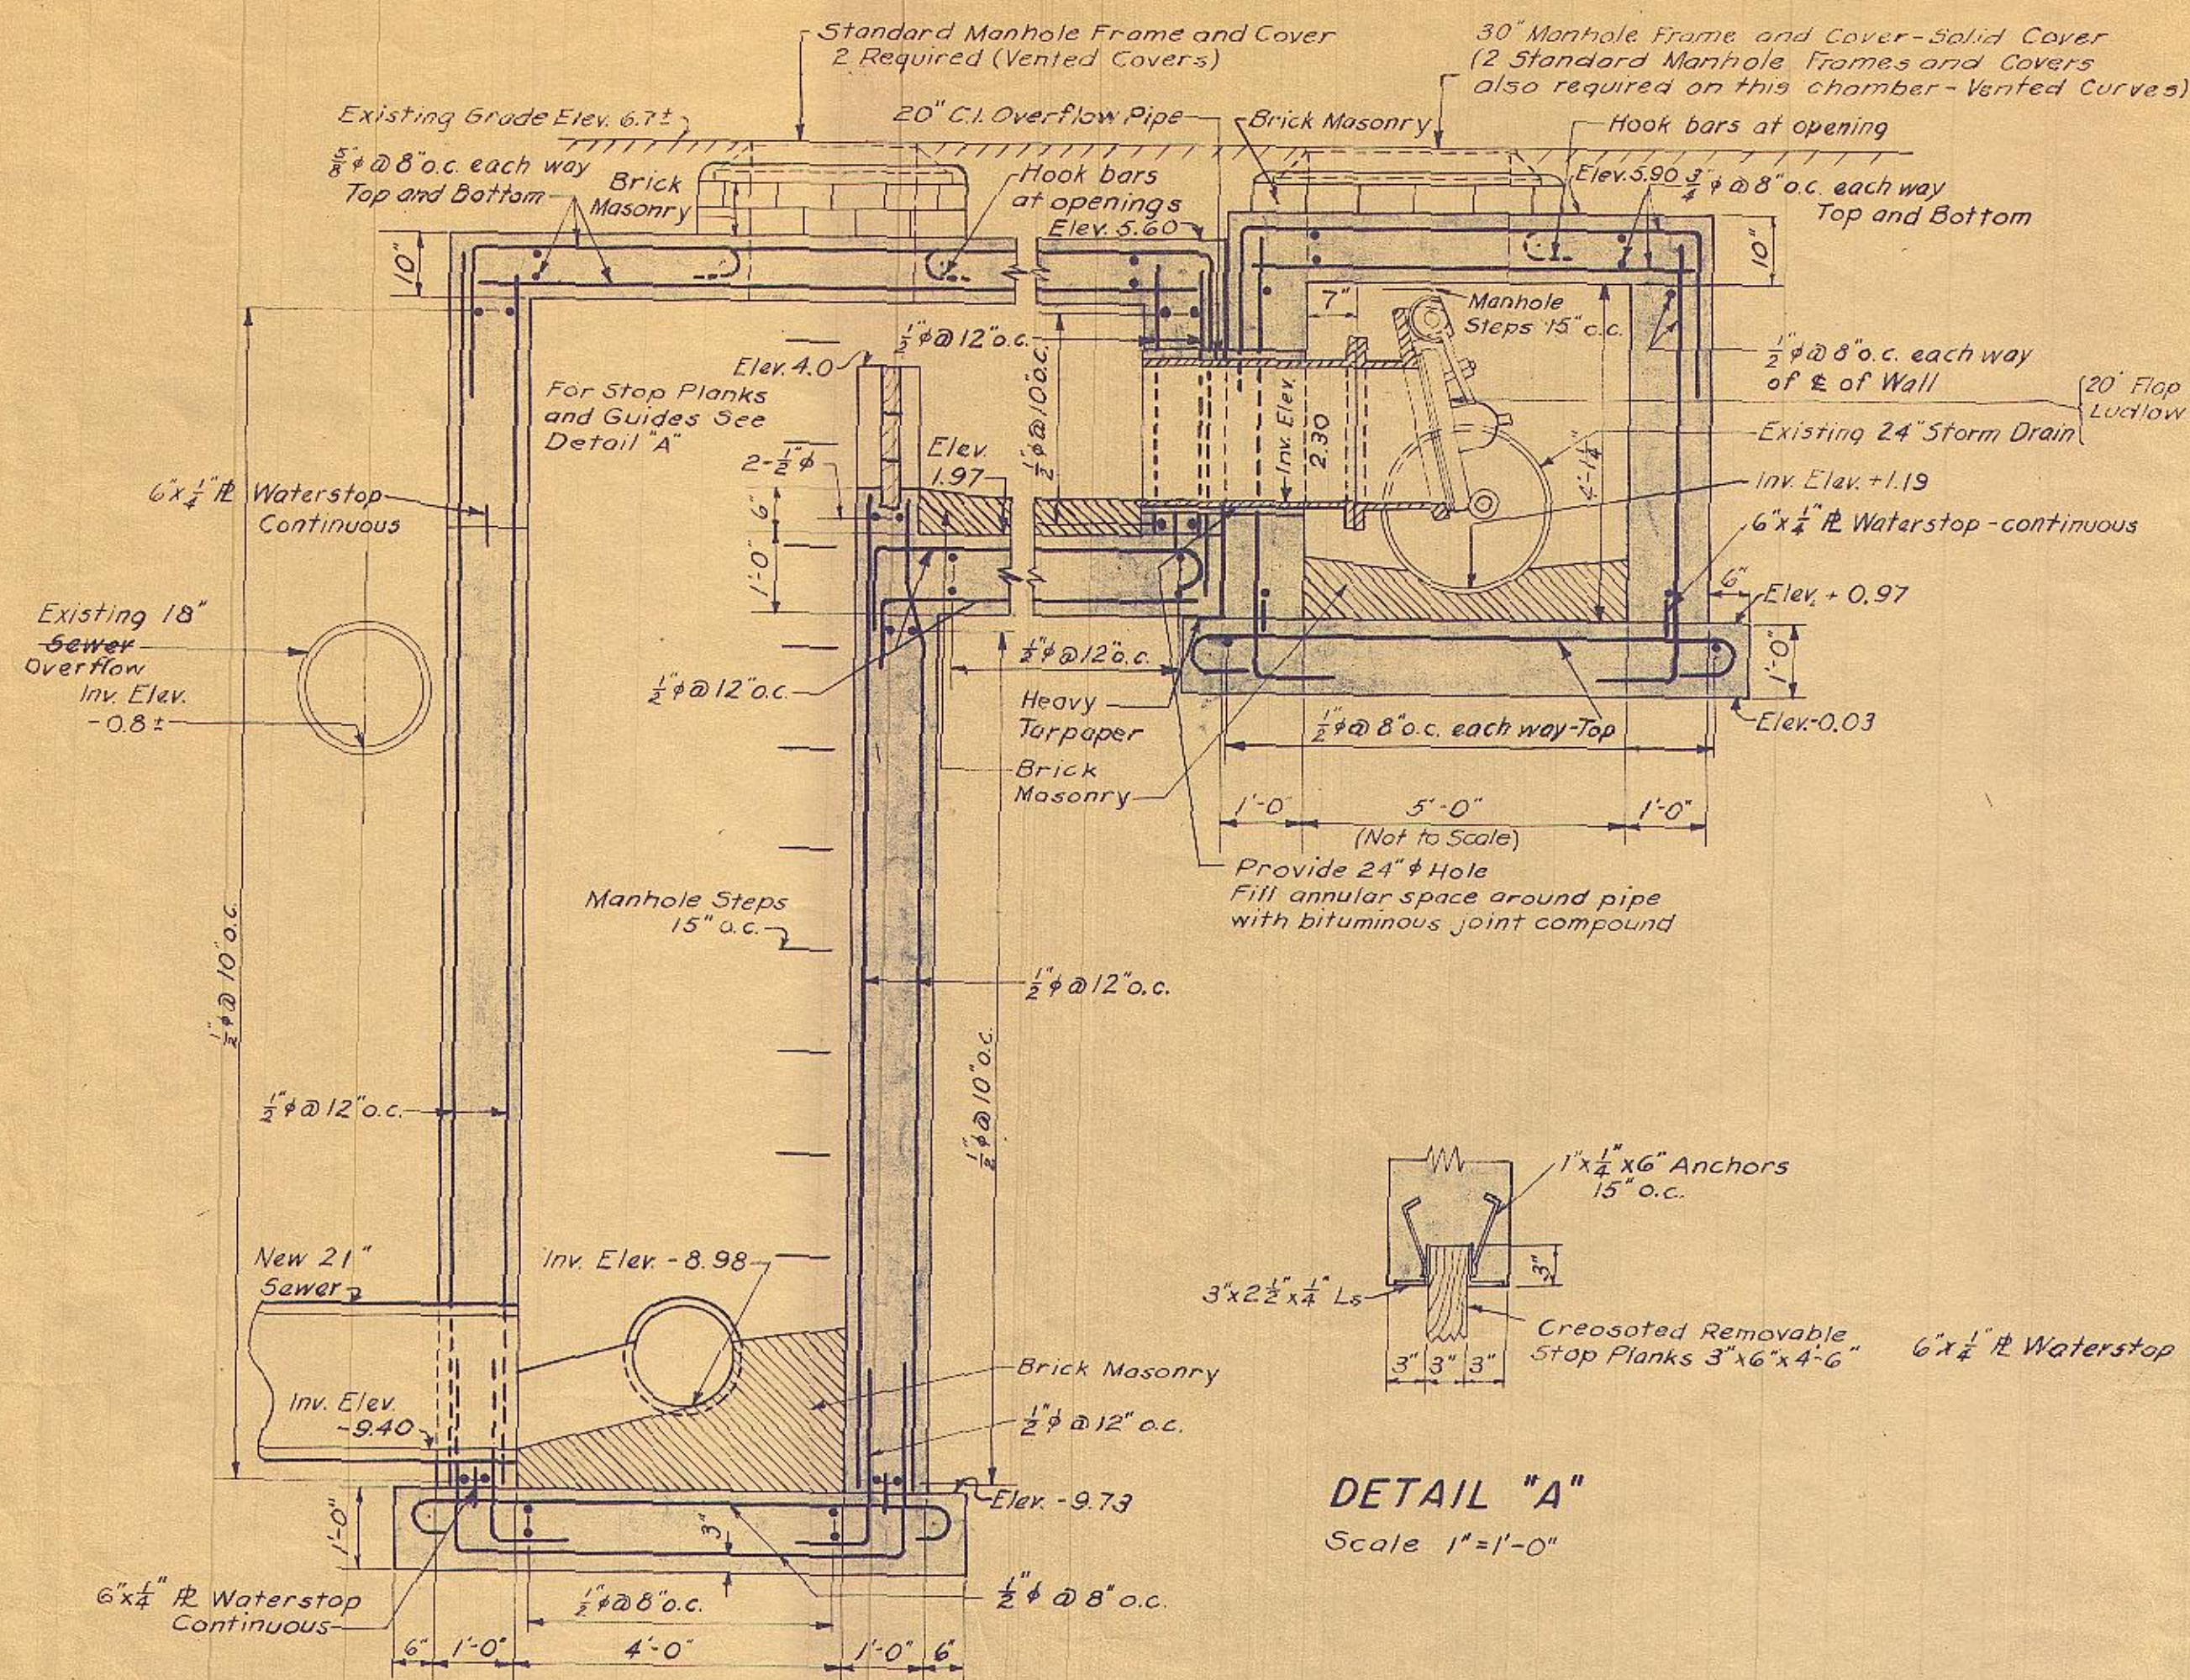

DETAIL "A"
Scale 1"=1'-0"

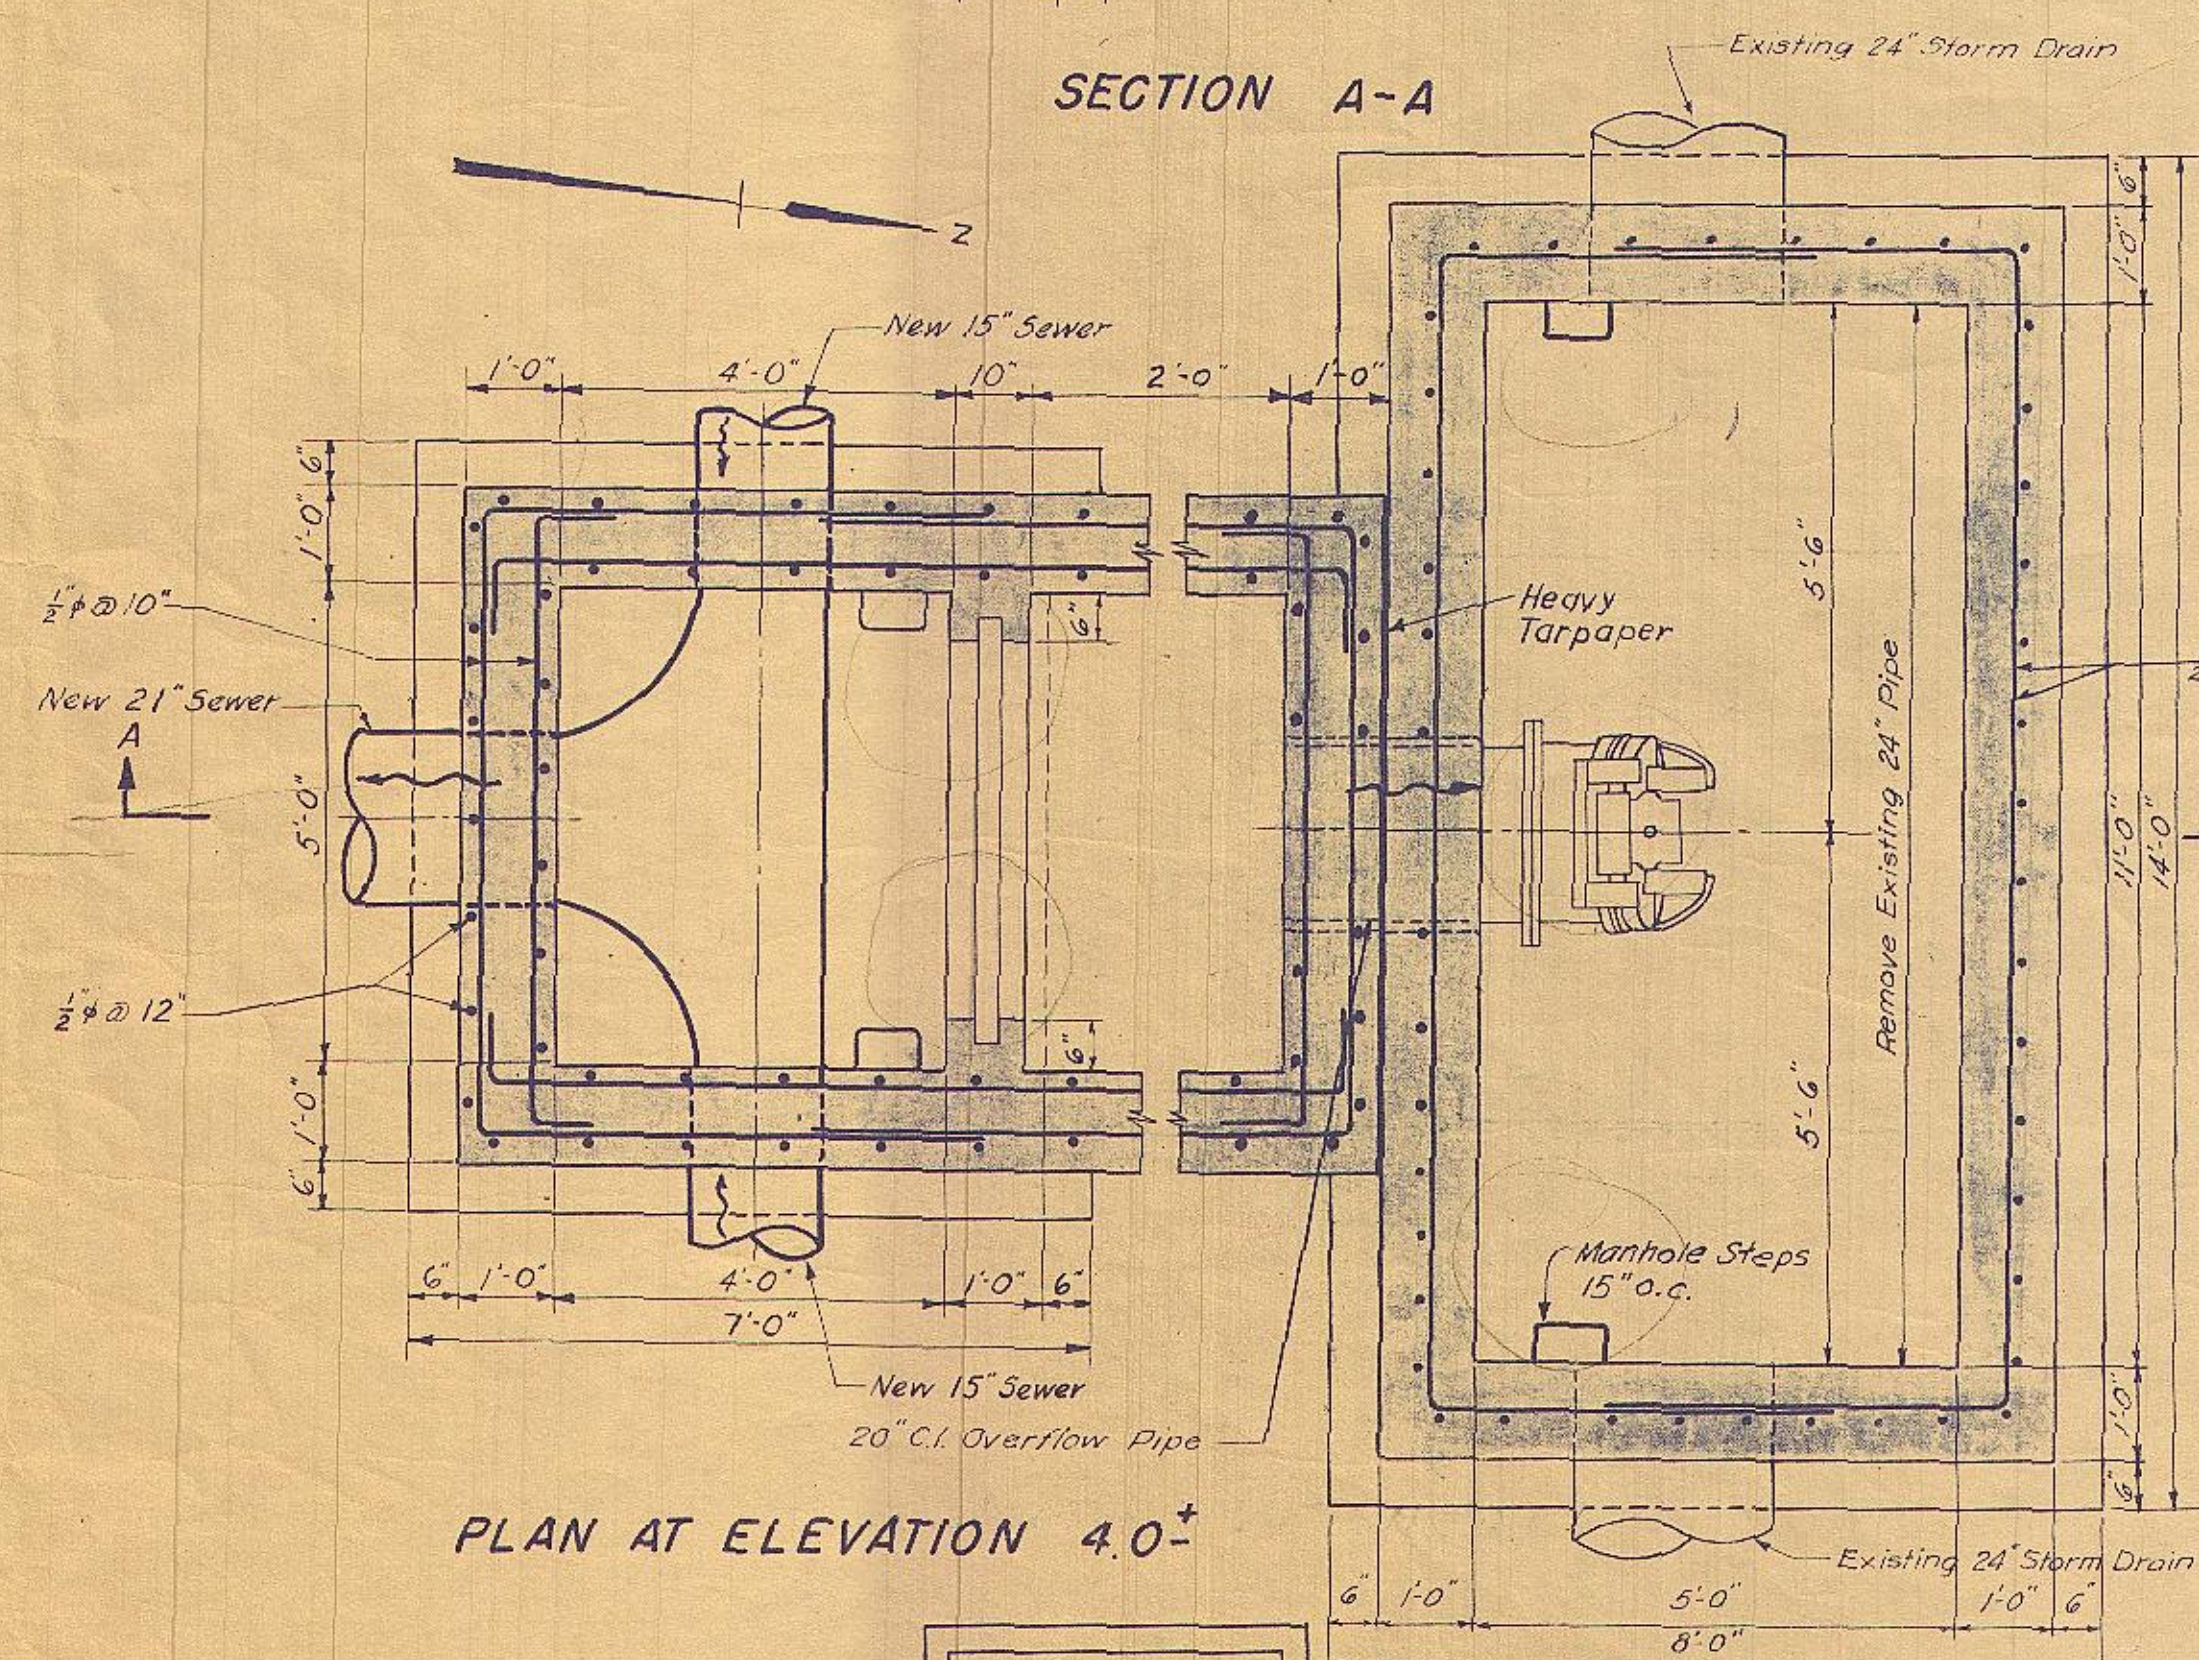


PLAN AT ELEVATION 4.0'


PLAN AT ELEVATION 59'
SHOWING LOCATION OF MANHOLE OPENINGS
Scale: 1/4"=1'-0"

MANHOLE "A"


REV NO.	DATE	DESCRIPTION	MADE BY	CHK BY	APPD BY
1	2-1-51	Revised as built	D.H.O.	G.C.C.	H
REVISIONS					

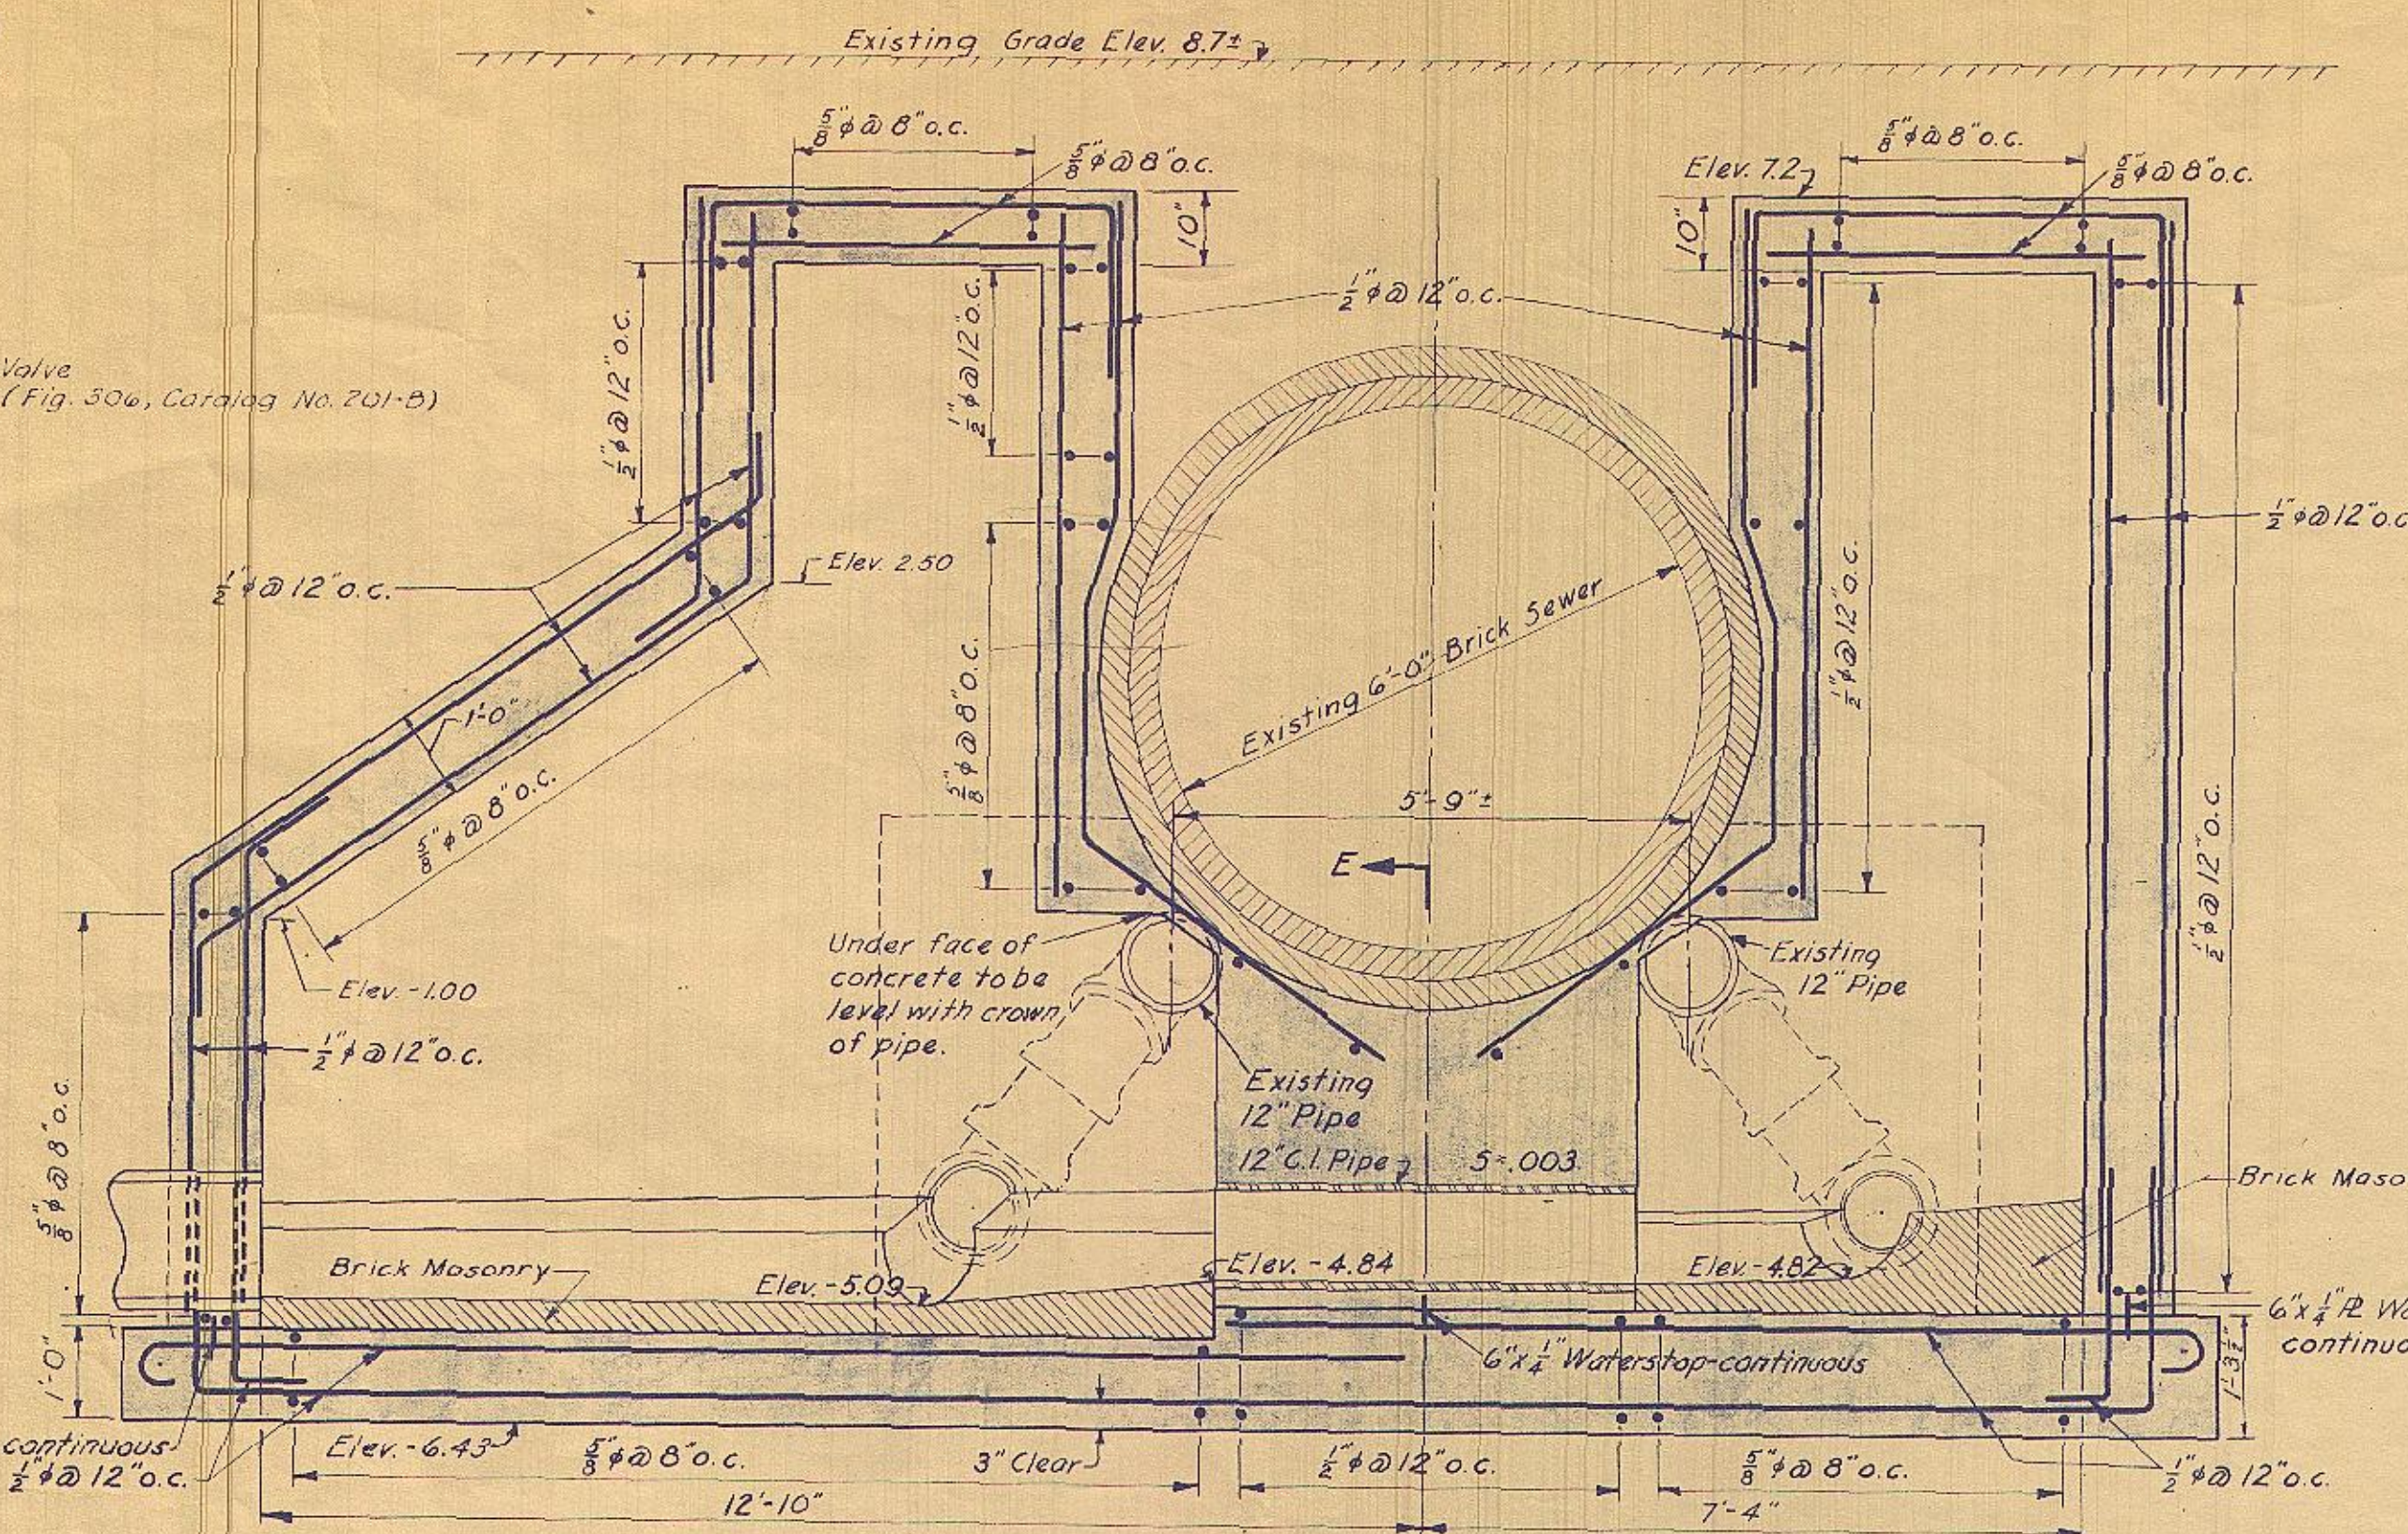

SECTION B-B

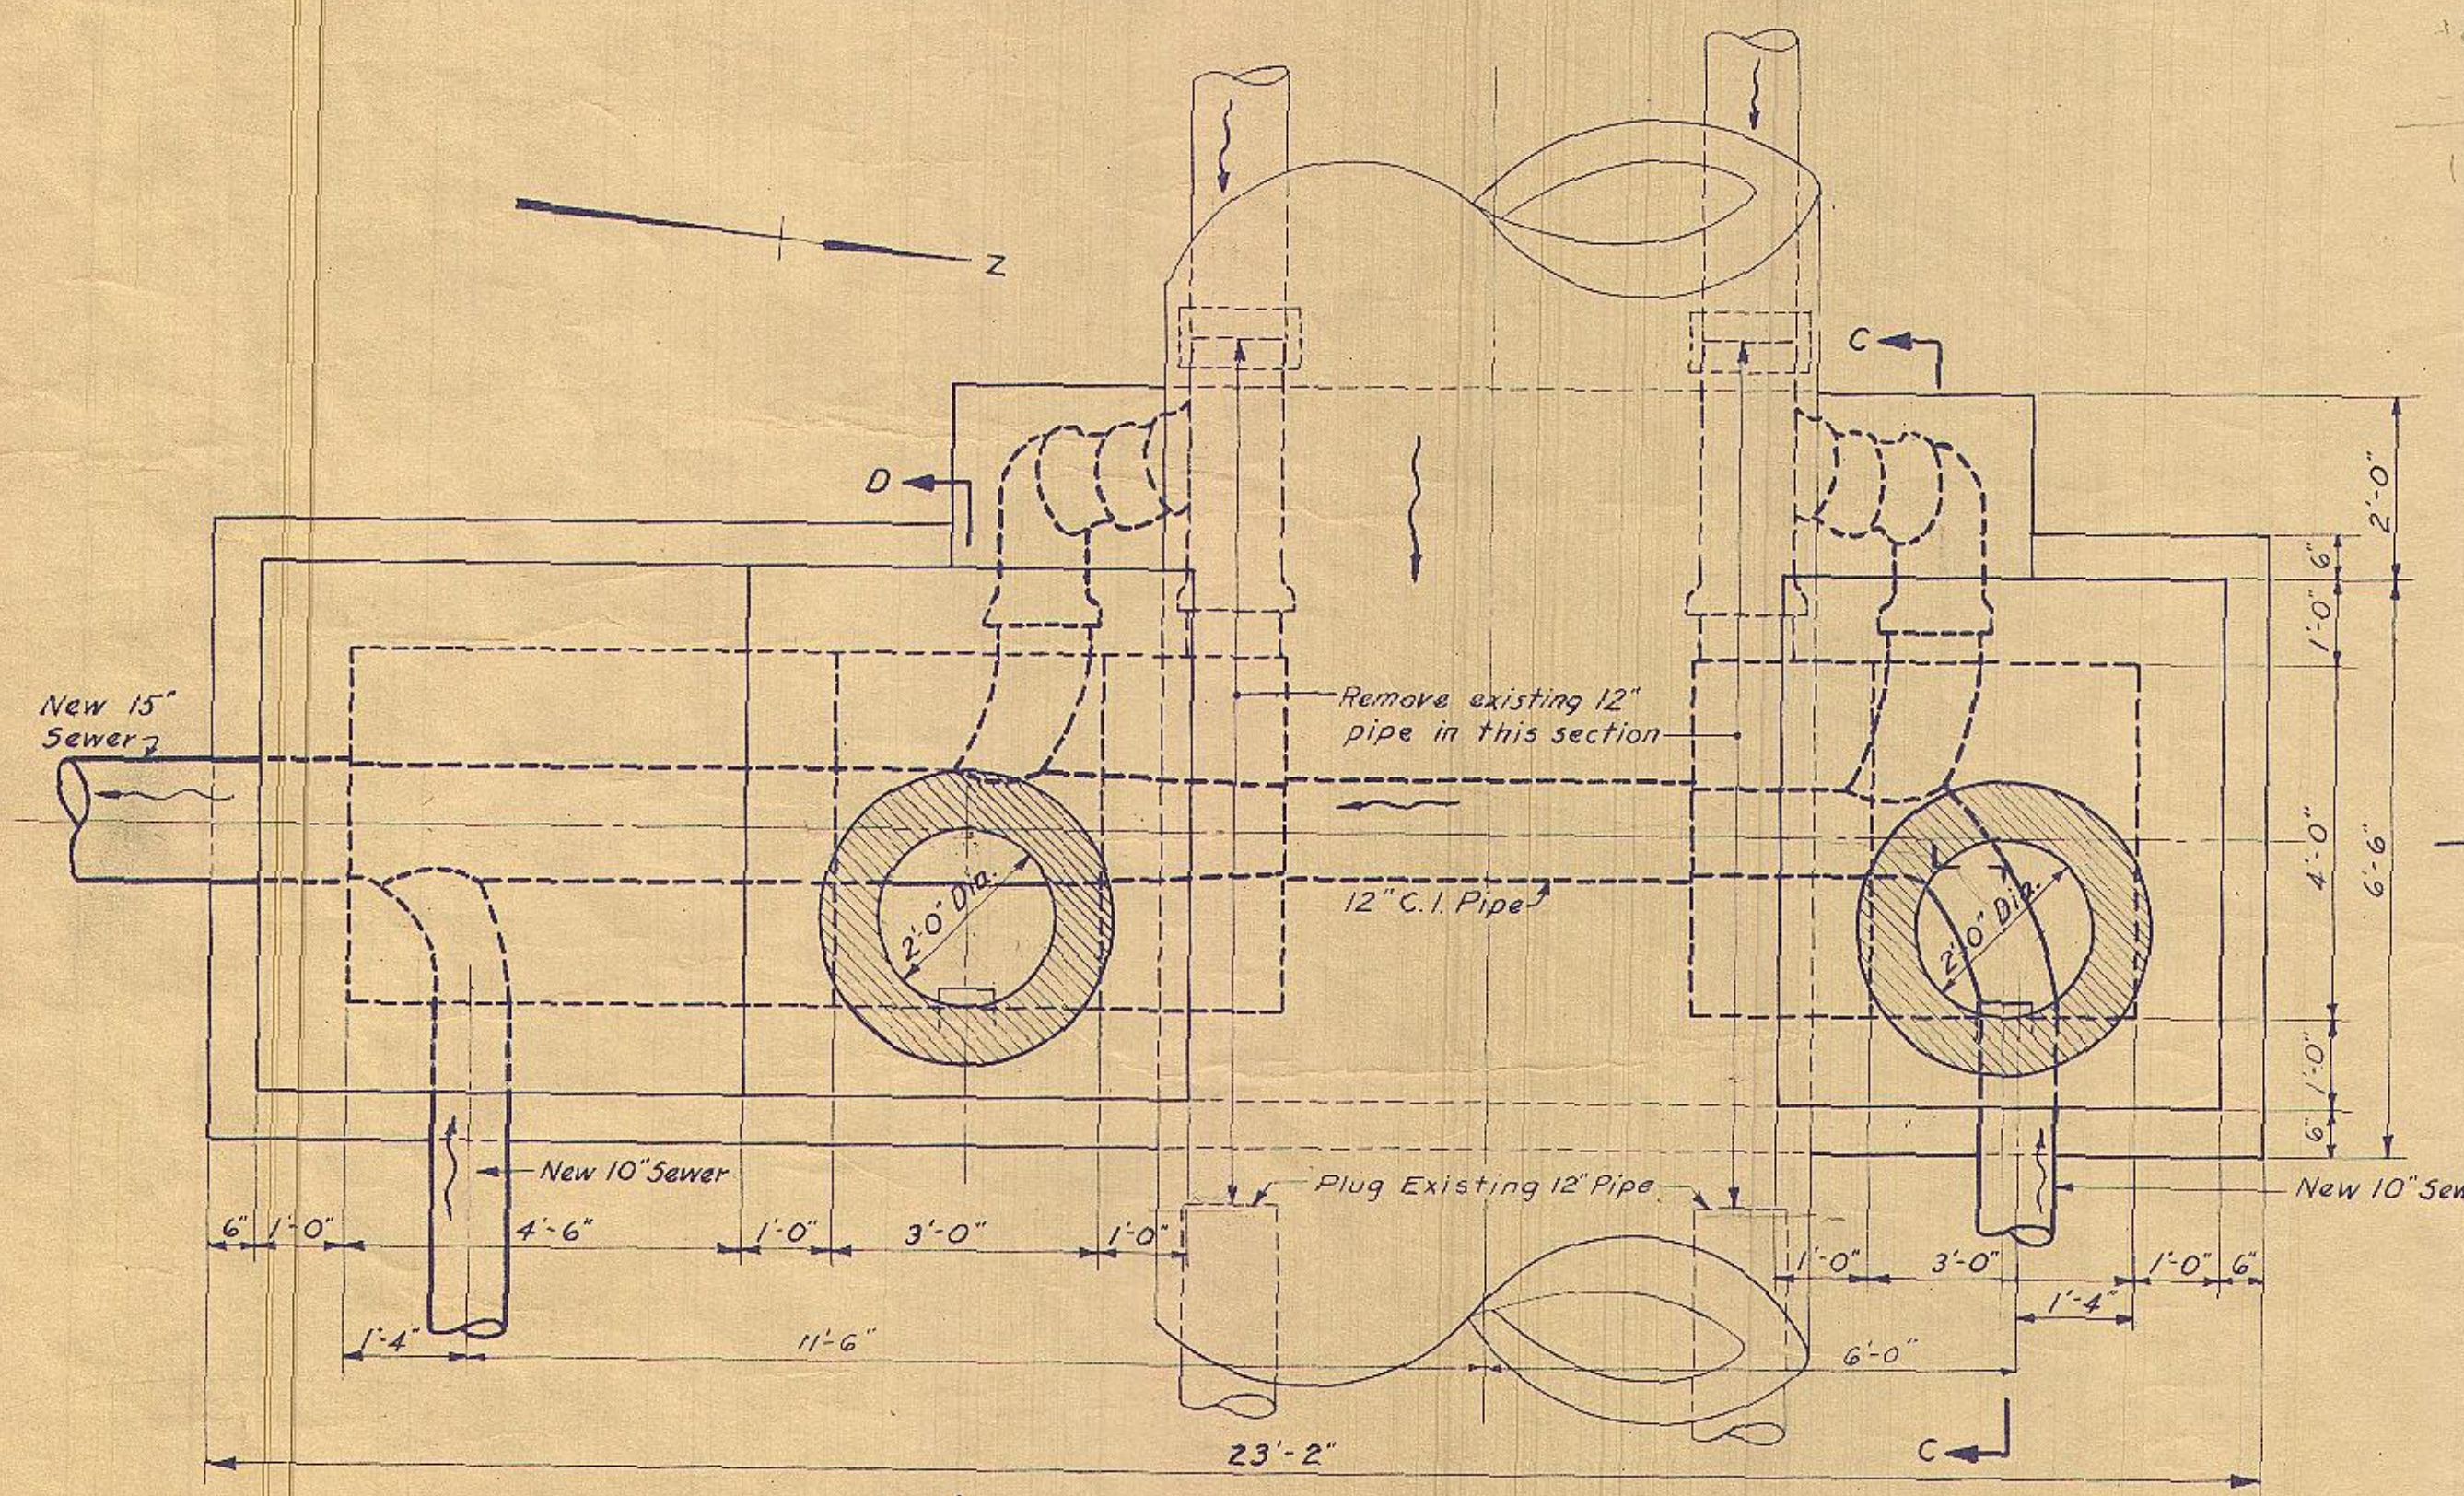


PLAN AT ELEVATION 7.2'

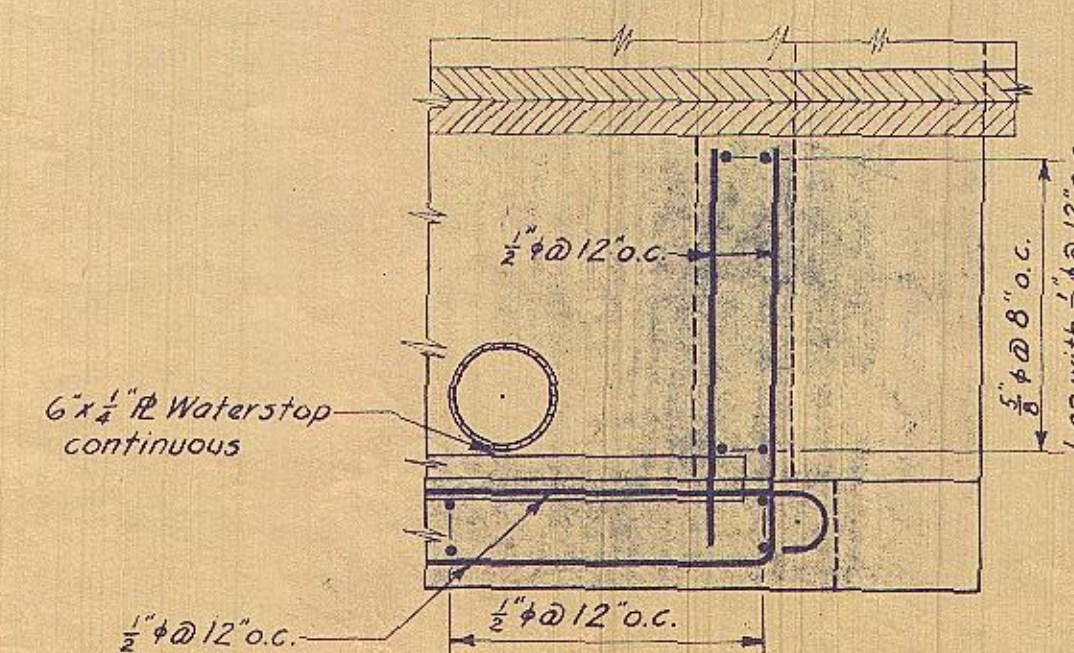


SECTION E-E
Scale 1/4"=1'-0"

MANHOLE "B"

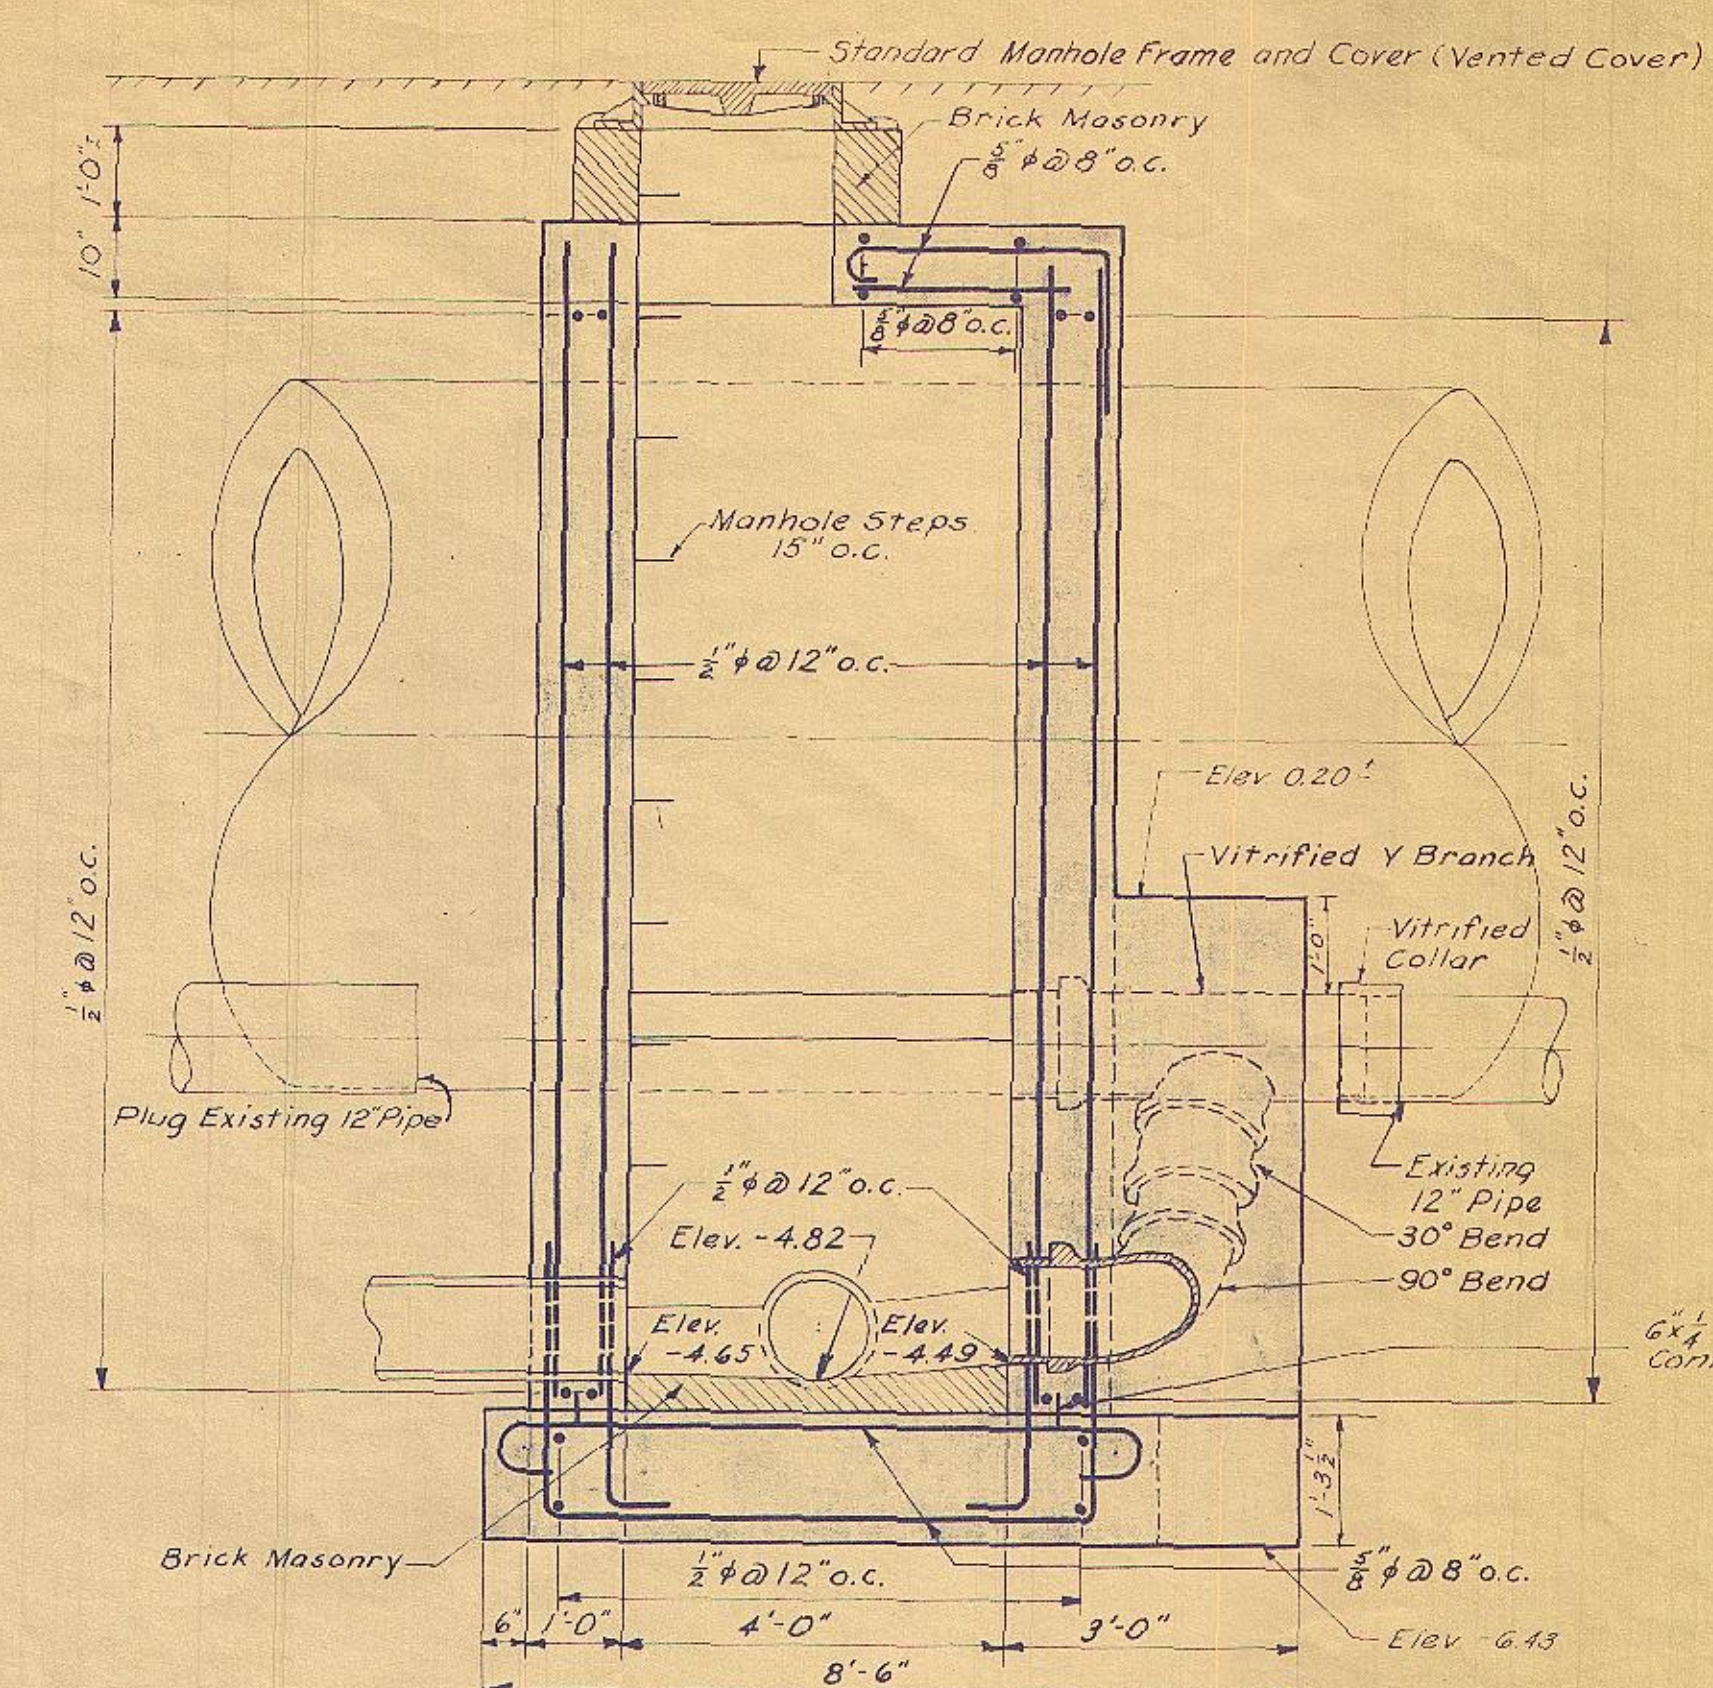

SECTION C-C

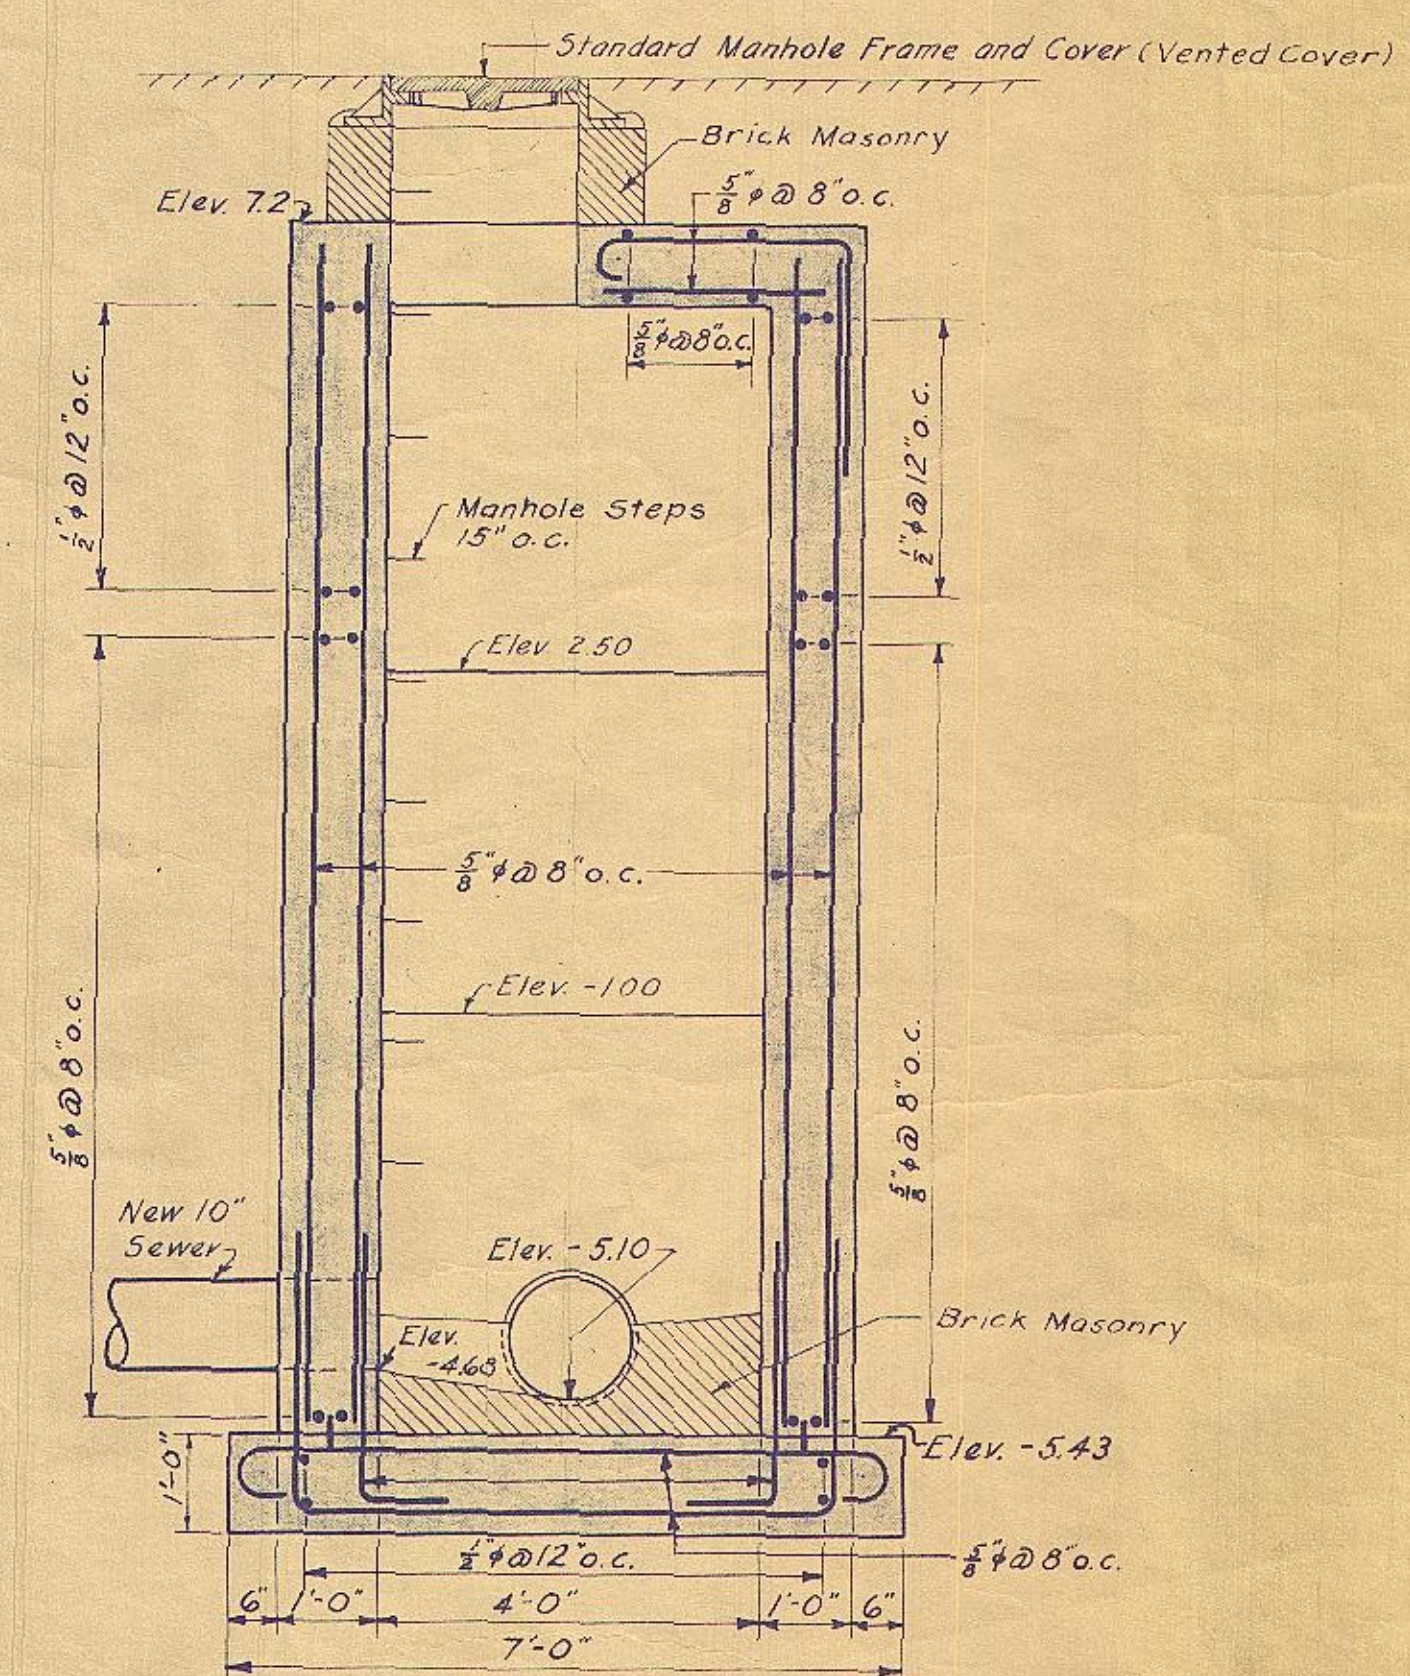

SECTION D-D

RECORD PLAN

NEW BEDFORD, MASSACHUSETTS
DEPARTMENT OF PUBLIC WORKS

ADDITIONS TO INTERCEPTING SEWER SYSTEM

SPECIAL MANHOLES STRUCTURES "A" & "B"

SCALE 1/2" = 1'-0" EXCEPT AS NOTED	OCT. 1948
FAY, SPOFFORD & THORNDIKE, ENGINEERS, BOSTON, MASS.	
DESIGNS RCF PRJ TR. AJV	FILE NO.
DR. PRJ. AJV	CHK. C.D.S.
APPROVED R.W. Horne	PLAN NO. 37

CONTRACT DRAWING

SHEET NO. 30 OF 33

FOR DETAILS, GENERAL NOTES AND LEGEND SEE SHEET NO. 29 AND SHEET NO. 33
FOR LOCATION OF MANHOLE "A" SEE SHEET NO. 18
FOR LOCATION OF MANHOLE "B" SEE SHEET NO. 19