



PROJECT MANAGER: _____ Date: _____
 PROJECT ENGINEER: _____ Date: _____
 PLUMBING: _____ Date: _____
 HVAC: _____ Date: _____
 INSTRUMENTATION: _____ Date: _____
 ELECTRICAL: _____ Date: _____
 STRUCTURAL: _____ Date: _____
 ARCHITECTURAL: _____ Date: _____

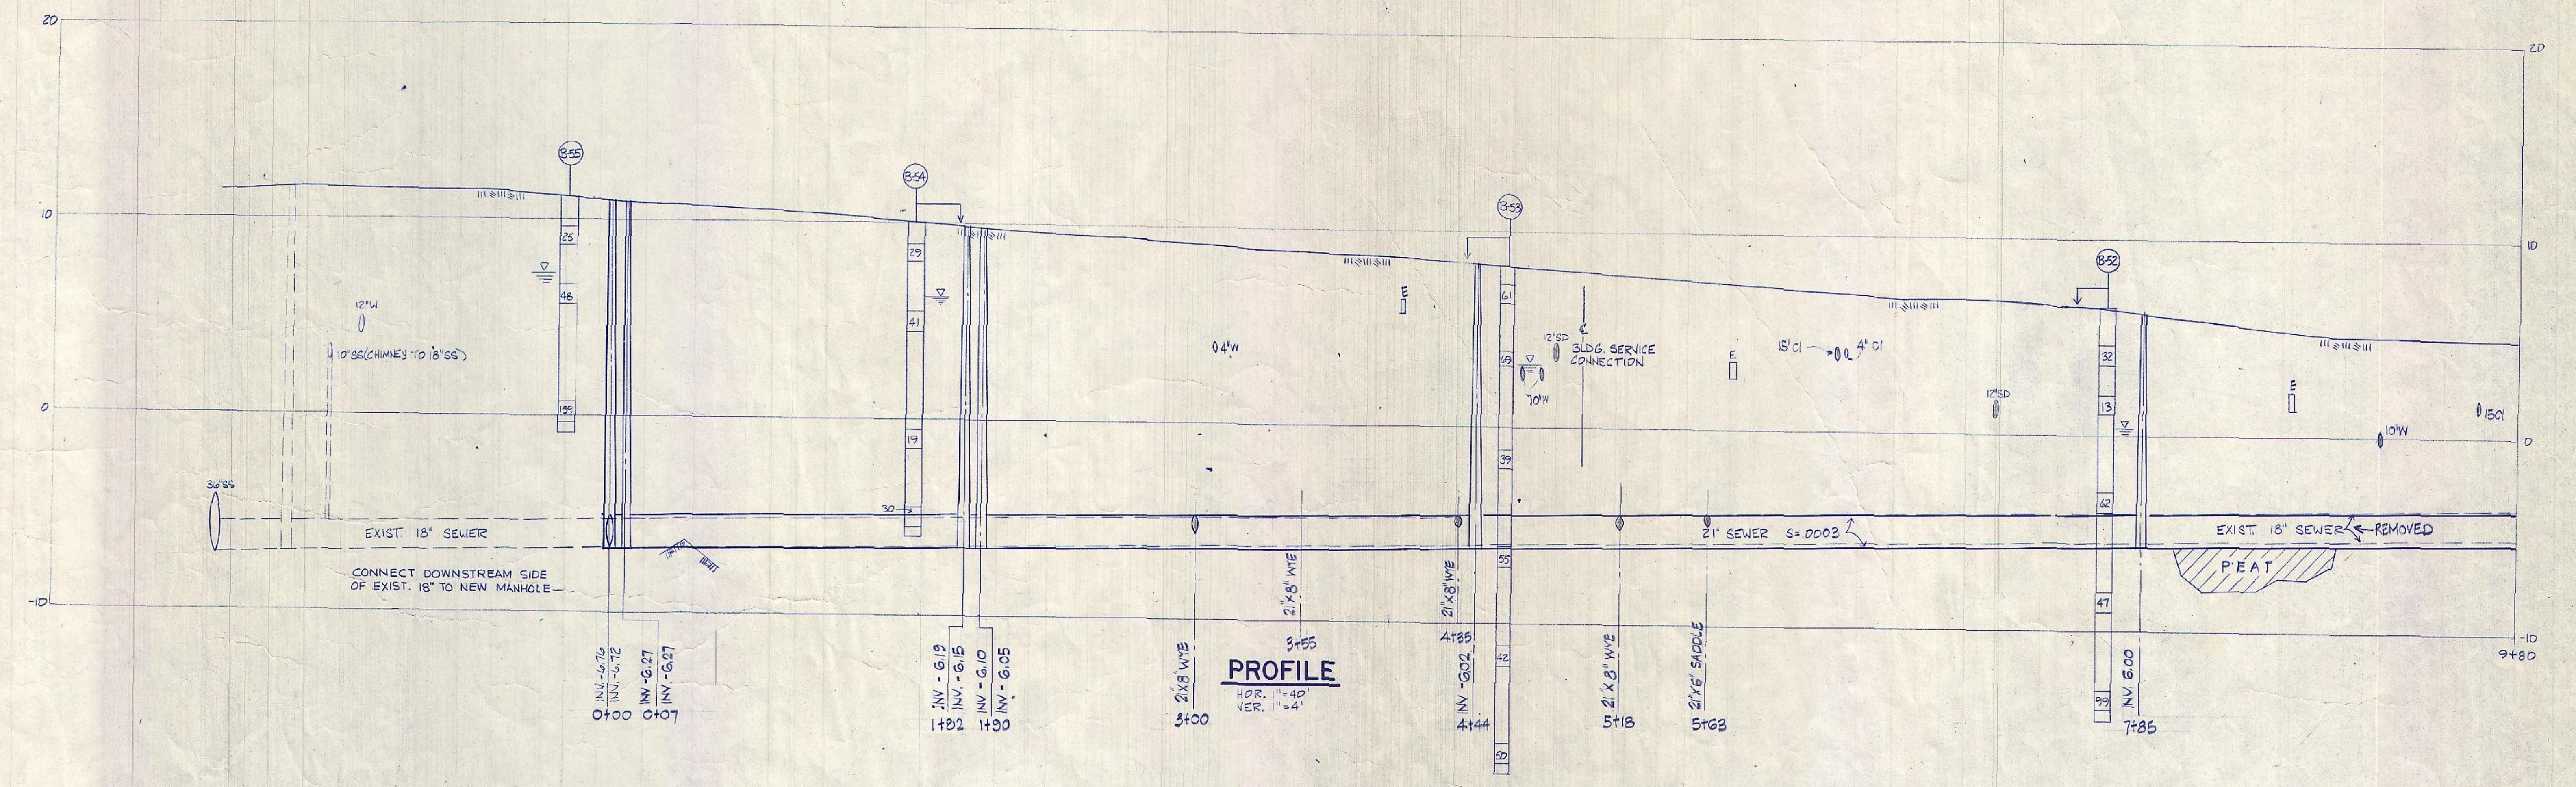

NOTES:
 1. PREDRAINAGE REQUIRED STA. 0+00 TO STA. 9+60.
 SEE SPECIFICATIONS SECTION D2140.
 2. FILTER FABRIC REQUIRED STA. 0+00 TO STA. 9+60.
 SEE SPECIFICATIONS SECTION D2221, PARAGRAPH 3.06.

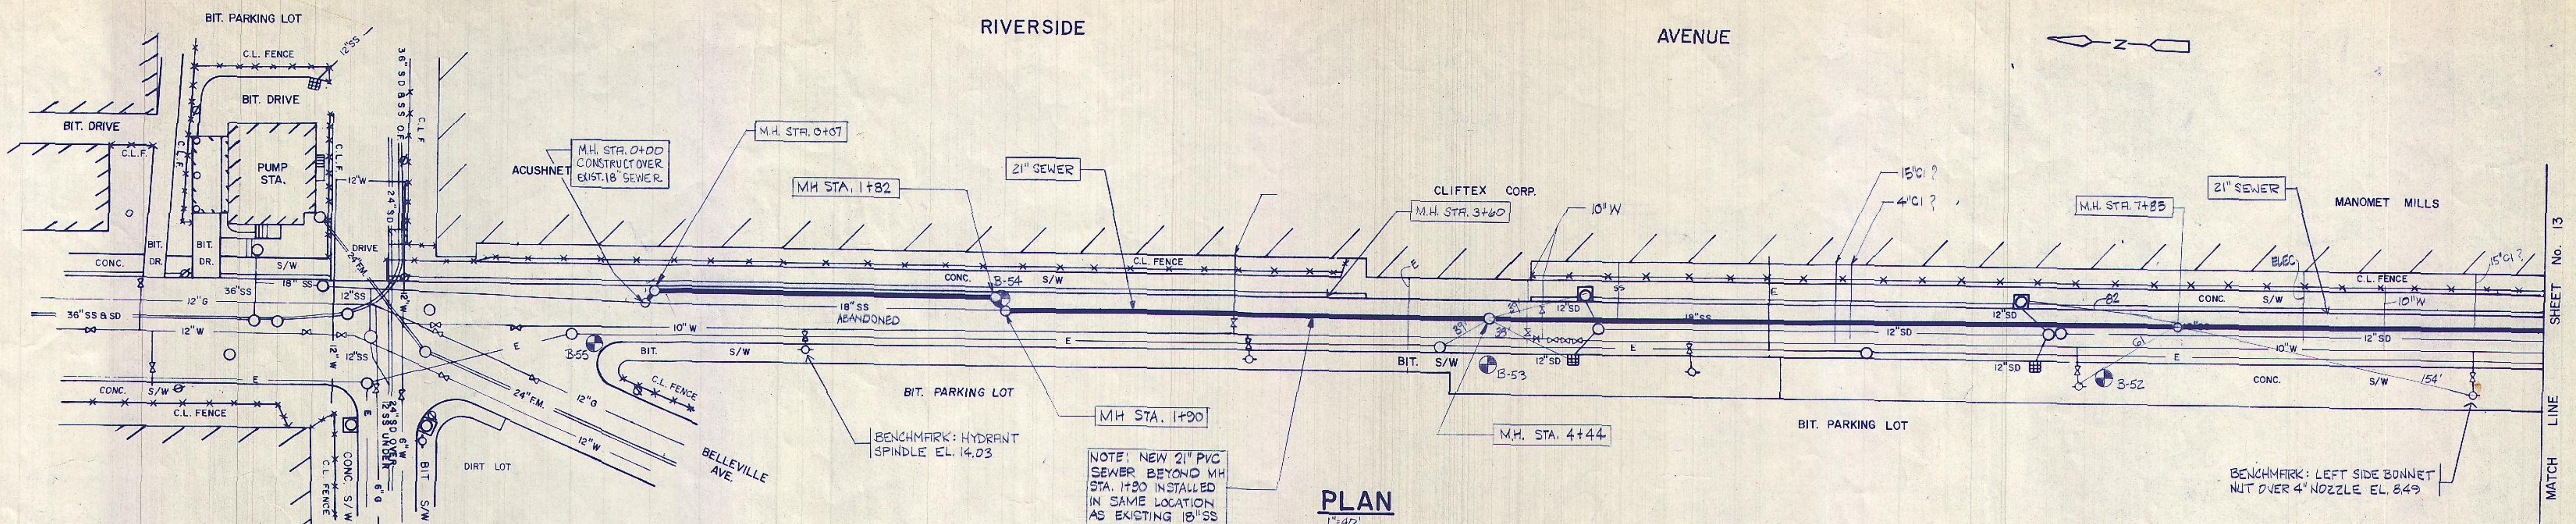

RECORD DRAWING		CITY OF NEW BEDFORD, MASSACHUSETTS BELLEVILLE AVENUE FORCE MAIN EXTENSION	
		CONTRACT NO. 5	
		RIVERSIDE AVENUE	
		CAMP DRESSER & MCKEE INC.	
		Ten Cambridge Center Cambridge, Massachusetts 02142	
		CDM	
		environmental engineers, scientists, planners & management consultants	
7/94 Date: _____ Ch'k'd: _____ Approved by: _____		SHEET NO. 12 309-47811	