



a division of ADS LLC.

Site Name:	003A	Meter Type:	ECHO	Monitor S/N:	914	MH #:	
Address / Location:	Cove Rd at Frank St			GPS N / W :	41.612541	-70.930915	
Access:	Drive	Safety Classification:	1	Type of System:	Combined	Pipe Height:	24 Inches
						Pipe Width:	24 Inches
						Communication #	166.219.174.53

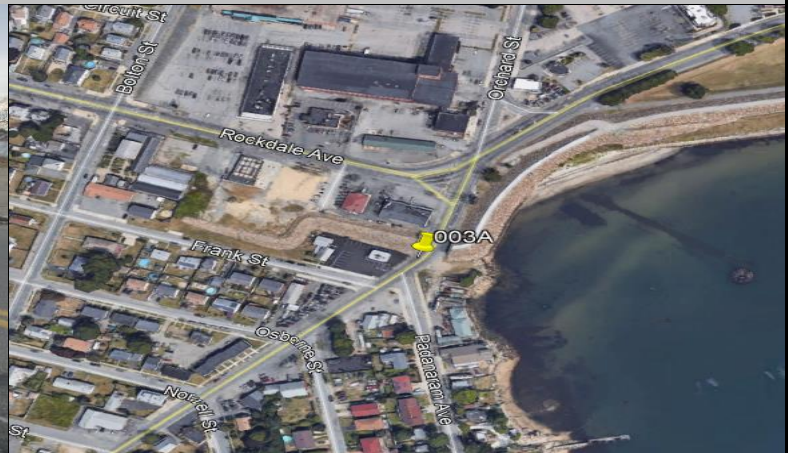

Access Photo				Site Map    N ↑				
Investigation Information:				Manhole Information:				
Date/Time of Investigation:	February 28, 2018		10:00AM		Manhole Depth:		108.5 Inches	
Site Hydraulics:				Manhole Material / Condition:		PIP		Good
				Active Drop Connections?				
Upstream Input: (L/S, P/S):				Pipe Material / Condition:				Good
Upstream Manhole:			Downstream MH:		Manhole Comments:			
Confirmation Information				Overflow Type / Dimensions:		High Level Pipe		
Depth of Flow (Wet Dof):		0 Inches    +/-    0.25		Overflow Comments:		overflow at 58.75"		
Range (Air Dof):		0 Inches    +/-    0.25		Flow Backup Source / Distance:				
Peak Velocity:		0		Road Cut Length:				
Silt:		0 Inches		Trench Length:				
Surcharge Height:		0 Inches		Mini System Character:		Commercial		

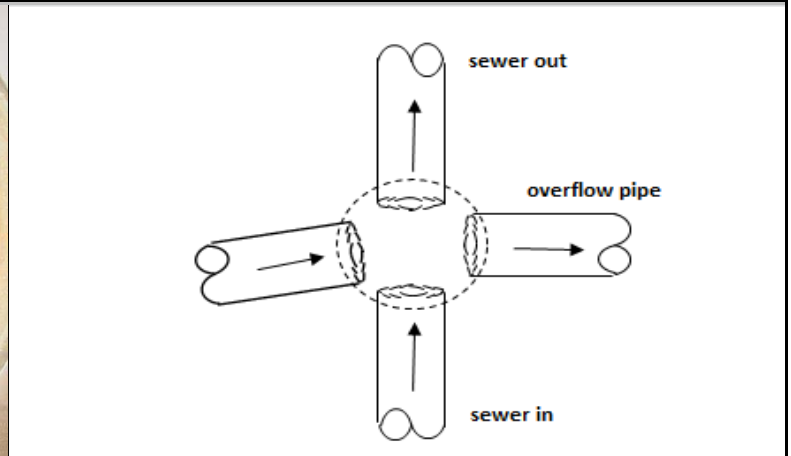

In Pipe Photo				Planar N ↑			
<b>Installation Information</b>				<b>Alarming</b>	<b>Active</b>	<b>Threshold</b>	<b>Units</b>
Installation Type:	Bar LRD						
Sensors / Devices:	Long Range Depth						
Antenna Type / Location:	Mini-Wing	Location:	Road				
Assigned Rain Gauge:							

Additional Site Information / Comments:

Detail needed / PO 18.13"