




## METER SITE INFORMATION FIELD LOG

<b>PROJECT:</b> New Bedford, MA	<b>DATE:</b> May 8, 2019	<b>JOB#:</b> 19000
<b>LOCATION:</b> 1517 Cove Road	<b>MH#:</b> 7242	<b>METER SITE:</b> 003A
<b>GPS/COMMENTS:</b> 41.612586, -70.930894		



	Size (")	Material	Flow Depth (")	Debris (")	Shape	MH Depth
Incoming	22	ACP	7.2	0.25	Circular	08' 11"
Incoming	12	VCP	8	3	Circular	08' 09"
Incoming	10	VCP	0	0	Circular	03' 07"
Outgoing	24	Concrete	7.2	0	Circular	09' 00"
Out O/F	24	Concrete	0	0	Circular	04' 03"

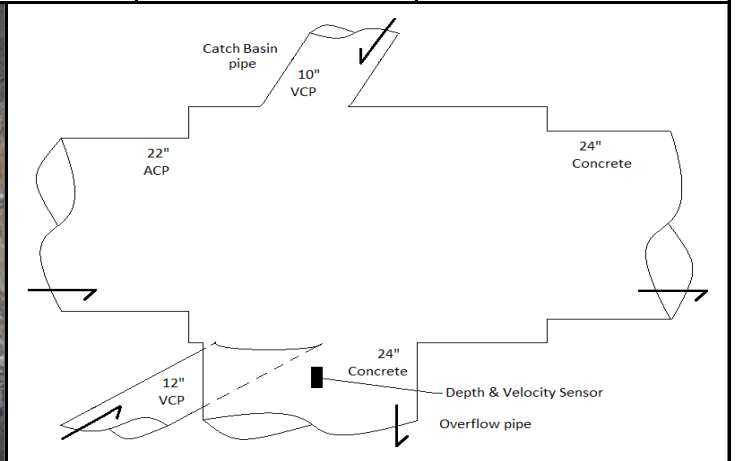

### SURCHARGE INFORMATION

<b>SURCHARGE NONE EVIDENT:</b> X
<b>SURCHARGED MARKS TO:</b>
<b>SURCHARGE CURRENTLY TO:</b>

### WEIR INFORMATION

<b>LENGTH:</b>	<b>HEIGHT ABOVE WEIR:</b>
<b>BREADTH:</b>	<b>OVERFLOW OCCURS AT:</b>
<b>LEVEL:</b>	

