

CSO SPEC SHEET

Structure #: REG 003 B

Date: 8/7/2012

Insp. By: _____

Location: South East corner of Cove Rd. and Norwell.

Structure Type: Concrete block over precast 48" SD

RCP/ Manhole

Structure DIM's: 4' Diameter Manhole

Size of Sewer Pipe: _____

Size of Storm Drain Pipe: 48" (+-)

Sewer Direction: _____

Type of Weir: _____

Weir Dim's: _____

Rim to Top of Weir: 6.93'

Rim to Storm Drain Invert: 8.40'

Rim to Top of Sewer (Normal Flow): 7.37'

Free Board: 5" (+-)

Over All Rating: (Circle One)

Poor


Fair

Good

Excellent

Comments: _____

Field Sketch:

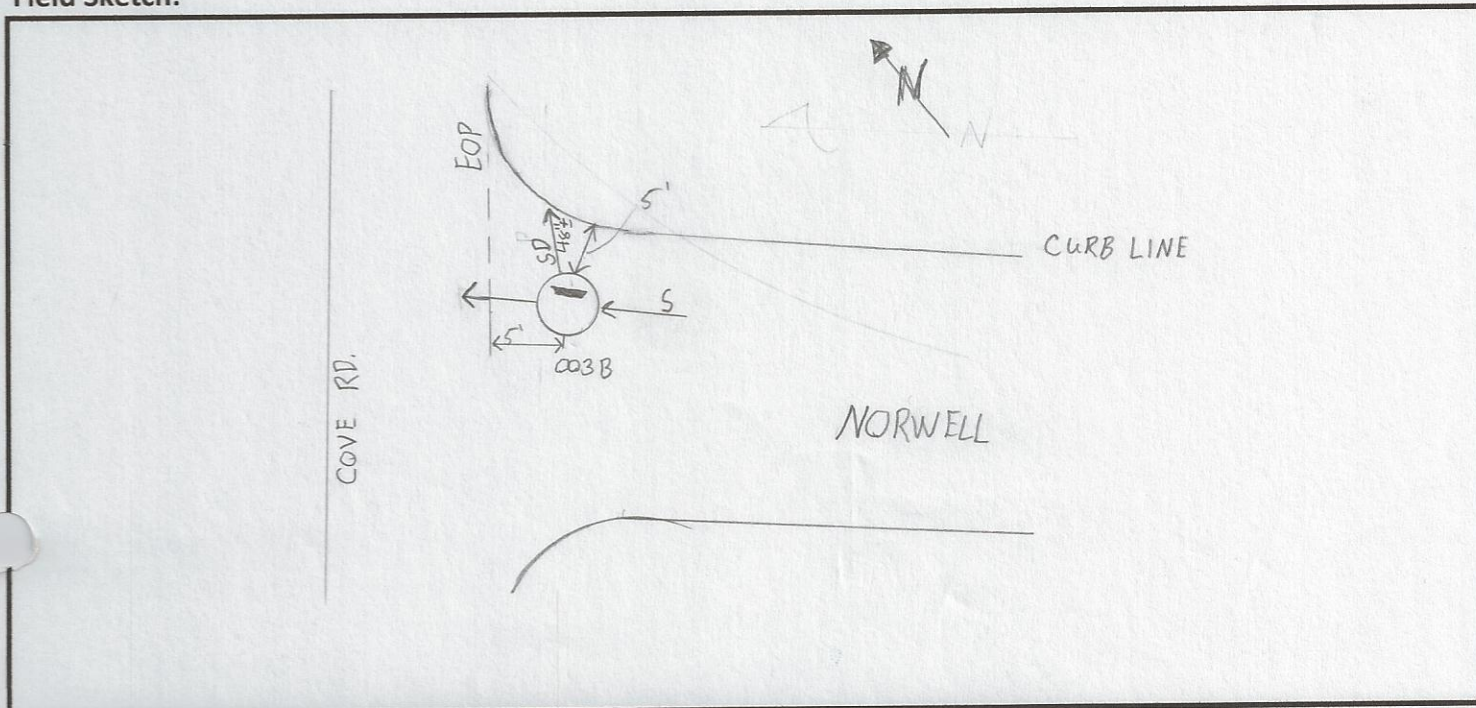

CSO FIELD PHOTOS

Structure#: Regulator 003B

Location: South East Corner of Cove Rd. and Norwell.

Figure 1.

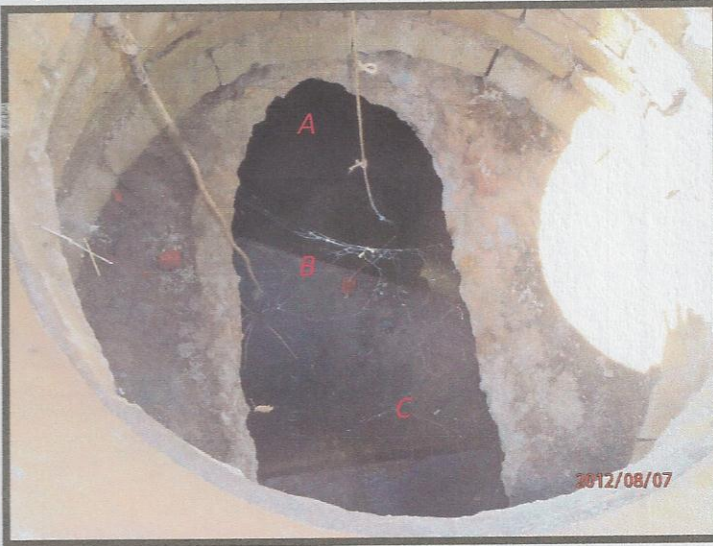


Figure 2.



Figure 3.




Descriptions

Figure 1: Inside view of manhole. A – Sewer; B – Weir Wall; C – Storm Drain.

Figure 2: Street view of the top of the manhole, standing on the south-west corner of the intersection of Cove and Norwell.

Figure 3: Street view of the top of the manhole, standing on the south-east corner of the intersection of Cove and Norwell.

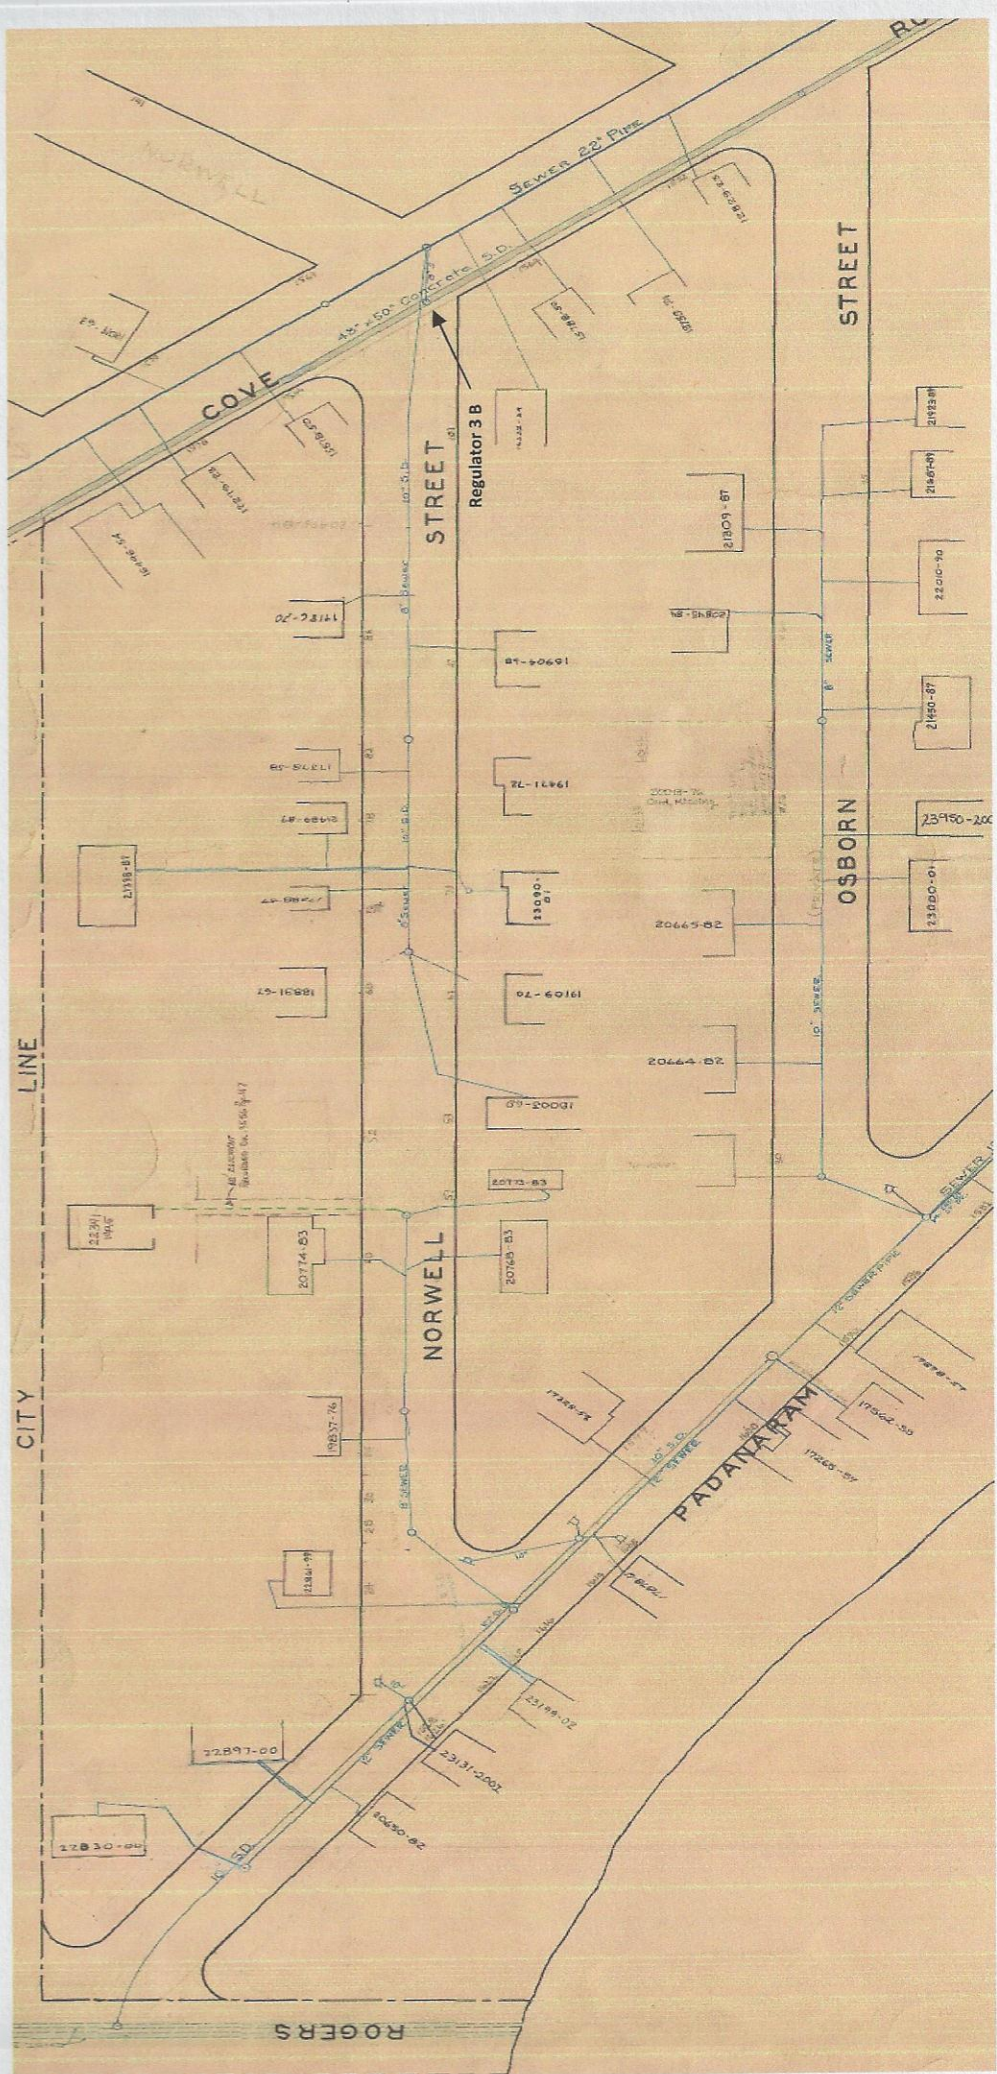

CSO/Regulator Repair Log

Structure #: Reg 003B

[illegible]