



NOTE:
ELEVATIONS SHOWN ARE IN
NEW BEDFORD CITY DATUM.

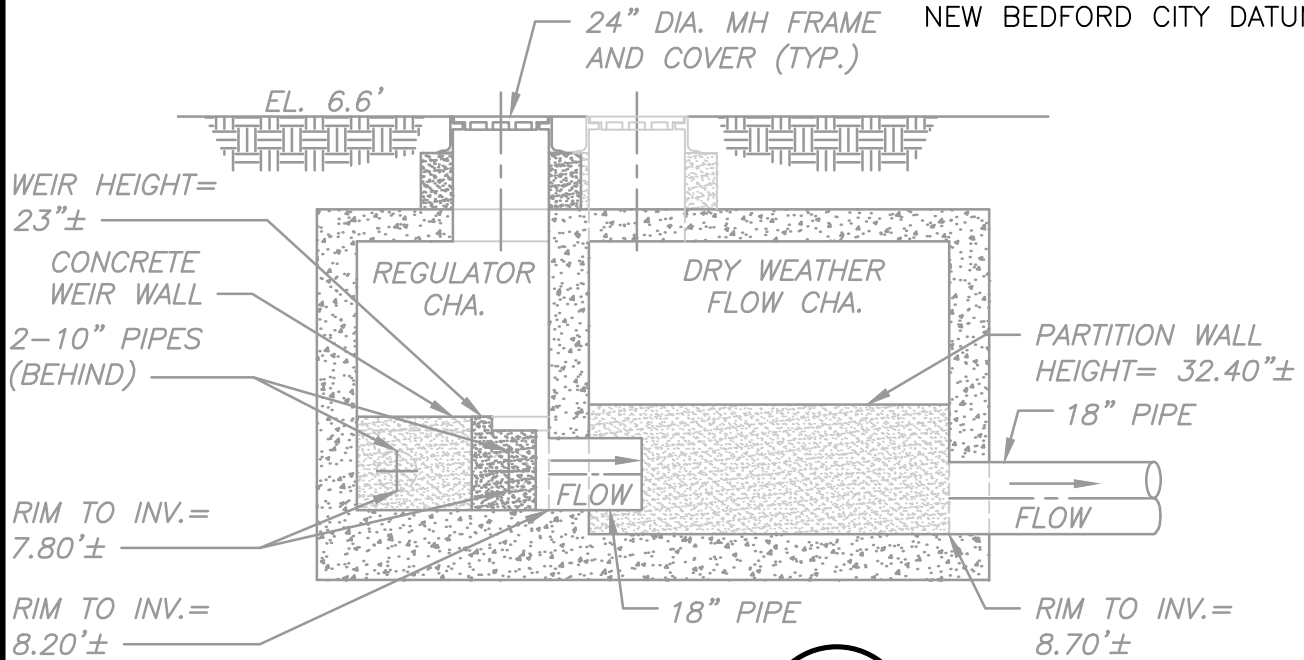

SECTION 2
1/4" = 1'-0"
SH.1

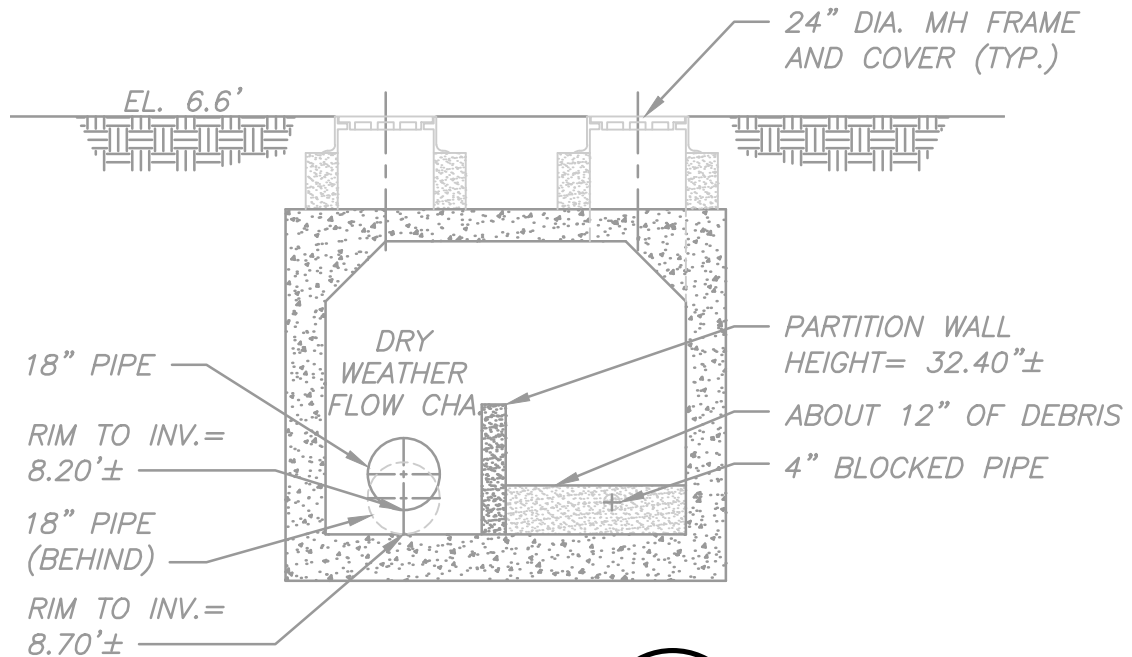

SECTION 3
1/4" = 1'-0"
SH.1

