



METER SITE INFORMATION FIELD LOG

PROJECT: New Bedford, MA	DATE: February 23, 2012	TIME:
LOCATION: Bonney Street at Rivet Street	MH#:	METER SITE: 7
COMMENTS:		

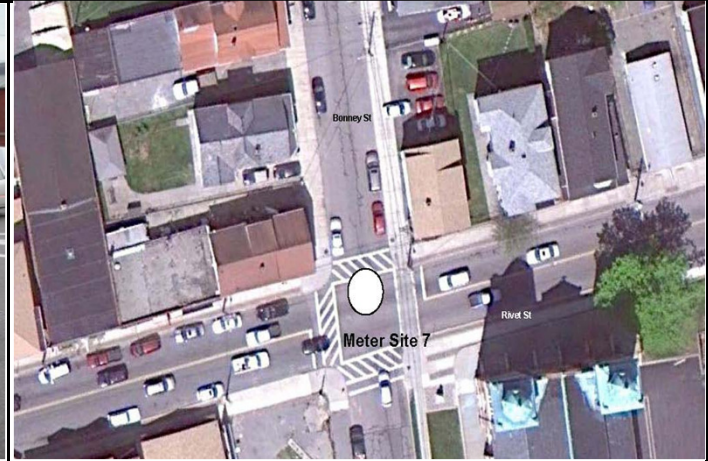

	Size (")	Material	Flow Depth (")	Debris	Shape	MH Depth
Incoming	72	Brick	24	0	Circular	9'10"
Incoming						
Outgoing	72	Brick	24	0	Circular	9'10"
Outgoing	17.5"H X 34"W	Brick	12	0	Rectangular	8'10"

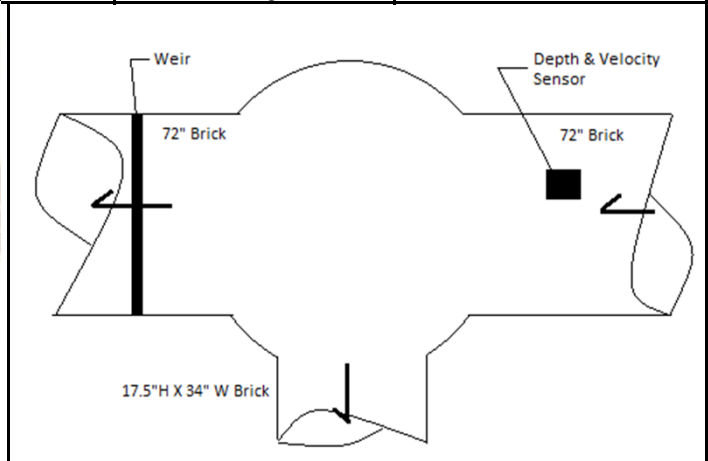

SURCHARGE INFORMATION		WEIR INFORMATION	
SURCHARGE NONE EVIDENT: X	LENGTH:	HEIGHT ABOVE WEIR: 37.5"	
SURCHARGED MARKS TO:	BREADTH:	OVERFLOW OCCURS AT:	
SURCHARGE CURRENTLY TO:	LEVEL:		

