


a division of ADS LLC.

Site Name:	004G	Meter Type:	ECHO	Monitor S/N:	897	MH #:	
Address / Location:	Crapo Rd at Rivet St			GPS N / W :	41.620248	-70.927123	
Access:	Drive	Safety Classification:	1	Type of System:	Combined	Pipe Height:	54 Inches
						Pipe Width:	54 Inches
						Communication #	107.80.27.86



Access Photo				Site Map N ↑			
Investigation Information:				Manhole Information:			
Date/Time of Investigation:	February 28, 2018		1:20PM	Manhole Depth:		81 Inches	
Site Hydraulics:				Manhole Material / Condition:		RCP	Good
				Active Drop Connections?			
Upstream Input: (L/S, P/S):				Pipe Material / Condition:		Brick	Good
Upstream Manhole:		Downstream MH:		Manhole Comments:			
Confirmation Information				Overflow Type / Dimensions:		End Weir	
Depth of Flow (Wet Dof):	0 Inches	+/-	0.25	Overflow Comments:		overflow at 20.87"	
Range (Air Dof):	0 Inches	+/-	0.25	Flow Backup Source / Distance:			
Peak Velocity:	0			Road Cut Length:			
Silt:	0 Inches			Trench Length:			
Surcharge Height:	0 Inches			Mini System Character:		Commercial	

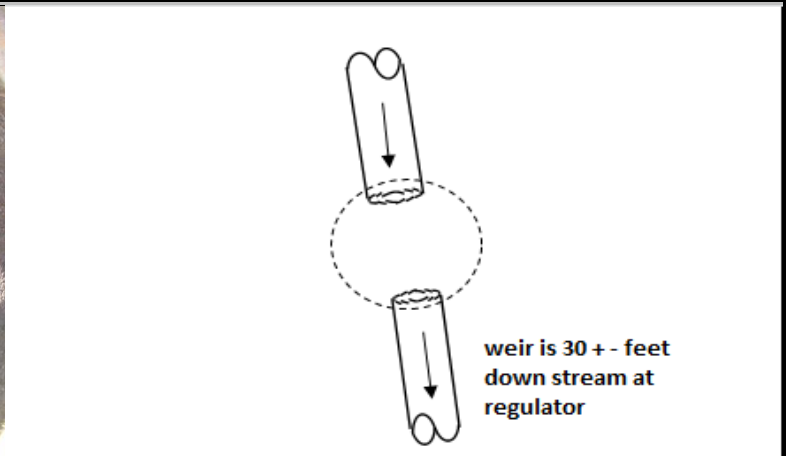

In Pipe Photo				Planar N ↑			
Installation Information				Alarming	Active	Threshold	Units
Installation Type:	Bar LRD						
Sensors / Devices:	Long Range Depth						
Antenna Type / Location:	Mini-Wing	Location:	Road				
Assigned Rain Gauge:							

Additional Site Information / Comments:

Detail needed / PO 22.13"