




METER SITE INFORMATION FIELD LOG

PROJECT: New Bedford, MA	DATE: May 8, 2019	JOB#: 19000
LOCATION: Crappo Street at Rivet Street	MH#: 6144	METER SITE: 004G
GPS/COMMENTS: 41.620094, -70.927096		



	Size (")	Material	Flow Depth (")	Debris (")	Shape	MH Depth
Incoming	54	Brick	0	0	Circular	07' 01"
Incoming	10	CIP	0	0	Circular	03' 02"
Incoming						
Outgoing	54	Brick	0	0	Circular	07' 02"

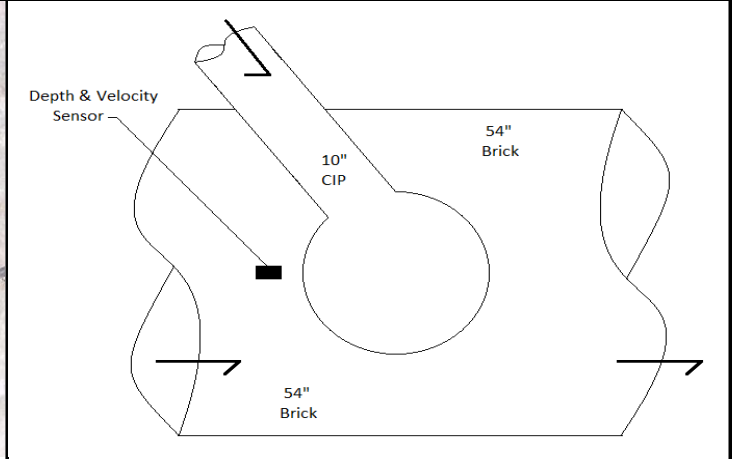

SURCHARGE INFORMATION

SURCHARGE NONE EVIDENT: X
SURCHARGED MARKS TO:
SURCHARGE CURRENTLY TO:

WEIR INFORMATION

LENGTH:	HEIGHT ABOVE WEIR:
BREADTH:	OVERFLOW OCCURS AT:
LEVEL:	

