

## CSO SPEC SHEET

Structure #: REG 004 H

Date: 10/ 16 / 2012

Insp. By: AH and AK

Location: At the Intersection of Bonney st. and Cove Rd.

Structure Type: Cast Iron

Regulator Type: Weir Wall/ Block Regulator

Structure DIM's: \_\_\_\_\_

Weir Dim's: \_\_\_\_\_

Size of Sewer Pipe: \_\_\_\_\_

Rim to Top of Weir: 8.3'

Size of Storm Drain Pipe: \_\_\_\_\_

Rim to Storm Drain Invert: \_\_\_\_\_

Sewer Direction: North to East

Rim to Top of Sewer (Normal Flow): 9.4'

Free Board: 1.1'

Over All Rating: (Circle One)

Poor


Fair

Good

Excellent

Comments: Major infiltration through bricks.

Field Sketch:

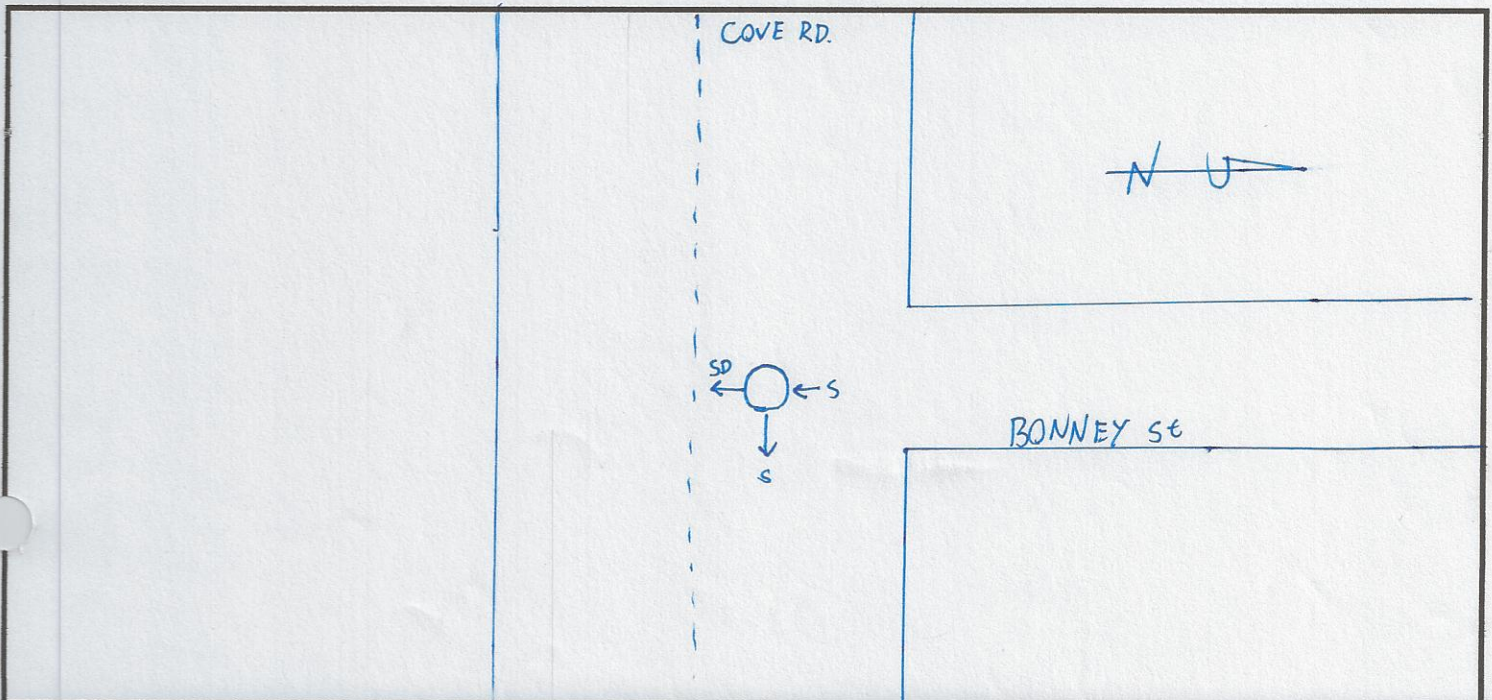



## CSO FIELD PHOTOS

Structure#: REG 004 H

Location: At the Intersection of Bonney St. and Cove Rd.

Figure 1.



Figure 2.


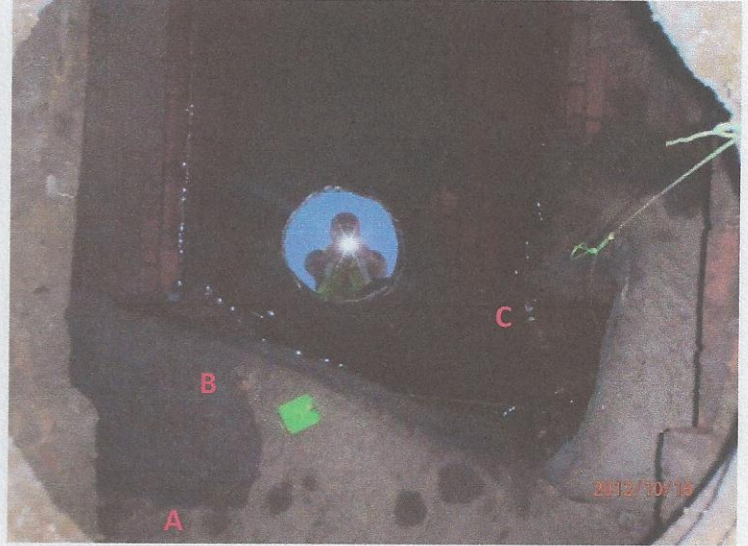


Figure 3.

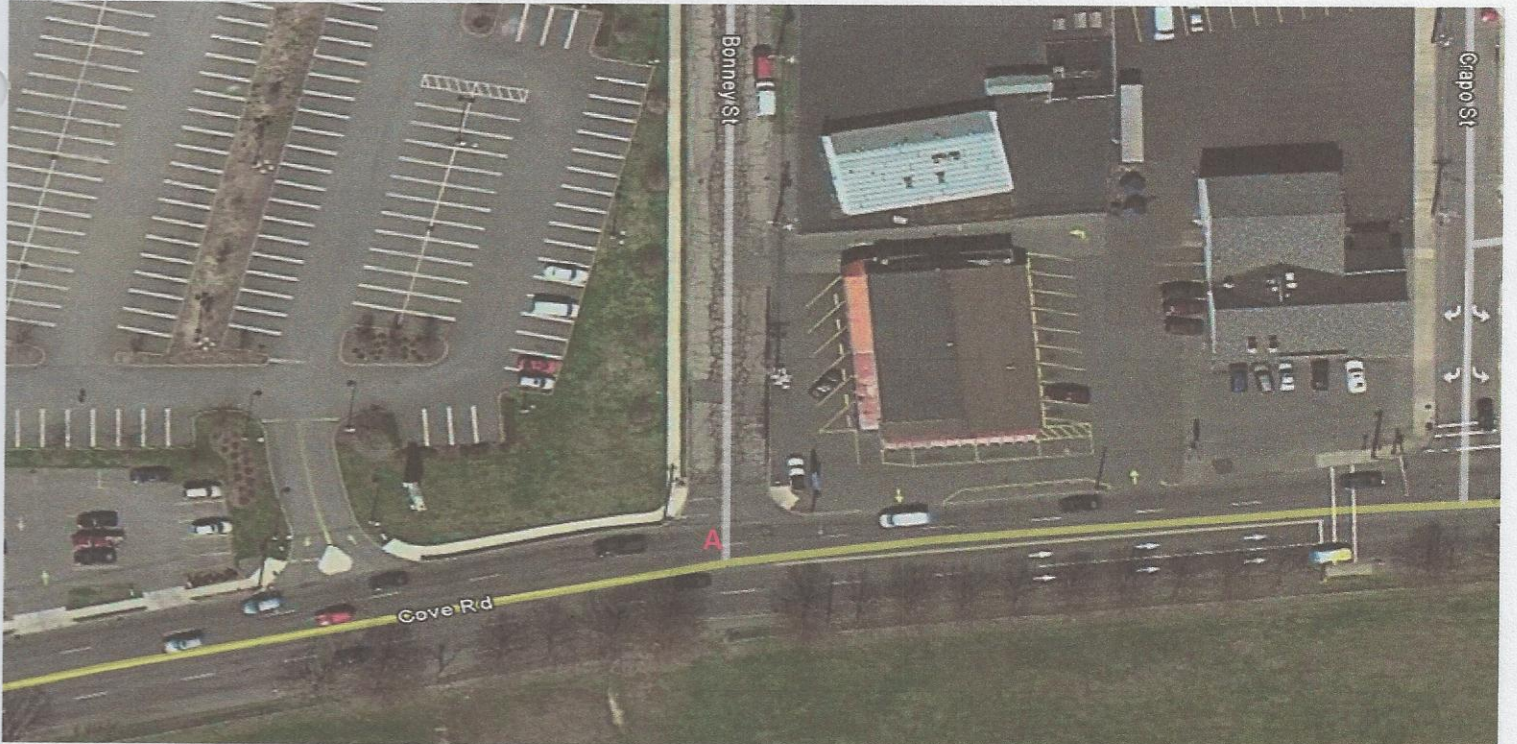

### Descriptions

Figure 1: View of Regulator 004 H. Facing North.

Figure 2: Inside view of manhole. A-Storm Drain; B- Weir Wall; C- Sewer.

Figure 3: Google Earth image of Regulator 004 H. A- REG 004 H.



