

## CSO SPEC SHEET

Structure #: REG 004 I

Date: 08/ 23 / 2012

Insp. By: AH and AK

Location: At the Intersection of Rodney French Blvd and David St.

Structure Type: Cast Iron

Regulator Type: Weir Wall/ Block Regulator

Structure DIM's: \_\_\_\_\_

Weir Dim's: \_\_\_\_\_

Size of Sewer Pipe: 10"

Rim to Top of Weir: 3.7'

Size of Storm Drain Pipe: 10"

Rim to Storm Drain Invert: 8.8'

Sewer Direction: East to South

Rim to Top of Sewer (Normal Flow): 8.5'

Free Board: 4.8'

Over All Rating: (Circle One)

Poor


Fair

Good

Excellent

Comments: No Repairs needed.

Field Sketch:

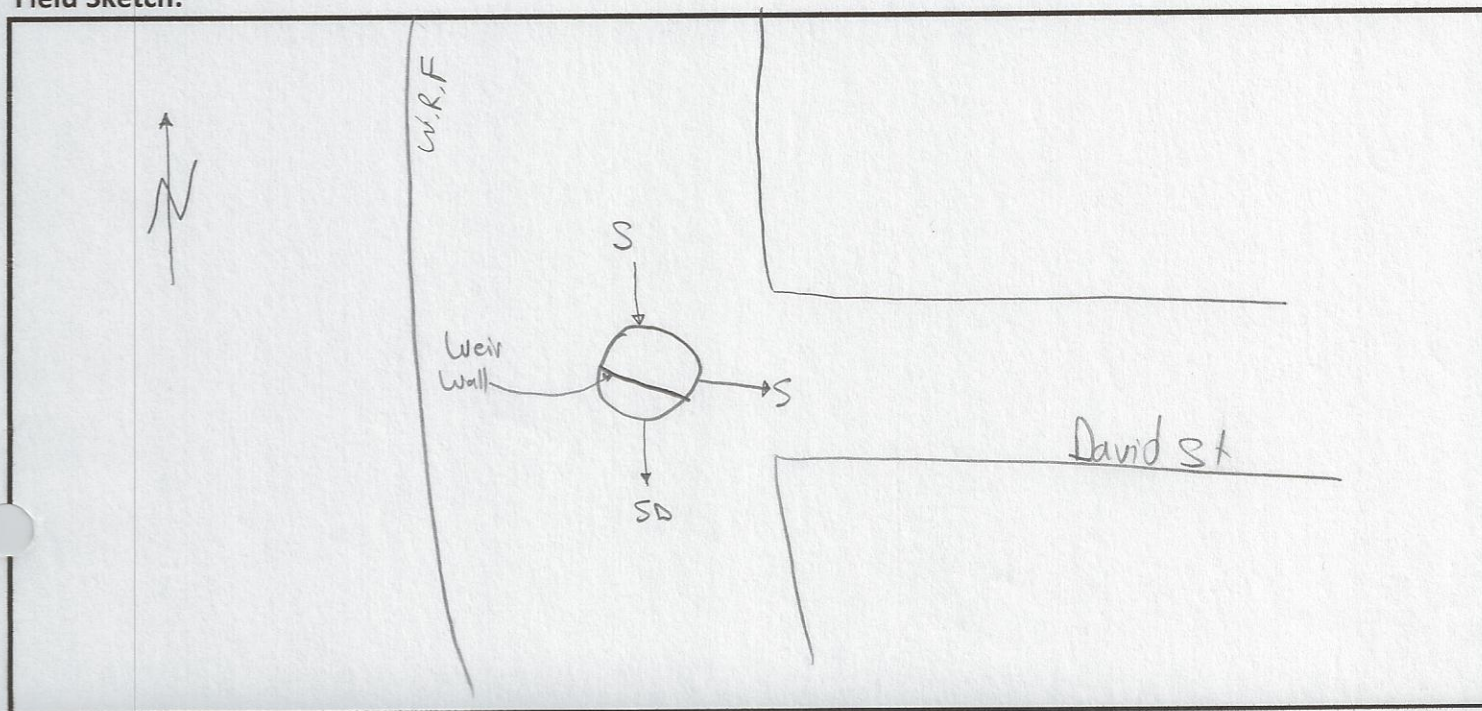



## CSO FIELD PHOTOS

Structure#: REG 004 I

Location: At the Intersection of Rodney French Blvd and David St.

Figure 1.



Figure 2.



Figure 3.



Figure 4.



### Descriptions

**Figure 1:** View of Regulator 004 I. Facing North.

**Figure 2:** Inside view of manhole. A-Storm Drain; B- Weir Wall; C- Sewer.

**Figure 3:** Street view of Regulator 004 I. Facing East.

**Figure 4:** Google Earth image of Regulator 004 I. A- REG 004 I; B- CSO 004 outfall pipe.







## CSO/Regulator Repair Log

Structure #: Reg 004 I

[illegible]