

New Bedford Regulator Specification Sheet

Regulator #: R-006B**Location:** Oaklawn St. near W. Rodney French Blvd.**Date:** 6/25/25


Structure Measurements


Structure Type: Single manhole**Rim Elevation (ft City Datum):** 10.2**Regulator Type:** Fixed Weir**Overflow Height (ft or in):** 4"**Rim to Top of Weir (ft):** 8.4**Weir Dims (ft or in):** Length: 10", Width: 3", Height: 4"**Influent pipe \varnothing (in):** 10**Rim to Influent Invert (ft):** 8.7**Dry Weather Connection \varnothing (in):** 8**Rim to Dry Weather Invert (ft):** 8.7**Overflow pipe \varnothing (in):** 10**Rim to Overflow Invert (ft):** 8.7

Sensor Measurements

Block Present: Yes**Level Sensor Status:** Not Metered**Sensor Installation Date:** n/a**Intra-System Status:** Yes**Tide Gate Status:** None**Notes:** Weir is made out of one brick and is very ineffective

Location Sketch:

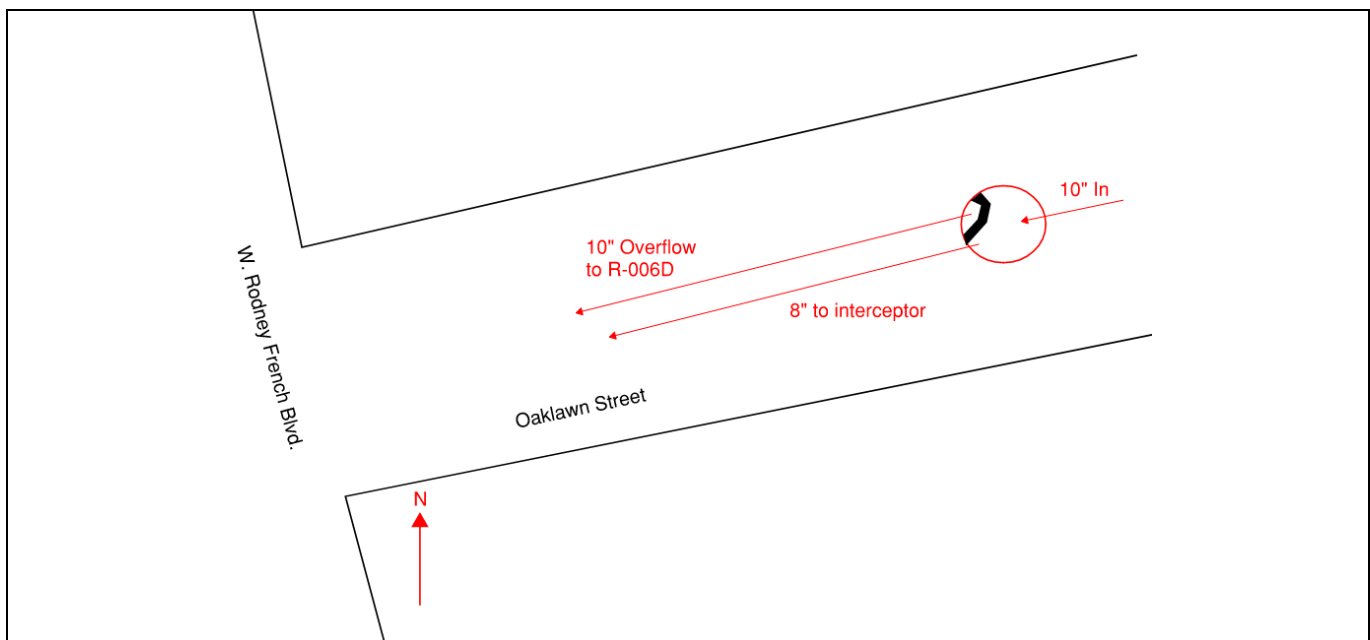

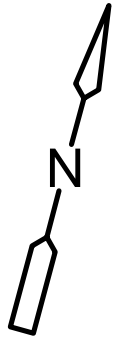

BRICK WEIR WALL
LENGTH= 10.00'±
THICKNESS= 3.00'±

OAKLAWN
STREET

10" PIPE

10" PIPE



24" DIA. MH FRAME
AND COVER (ABOVE)

8" PIPE TO
INTERCEPTOR

PLAN

$\frac{3}{8}" = 1'-0"$



NOTE:
ELEVATIONS SHOWN ARE IN
NEW BEDFORD CITY DATUM.

EL. 10.2'



24" DIA. MH FRAME
AND COVER

WEIR HEIGHT=
4.00'±

10" PIPE


CONCRETE FILL


8" PIPE

RIM TO INV.=
8.70'±

SECTION

$\frac{3}{8}" = 1'-0"$

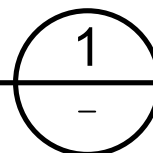

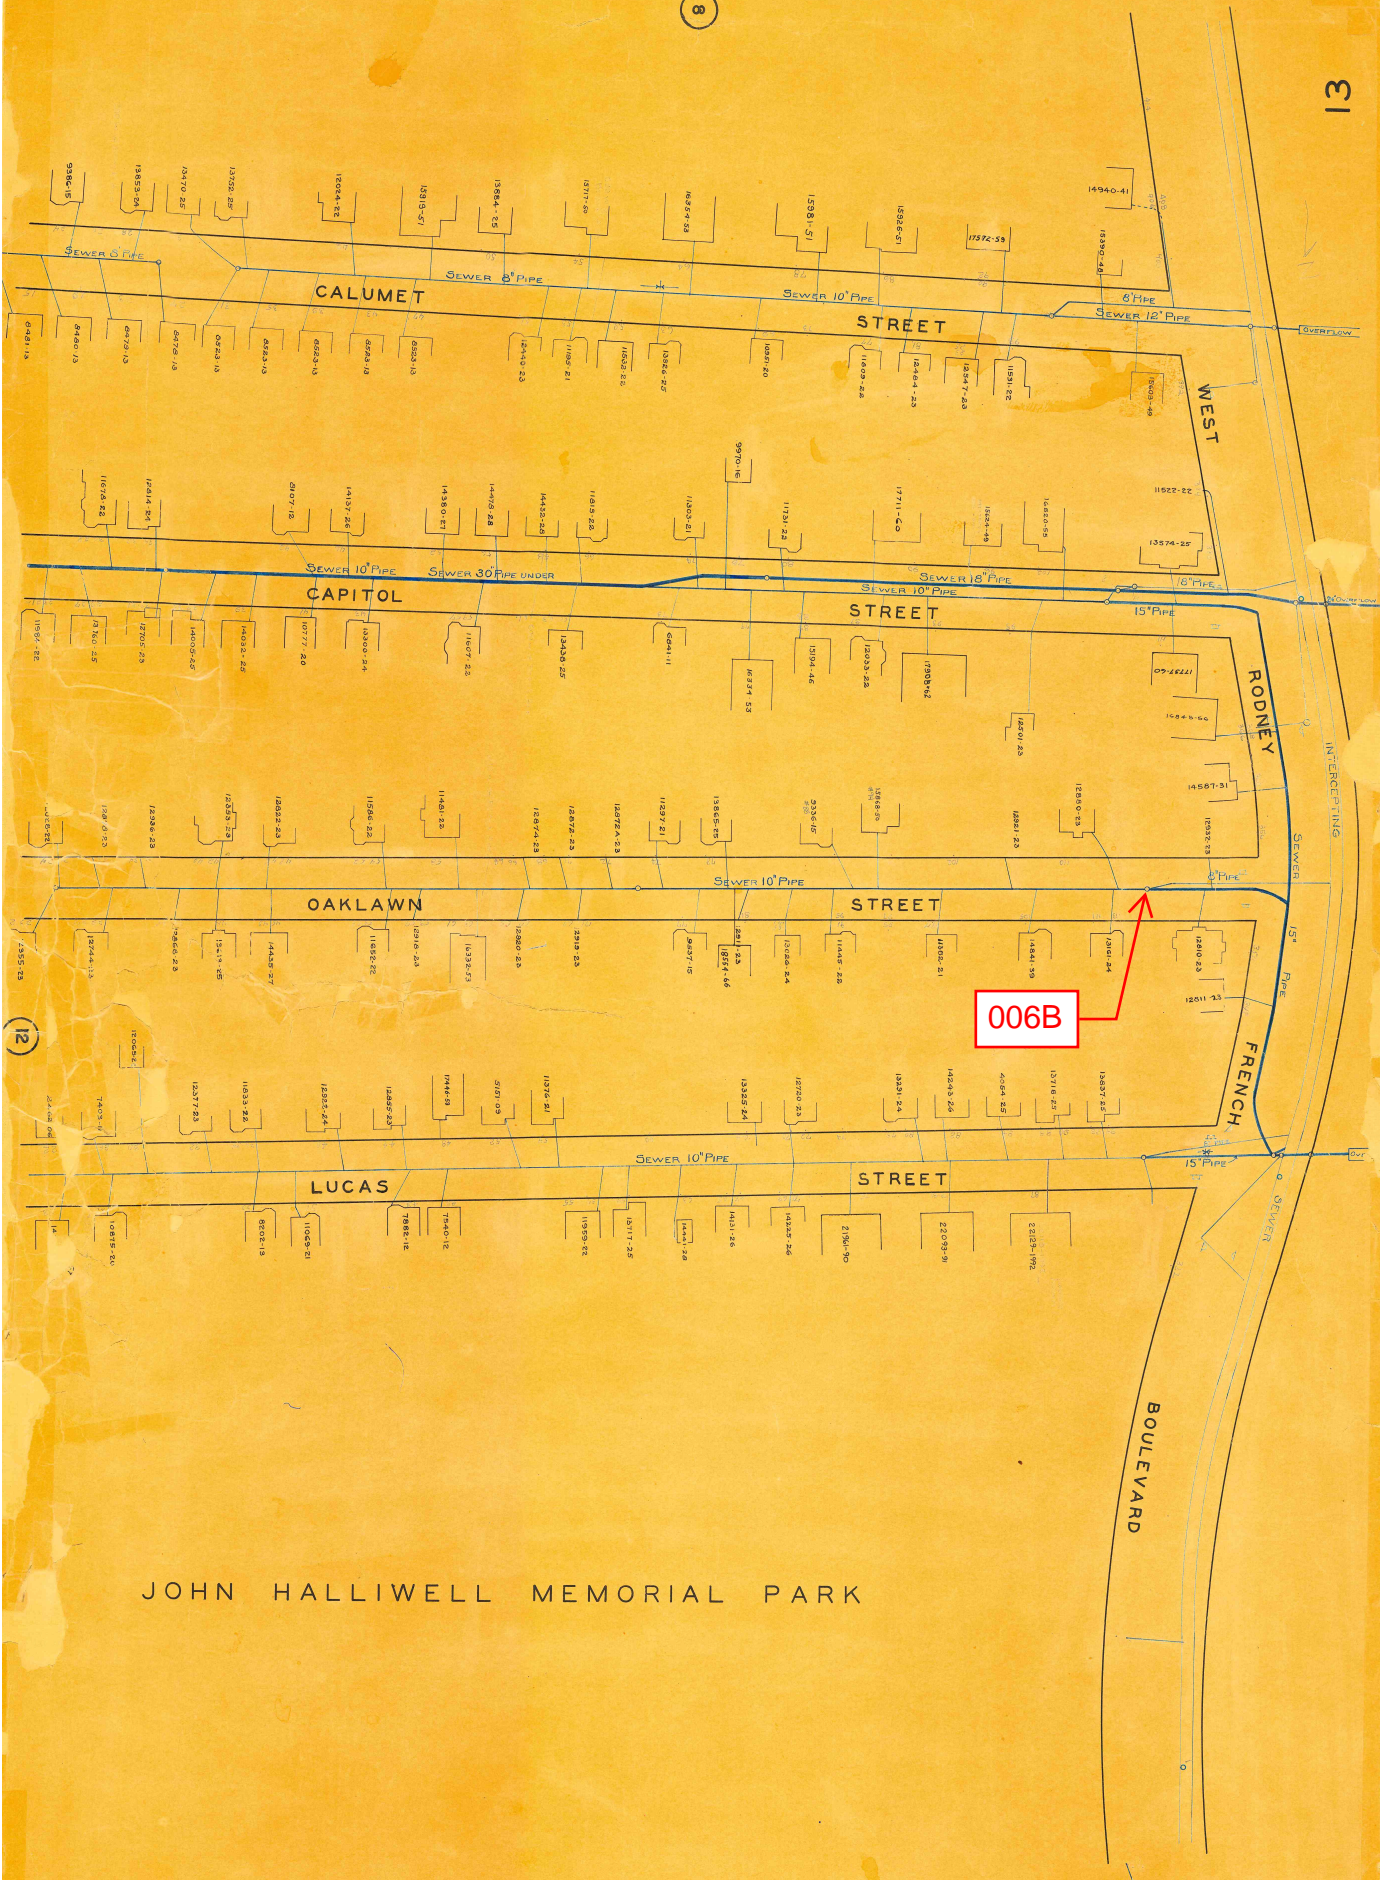

JOHN HALLIWELL MEMORIAL PARK

REGULATOR FIELD PHOTOS

Figure 1



Figure 2



Figure 3



Figure 4



Descriptions:

Figure 1: Inside of R-006B. Inflow, outflow, weir, and overflow visible.

Figure 2: Inside of R-006B. Inflow, outflow, weir, and overflow visible.

Figure 3: Google Earth snapshot facing west along Oaklawn Street. Manhole marked in red

Figure 4: Aerial location with arrow pointing to corresponding manhole.