

CSO SPEC SHEET

Structure #: REG 006 C

Date: 08/ 22/ 2012

Insp. By: AH and AK

Location: At the West End of Capitol St Near French Rodney Blvd.

Structure Type: Cast Iron

Structure DIM's: _____

Size of Sewer Pipe: 10"

Size of Storm Drain Pipe: 18"

Sewer Direction: East to South

Regulator Type: Weir Wall

Weir Dim's:

Rim to Top of Weir: 7.2'

Rim to Storm Drain Invert: 8.8'

Rim to Top of Sewer (Normal Flow): 8.9'

Free Board: 1.7'

Over All Rating: (Circle One)

Poor


Fair

Good

Excellent

Comments: No Repairs Needed.

Field Sketch:

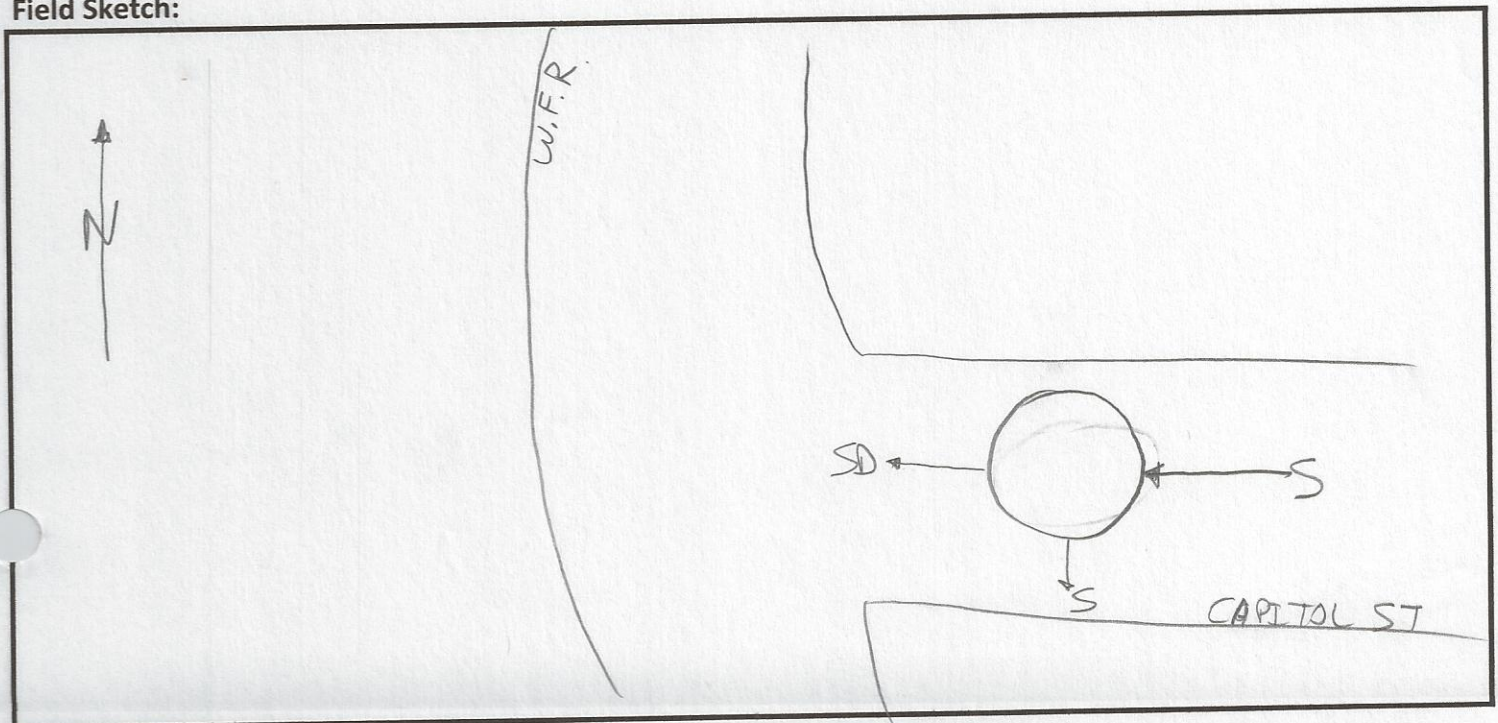

CSO FIELD PHOTOS

Structure#: REG 006 C

Location: At the West End of Capitol St Near French Rodney Blvd.

Figure 1.



Figure 2.



Figure 3.



Figure 4.



Descriptions

Figure 1: View of Regulator 006 C. Facing North.

Figure 2: Inside view of manhole. A-Storm Drain; B- Weir Wall; C- Sewer.

Figure 3: Street view of Regulator 006 C. Facing Clark's Cove.

Figure 4: Google Earth image of Regulator 006 C. A- REG 006B; B- CSO 006 outfall pipe.

CSO/Regulator Repair Log

Structure #: Reg 006 C

[illegible]