


a division of ADS LLC.

Site Name:	006D	Meter Type:	ECHO	Monitor S/N:	902	MH #:	
Address / Location:	Rodney French Rd at Lucas St			GPS N / W :	41.604477	-70.914987	
Access:	Drive	Safety Classification:	1	Type of System:	Combined	Pipe Height:	15 Inches
						Pipe Width:	15 Inches
						Communication #	107.80.27.213



Access Photo				Site Map    N ↑						
Investigation Information:				Manhole Information:						
Date/Time of Investigation:	February 28, 2018		11:15AM		Manhole Depth:		95.13 Inches			
Site Hydraulics:				Manhole Material / Condition:		RCP		Good		
				Active Drop Connections?						
Upstream Input: (L/S, P/S):				Pipe Material / Condition:			Good			
Upstream Manhole:			Downstream MH:				Manhole Comments:			
Confirmation Information				Overflow Type / Dimensions:		Side Weir				
Depth of Flow (Wet Dof):		0 Inches    +/-    0.25		Overflow Comments:		overflow at 51.25"				
Range (Air Dof):		0 Inches    +/-    0.25		Flow Backup Source / Distance:						
Peak Velocity:		0		Road Cut Length:						
Silt:		0 Inches		Trench Length:						
Surcharge Height:		0 Inches		Mini System Character:		Residential				

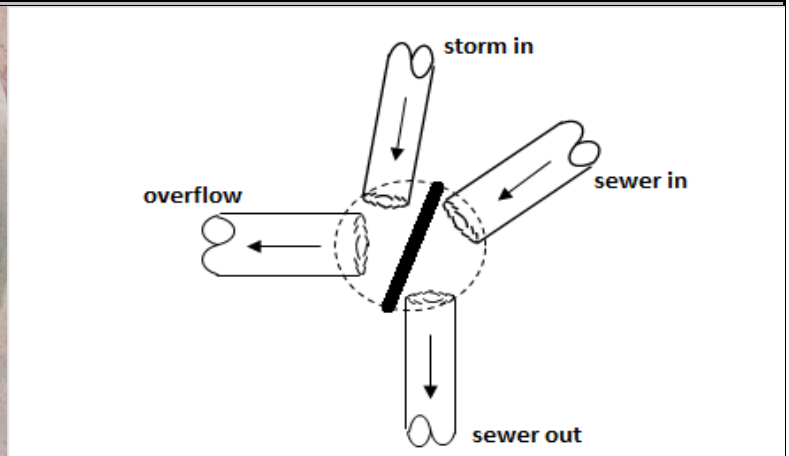

In Pipe Photo				Planar N ↑			
<b>Installation Information</b>				<b>Alarming</b>	<b>Active</b>	<b>Threshold</b>	<b>Units</b>
Installation Type:	Bar LRD						
Sensors / Devices:	Long Range Depth						
Antenna Type / Location:	Mini-Wing	Location:	Road				
Assigned Rain Gauge:							

**Additional Site Information / Comments:**

Detail needed / PO 31.13 weir length 38.0" width 3.5"