



PLAN

$3/8" = 1' - 0"$

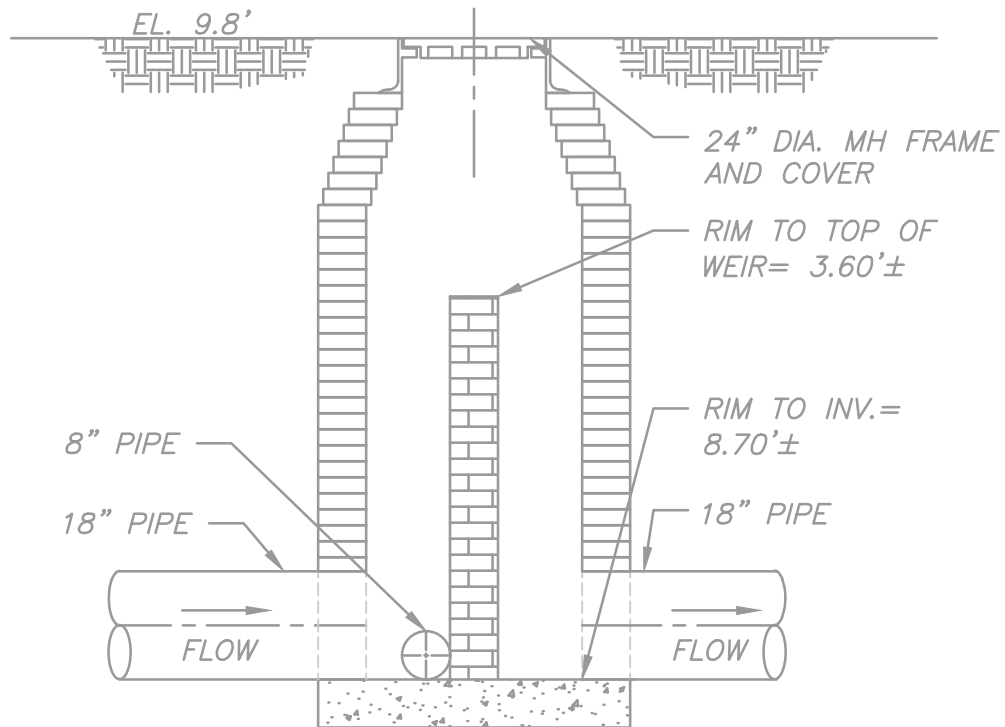

SECTION

$3/8" = 1' - 0"$

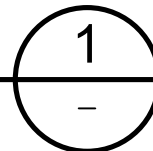

NOTES:

1. ELEVATIONS SHOWN ARE IN NEW BEDFORD CITY DATUM.
2. INLET INVERT ELEVATION MANUALLY MEASURED BY REDZONE ON 12/11/2024. 3D SCAN DID NOT REACH BOTTOM OF CHAMBER.
3. RIM TO TOP OF WEIR, WEIR LENGTH, AND WEIR WIDTH CONFIRMED BY SCAN.