

CSO SPEC SHEET

Structure #: REG 007 A

Date: 08/ 23 / 2012
Insp. By: AH and AK

Location: West of the Intersection of Rodney French Blvd and Capitol St.

Structure Type: Cast Iron

Structure DIM's: _____

Size of Sewer Pipe: 18"

Size of Storm Drain Pipe: 18"

Sewer Direction: East to South

Regulator Type: Weir Wall/ Block Regulator

Weir Dim's: _____

Rim to Top of Weir: 3.8'

Rim to Storm Drain Invert: 8.1'

Rim to Top of Sewer (Normal Flow): 7.4'

Free Board: 3.6'

Over All Rating: (Circle One)

Poor


Fair

Good

Excellent

Comments: No Repairs needed.

Field Sketch:

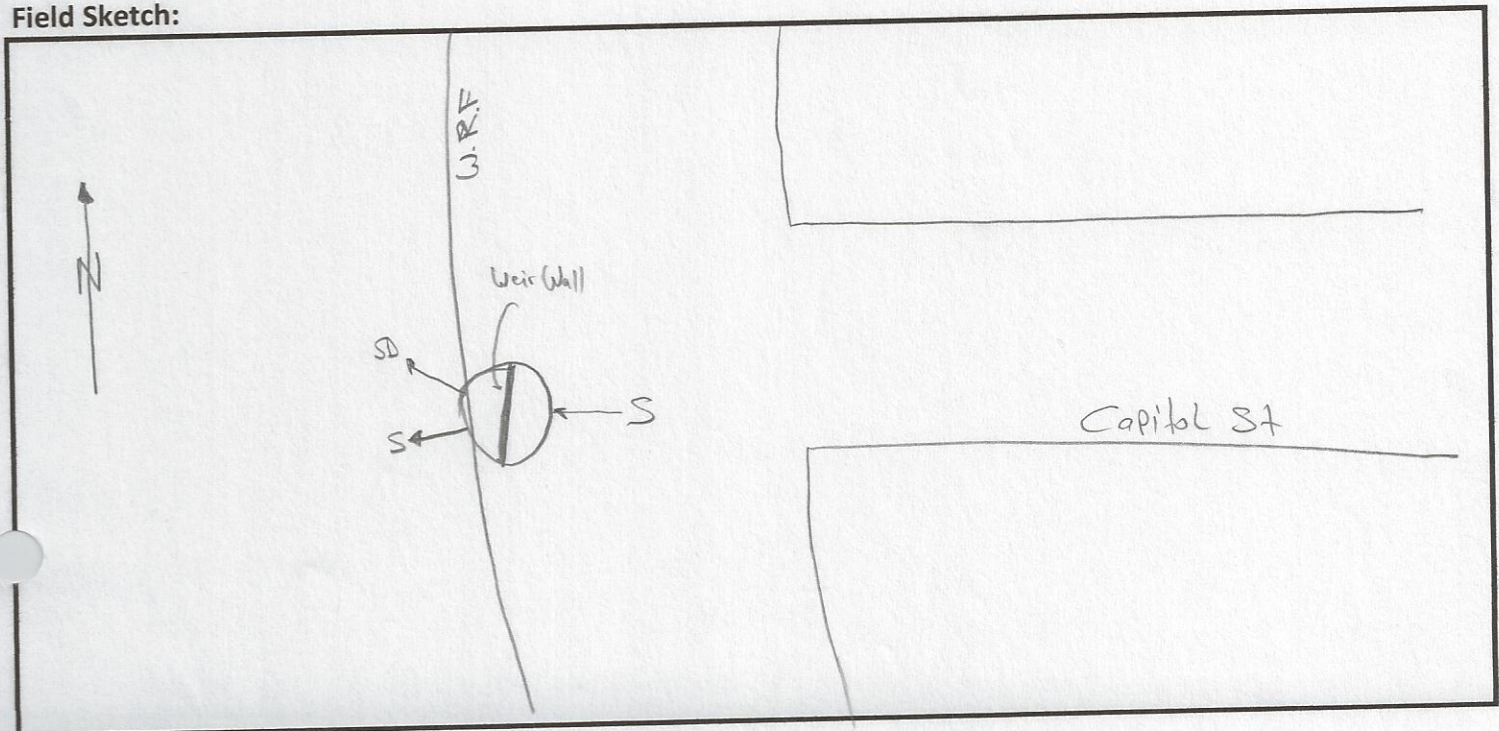

CSO FIELD PHOTOS

Structure#: REG 007 A

Location: West of the Intersection of Rodney French Blvd and Capitol St.

Figure 1.



Figure 2.

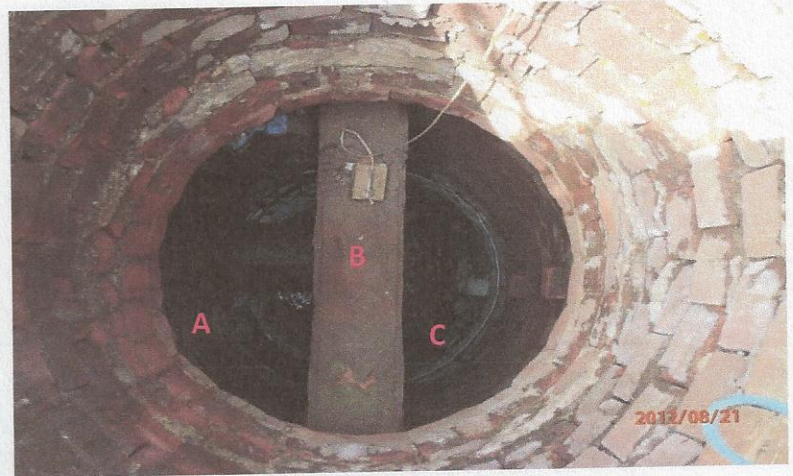


Figure 3.



Figure 4.




Descriptions

Figure 1: View of Regulator 007 A. Facing North.

Figure 2: Inside view of manhole. A-Storm Drain; B- Weir Wall; C- Sewer.

Figure 3: Street view of Regulator 007 A. Facing Clark's Cove.

Figure 4: Google Earth image of Regulator 007 A. A- REG 007A; B- CSO 007 outfall pipe.

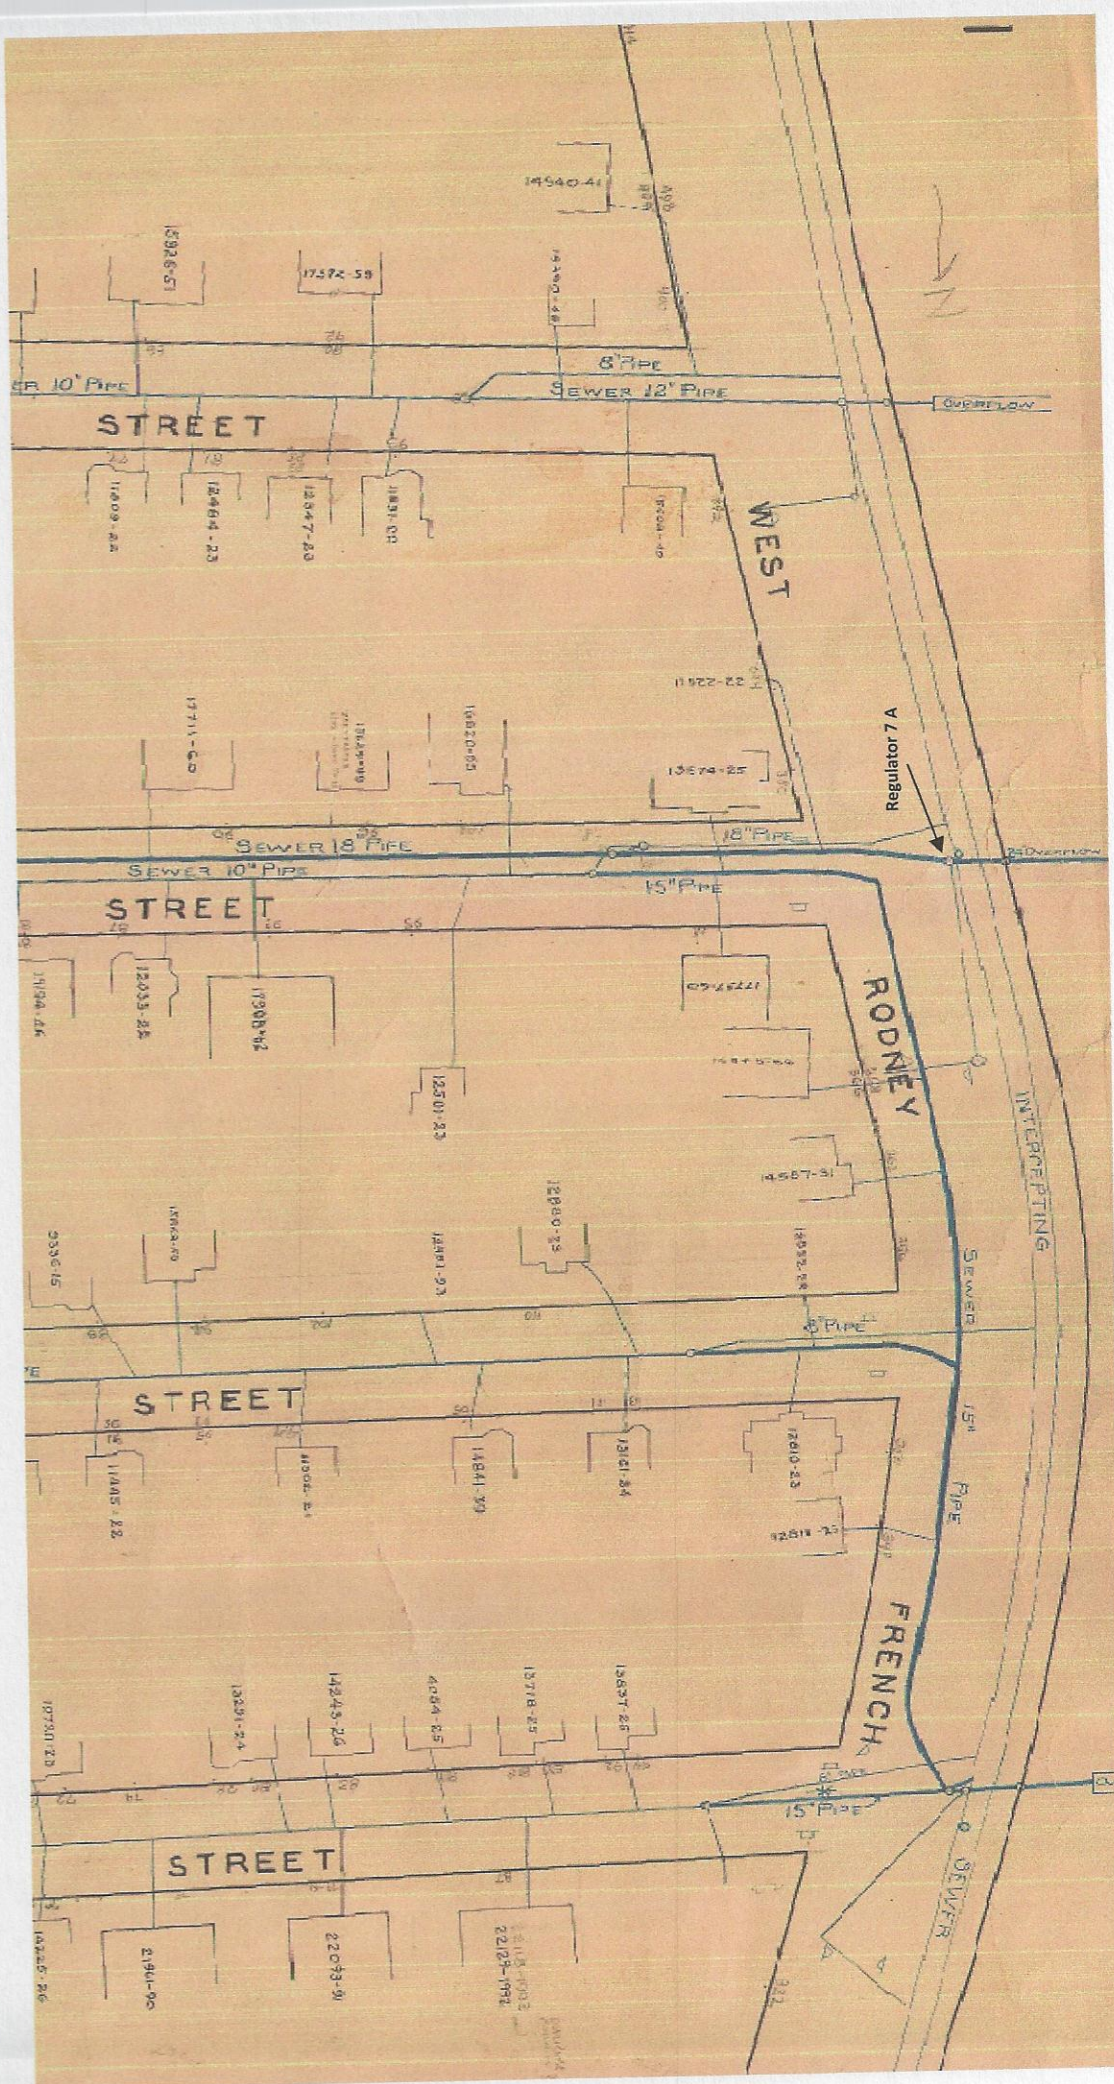

CSO/Regulator Repair Log

Structure #: Reg 007A

[illegible]