




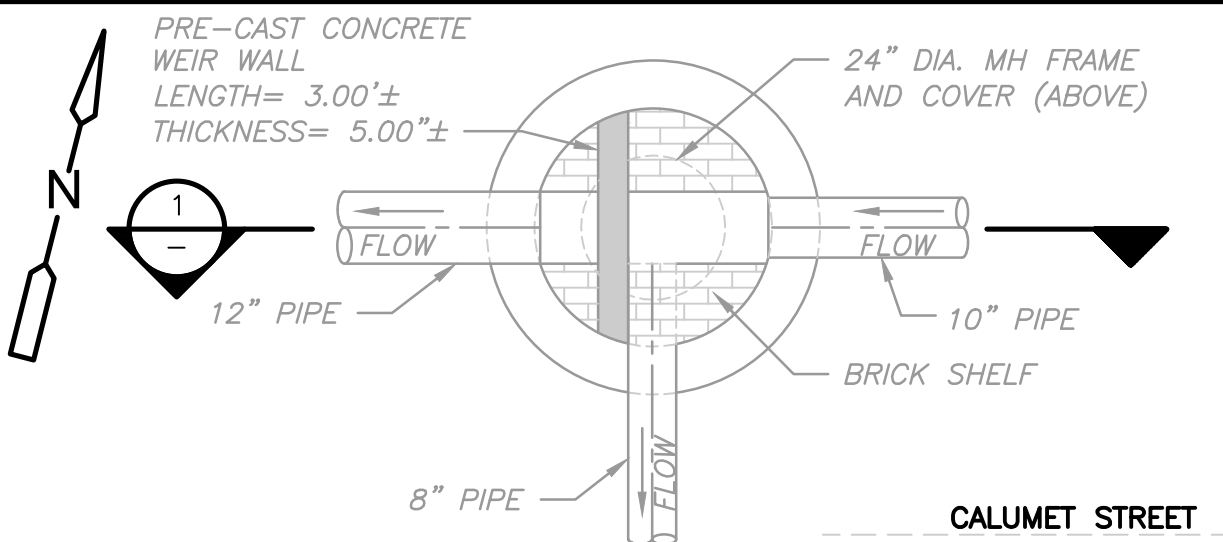

PLAN

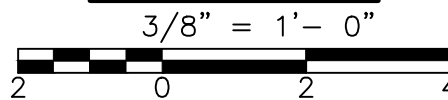

NOTE:
ELEVATIONS SHOWN ARE IN
NEW BEDFORD CITY DATUM.

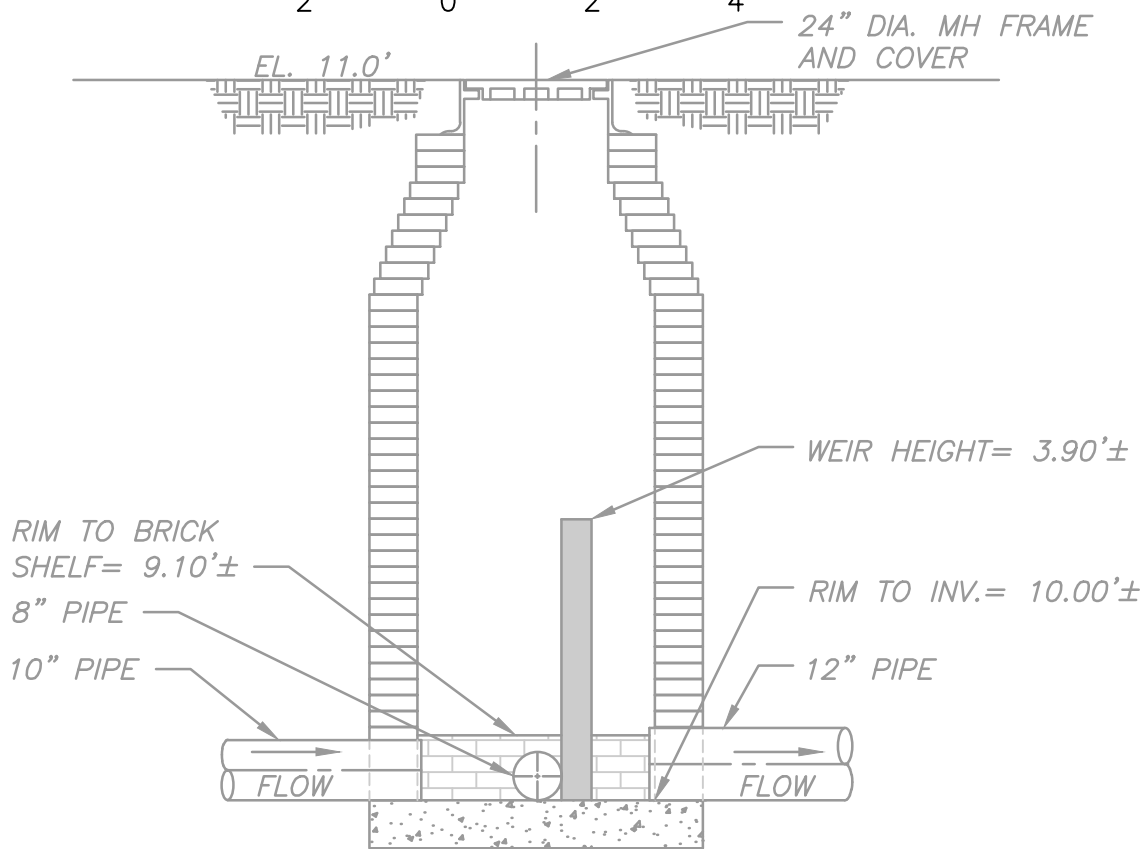

SECTION

3/8" = 1'-0"

