


New Bedford Regulator Specification Sheet


Regulator #: R-008A**Location:** 93 Calumet St.**Date:** 6/25/25

Structure Measurements


Structure Type: Single manhole**Rim Elevation (ft City Datum):** 11.0**Regulator Type:** Fixed Weir**Overflow Height (ft or in):** 3.9'**Rim to Top of Weir (ft):** 6.1**Weir Dims (ft or in):** Length: 3', Width: 5", Height: 3.90'**Influent pipe \varnothing (in):** 10**Rim to Influent Invert (ft):** 10**Dry Weather Connection \varnothing (in):** 8**Rim to Dry Weather Invert (ft):** 10**Overflow pipe \varnothing (in):** 12**Rim to Overflow Invert (ft):** 10

Sensor Measurements

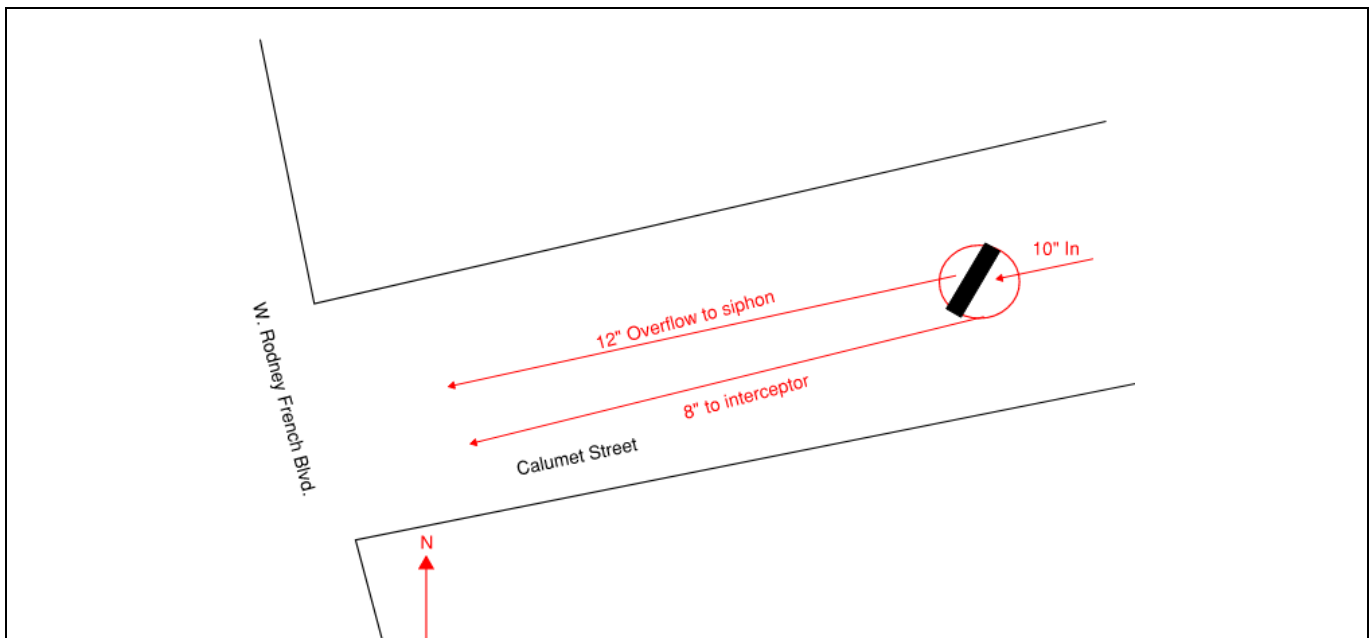
Block Present: Yes**Level Sensor Status:** Metered**Sensor Installation Date:** 10/14/2020**Intra-System Status:** No**Tide Gate Status:** None**Notes:****Location Sketch:**

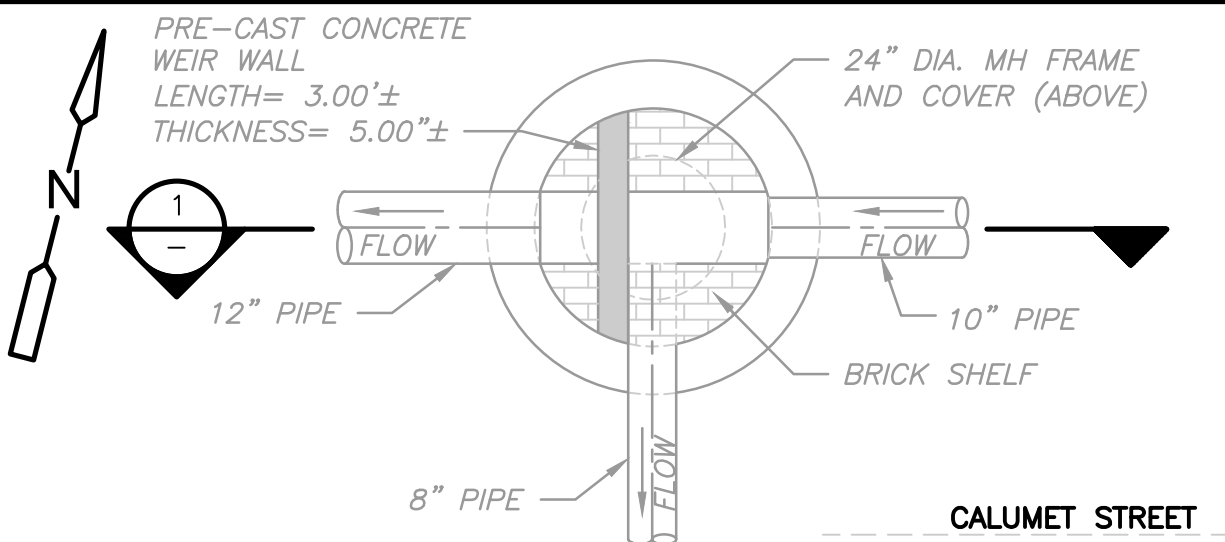

PLAN

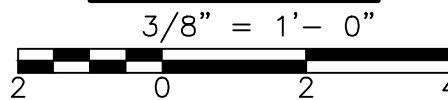


NOTE:
ELEVATIONS SHOWN ARE IN
NEW BEDFORD CITY DATUM.

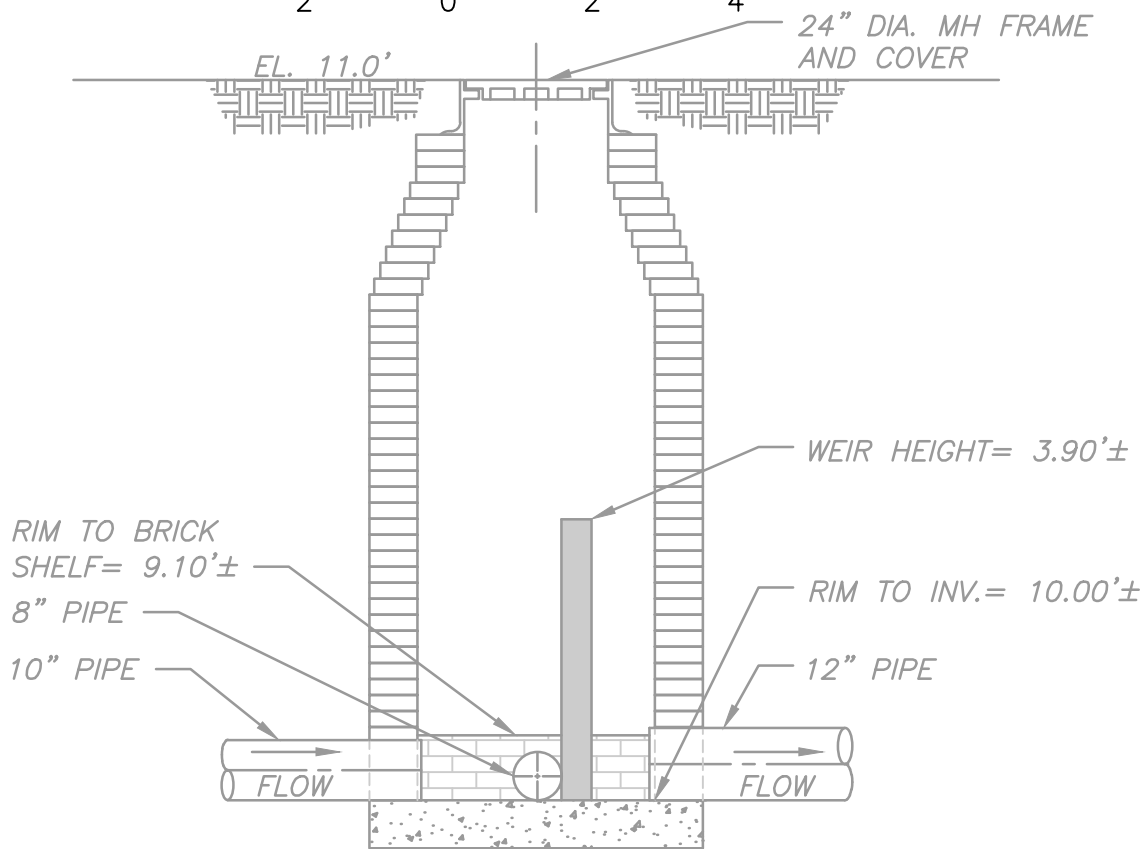

SECTION

3/8" = 1'-0"

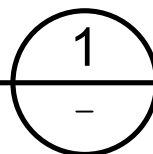



JOHN HALLIWELL MEMORIAL PARK

REGULATOR FIELD PHOTOS


Figure 1



Figure 2



Figure 3

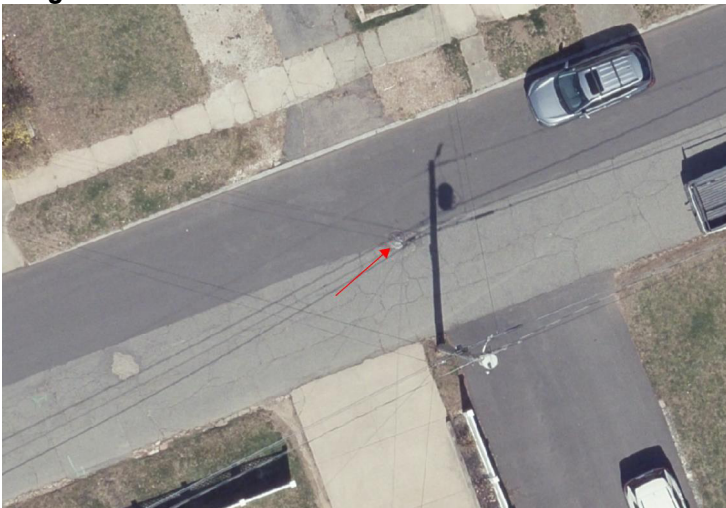

Descriptions:

Figure 1: Inside of R-008A. Inflow, weir, and overflow visible

Figure 2: Google Earth snapshot facing west along Calumet Street. Manhole marked in red.

Figure 3: Aerial location with arrow pointing to corresponding manhole.