



CONCRETE WEIR WALL
LENGTH= 3.33'±
THICKNESS= 4.00"±

12" PIPE

6" LATERAL

FLOW

BELLEVUE
STREET

10" PIPE

24" DIA. MH FRAME
AND COVER (ABOVE)

CONCRETE SHELF

10" PIPE




PLAN

3/8" = 1' - 0"



NOTE:

ELEVATIONS SHOWN ARE IN
NEW BEDFORD CITY DATUM.

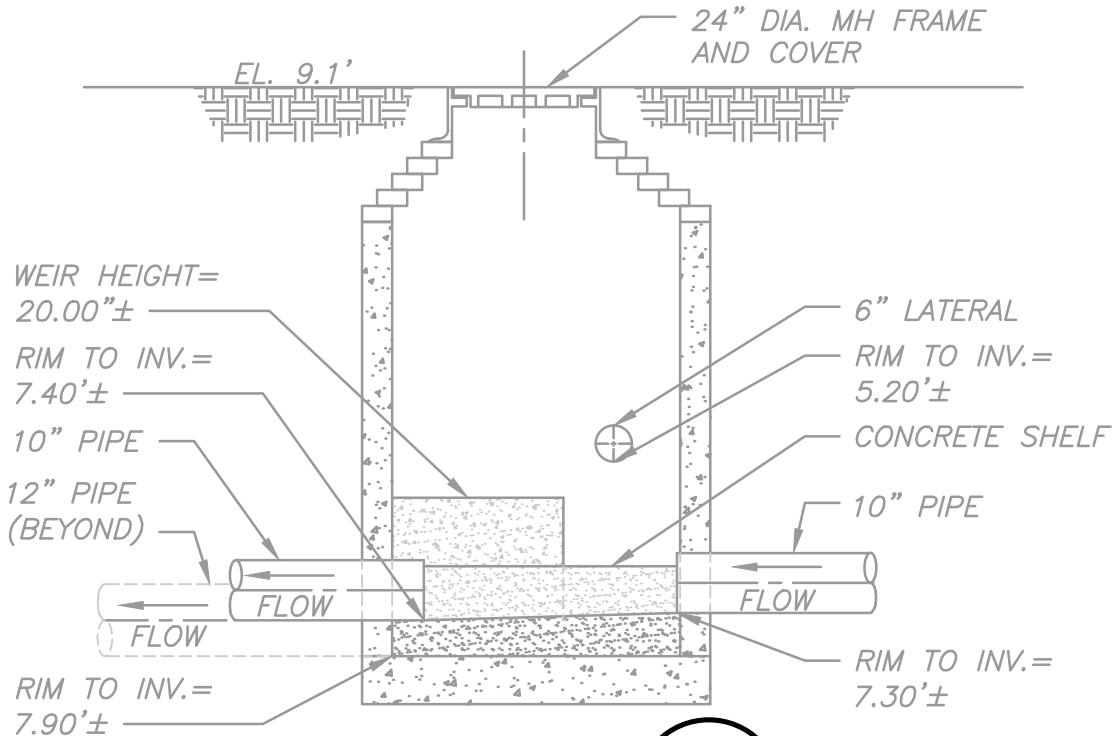

SECTION

3/8" = 1' - 0"

