

# CSO SPEC SHEET

Structure #: REG 010 A

Date: 08/ 23 / 2012  
Insp. By: AH and AK

Location: West of the Intersection of Rodney French Blvd and Bellevue St.

Structure Type: Cast Iron

Structure DIM's: \_\_\_\_\_

Size of Sewer Pipe: 10"

Size of Storm Drain Pipe: 10"

Sewer Direction: East to South

Regulator Type: Weir Wall/ Block Regulator

Weir Dim's: \_\_\_\_\_

Rim to Top of Weir: 5.7'

Rim to Storm Drain Invert: 7.9'

Rim to Top of Sewer (Normal Flow): 7.4'

Free Board: 1.7'

Over All Rating: (Circle One)

Poor

Fair

Good

Excellent

Comments: No Repairs needed.

Field Sketch:





## CSO FIELD PHOTOS

Structure#: REG 010 A

Location: West of the Intersection of Rodney French Blvd and Bellevue St.

Figure 1.



Figure 2.

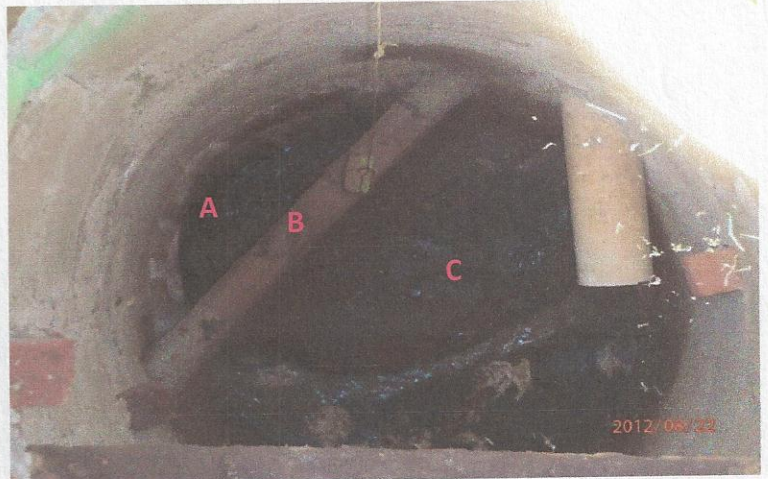


Figure 3.



Figure 4.



### Descriptions


**Figure 1:** View of Regulator 010 A. Facing North.

**Figure 2:** Inside view of manhole. A-Storm Drain; B- Weir Wall; C- Sewer.

**Figure 3:** Street view of Regulator 010 A. Facing Clark's Cove.

**Figure 4:** Google Earth image of Regulator 010A. A- REG 010A; B- CSO 010 outfall pipe.



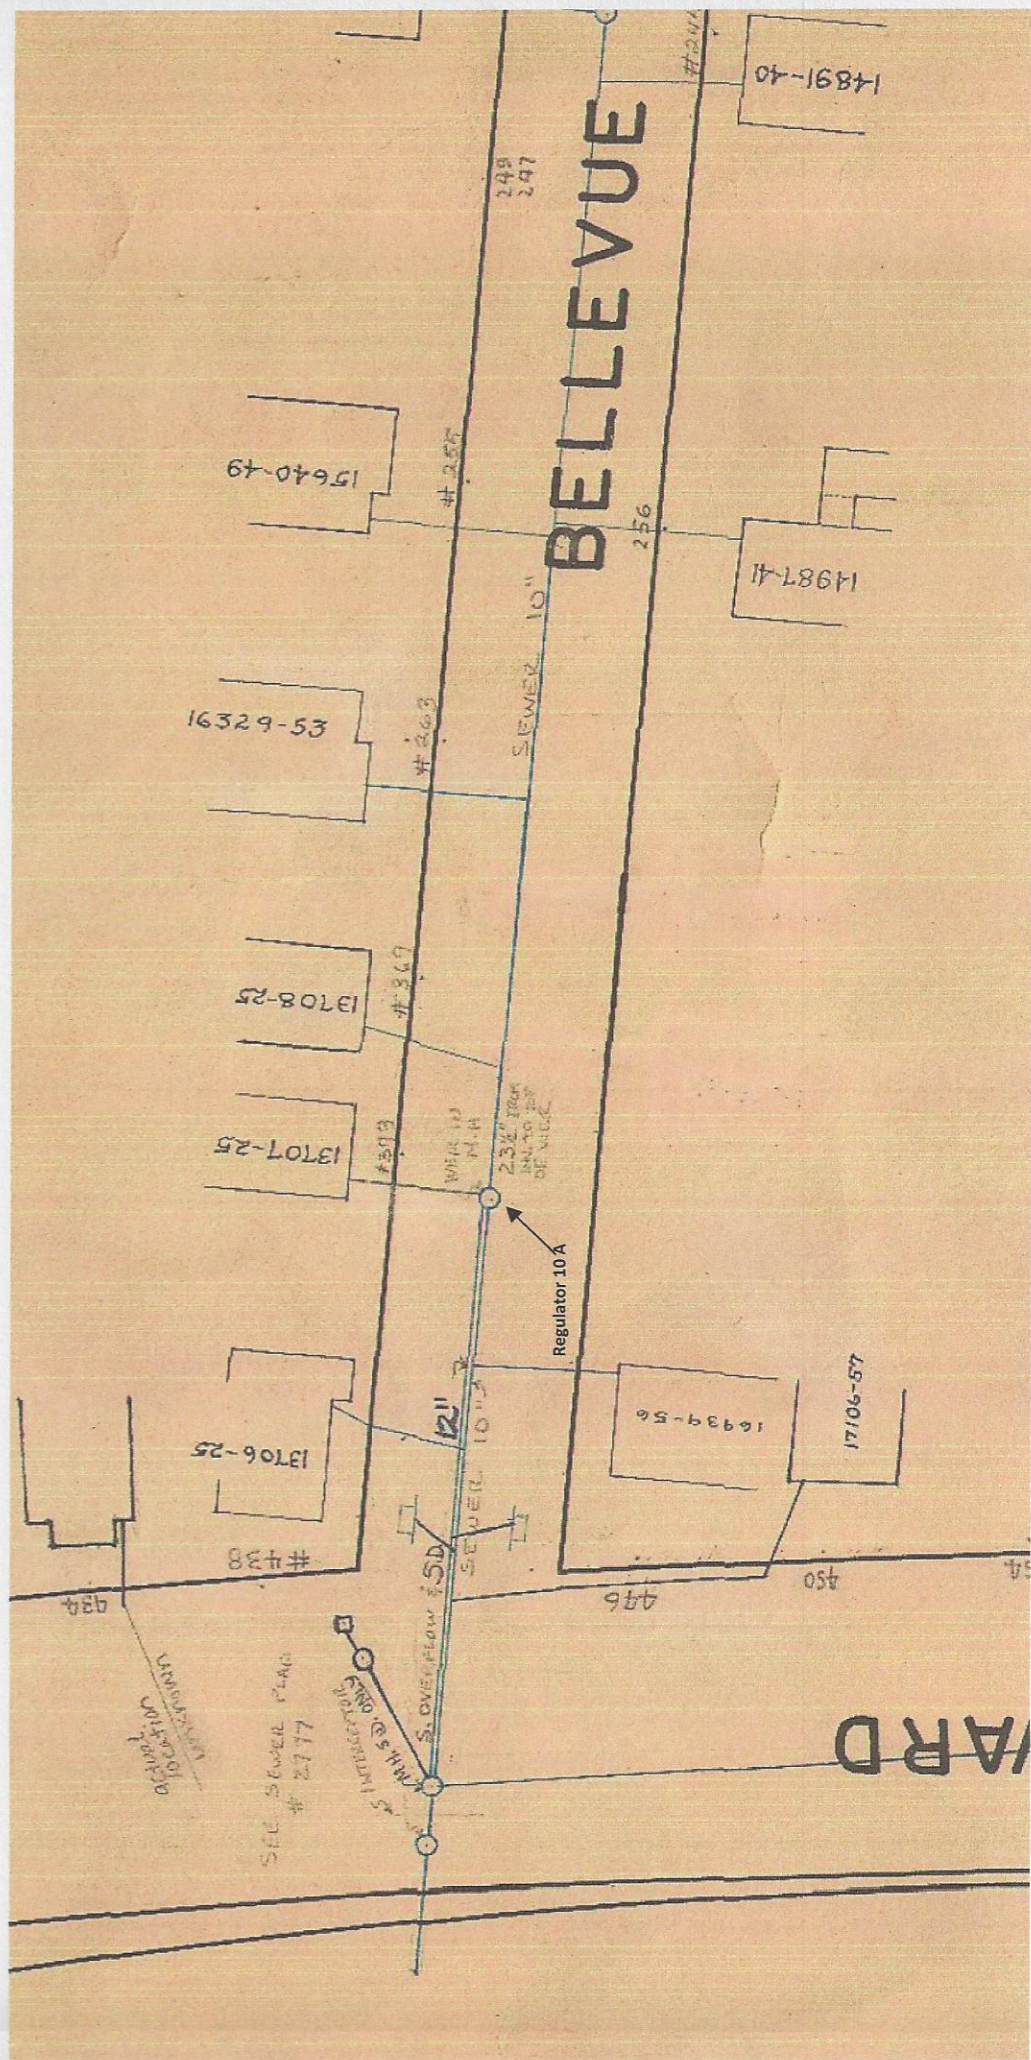



## CSO/Regulator Repair Log

Structure #: Reg 010 A

[illegible]