


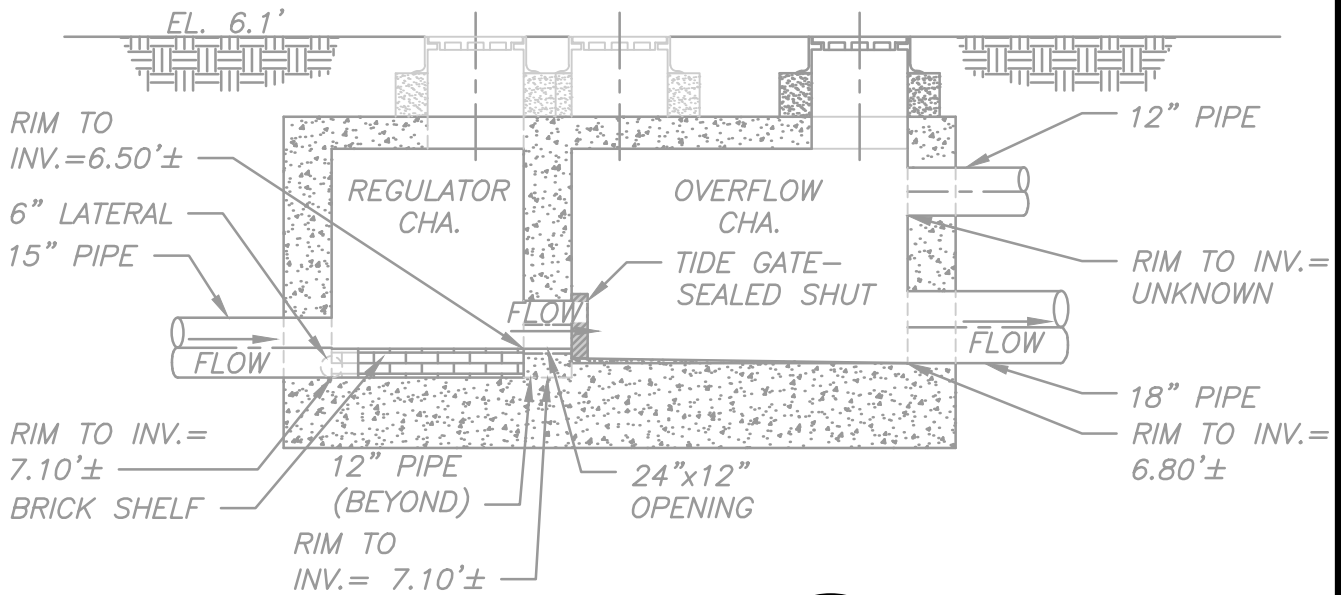


SECTION 1

1/4" = 1'-0"

1

SH.1

24" DIA. MH FRAME AND COVER (TYP.)

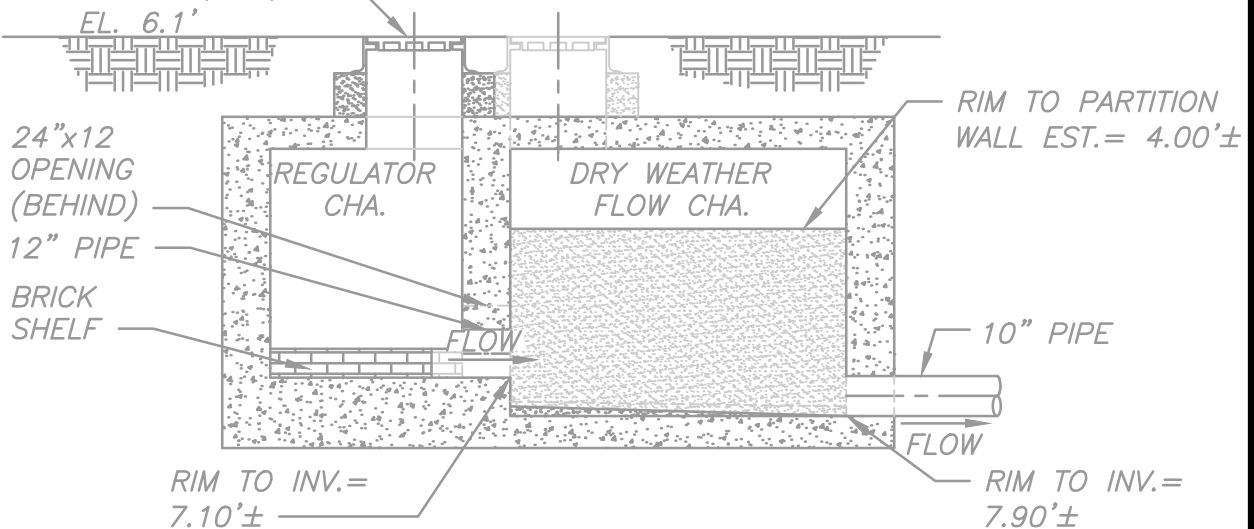

SECTION 2

1/4" = 1'-0"

2

SH.1

NOTES:

1. ELEVATIONS SHOWN ARE IN NEW BEDFORD CITY DATUM.
2. ONLY REGULATOR CHAMBER SCANNED IN 2023. OTHER DIMENSIONS ESTIMATED FROM RECORD DRAWING SEE 6639A - ROD FR BLVD.

