




See 4B- Clarkes Point Sep (Sht 45)

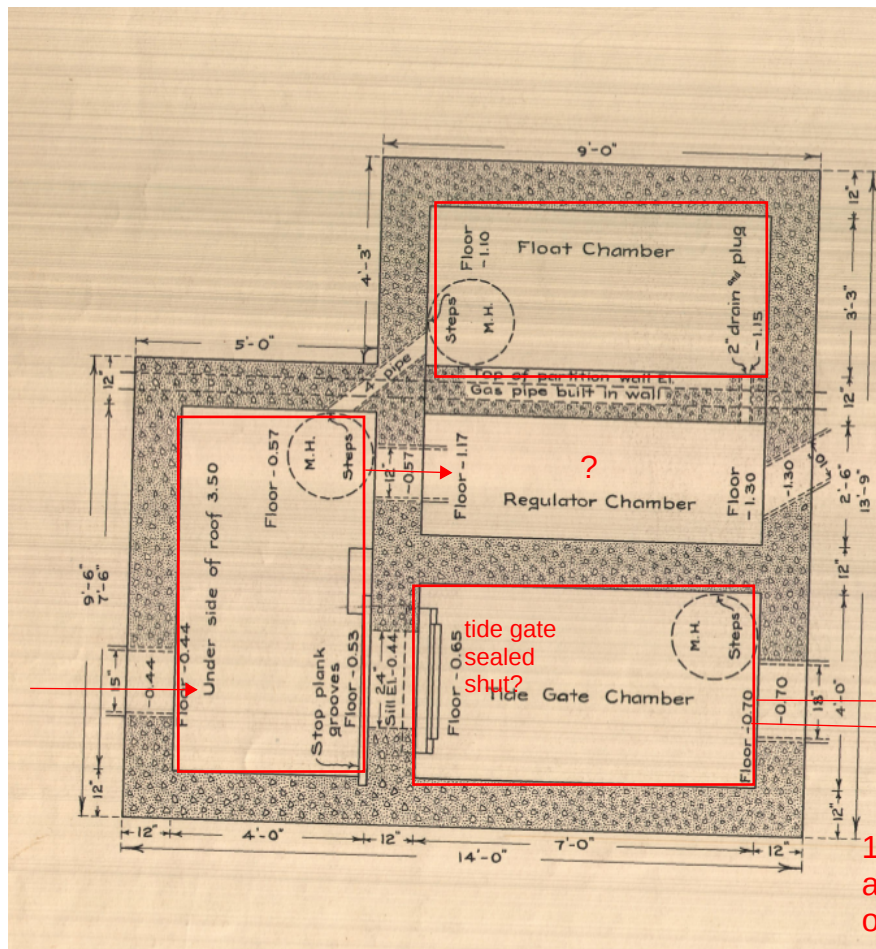