


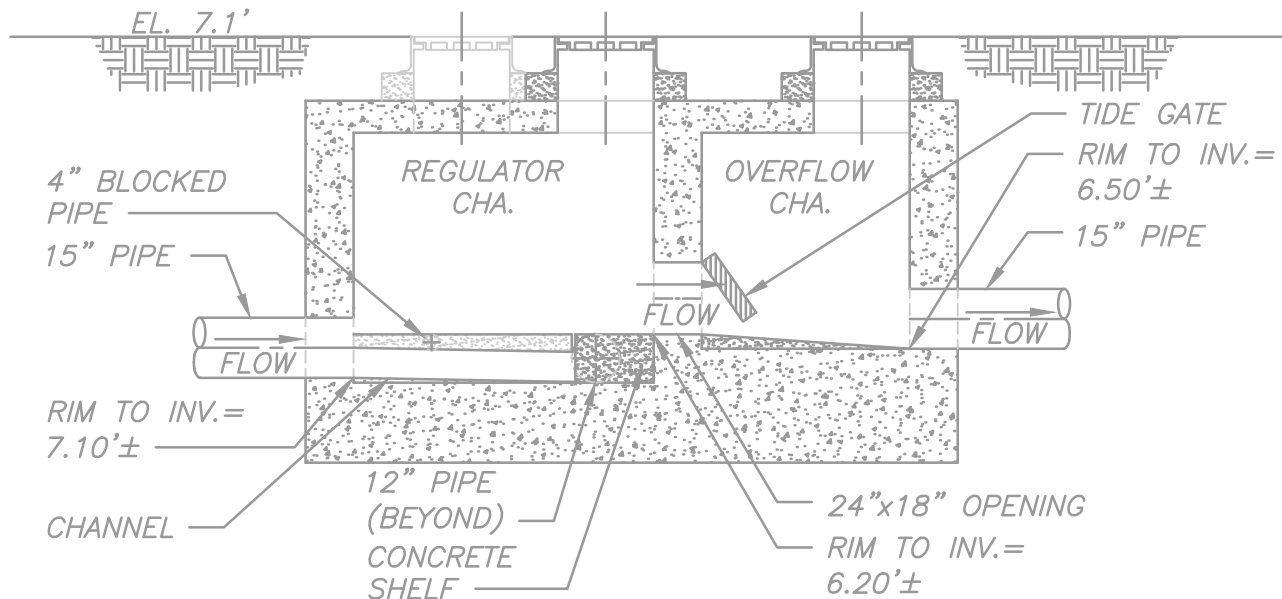


SECTION

1

1/4" = 1'-0"

SH.1

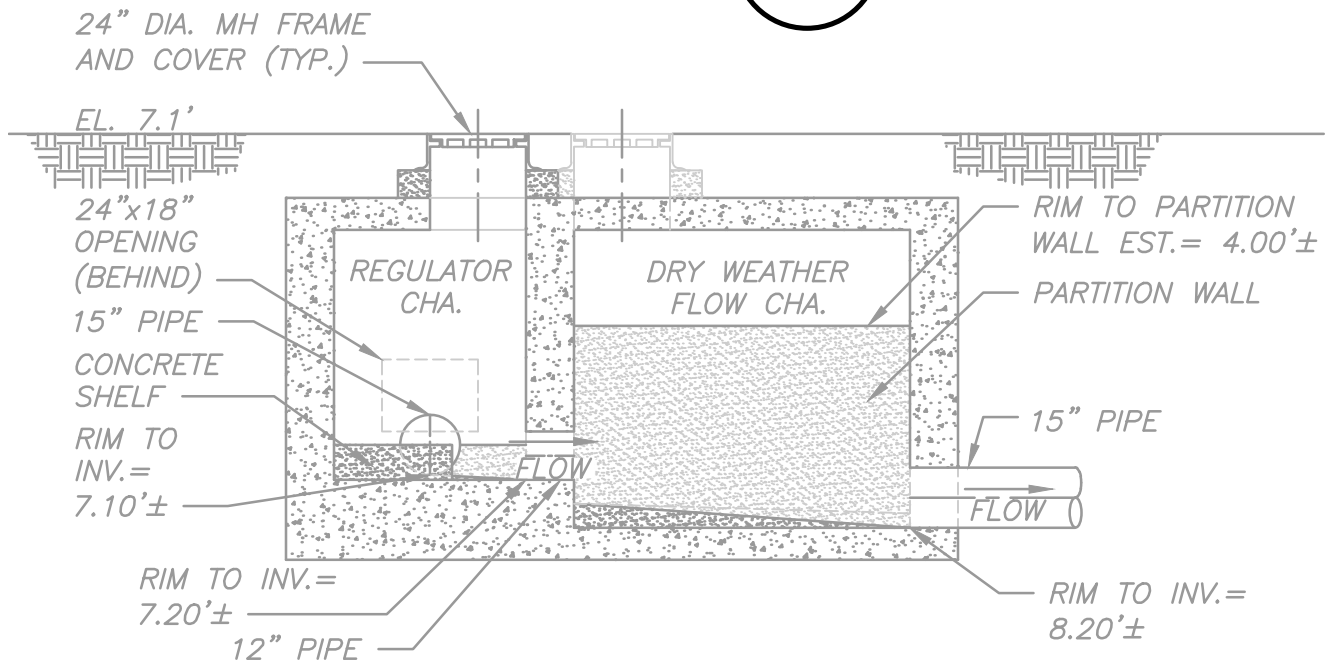

SECTION

2

1/4" = 1'-0"

SH.1

NOTES:

1. ELEVATIONS SHOWN ARE IN NEW BEDFORD CITY DATUM.
2. ONLY REGULATOR CHAMBER SCANNED IN 2023. OTHER DIMENSIONS ESTIMATED FROM RECORD DRAWING SEE 6639A - ROD FR BLVD.

