

CSO SPEC SHEET

Structure #: REG 013 A

Date: 08/28/2012

Insp. By: AH and AK

Location: At the Intersection of East Rodney French Blvd and Aquidneck St.

Structure Type: Pour in place

Regulator Type: Float / Weir wall

Structure DIM's: _____

Weir Dim's: _____

Size of Sewer Pipe: 15"

Rim to Top of Weir: 6.2'

Size of Storm Drain Pipe: 15"

Rim to Storm Drain Invert: 6.2'

Sewer Direction: West to North

Rim to Top of Sewer (Normal Flow): 7.0'

Free Board: 0.8'

Over All Rating: (Circle One)

Poor


Fair

Good

Excellent

Comments: No repairs needed.

Field Sketch:

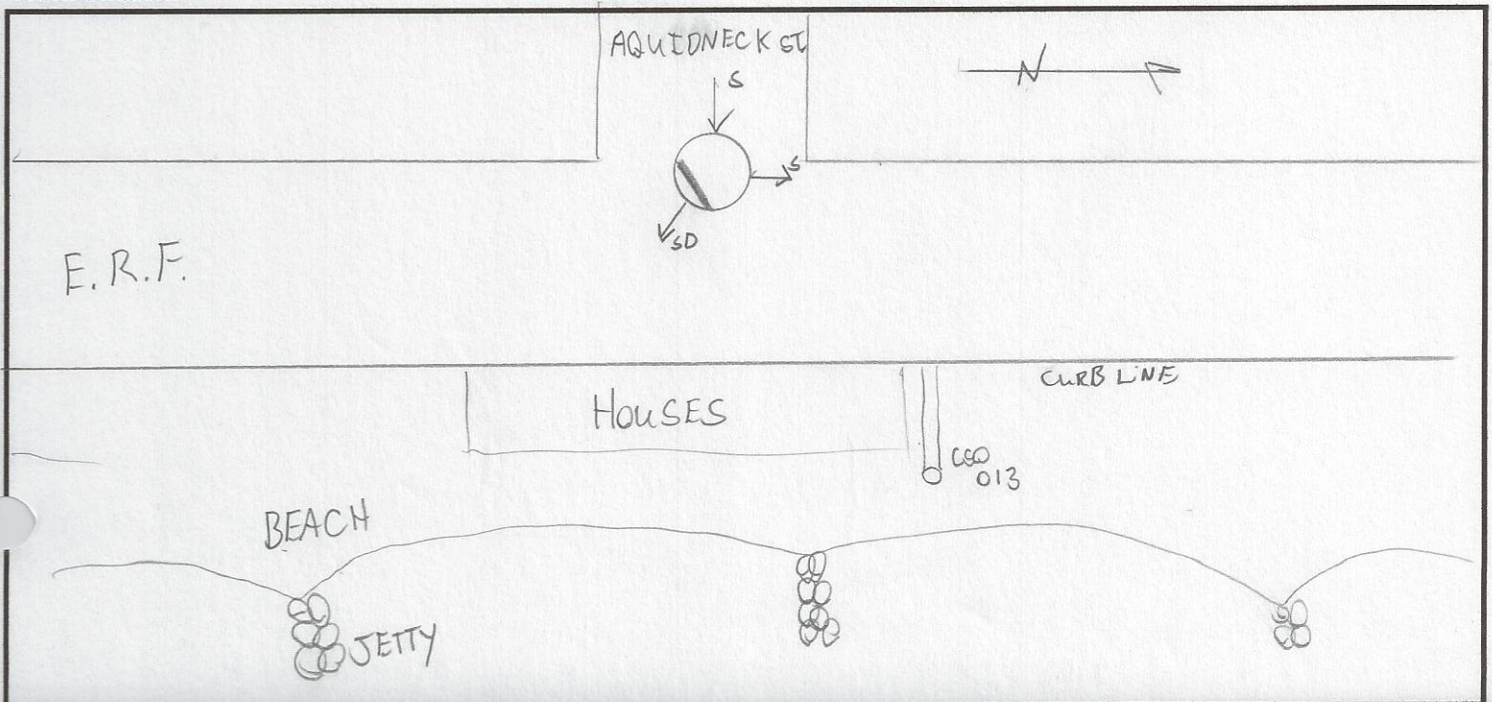

CSO FIELD PHOTOS

Structure#: REG 013 A

Location: At the Intersection of Aquidneck St and East Rodney French Blvd.

Figure 1.




Figure 2.



Figure 3.



Figure 4.

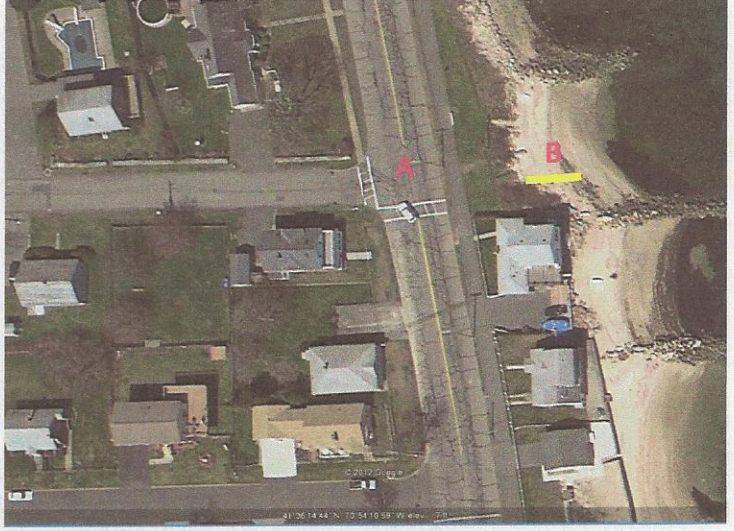


Descriptions

Figure 1: View of Regulator 013 A. Facing North.

Figure 2: Inside view of manhole. A- Storm Drain; B- Sewer; C Weir wall/ Block Regulator.

Figure 3: Street view of Regulator 013 A. Facing the Acushnet River.

Figure 4: Google Earth Image of location of Regulator 013 A. A- Reg 013 A; B- CSO 013 pipe outlet.

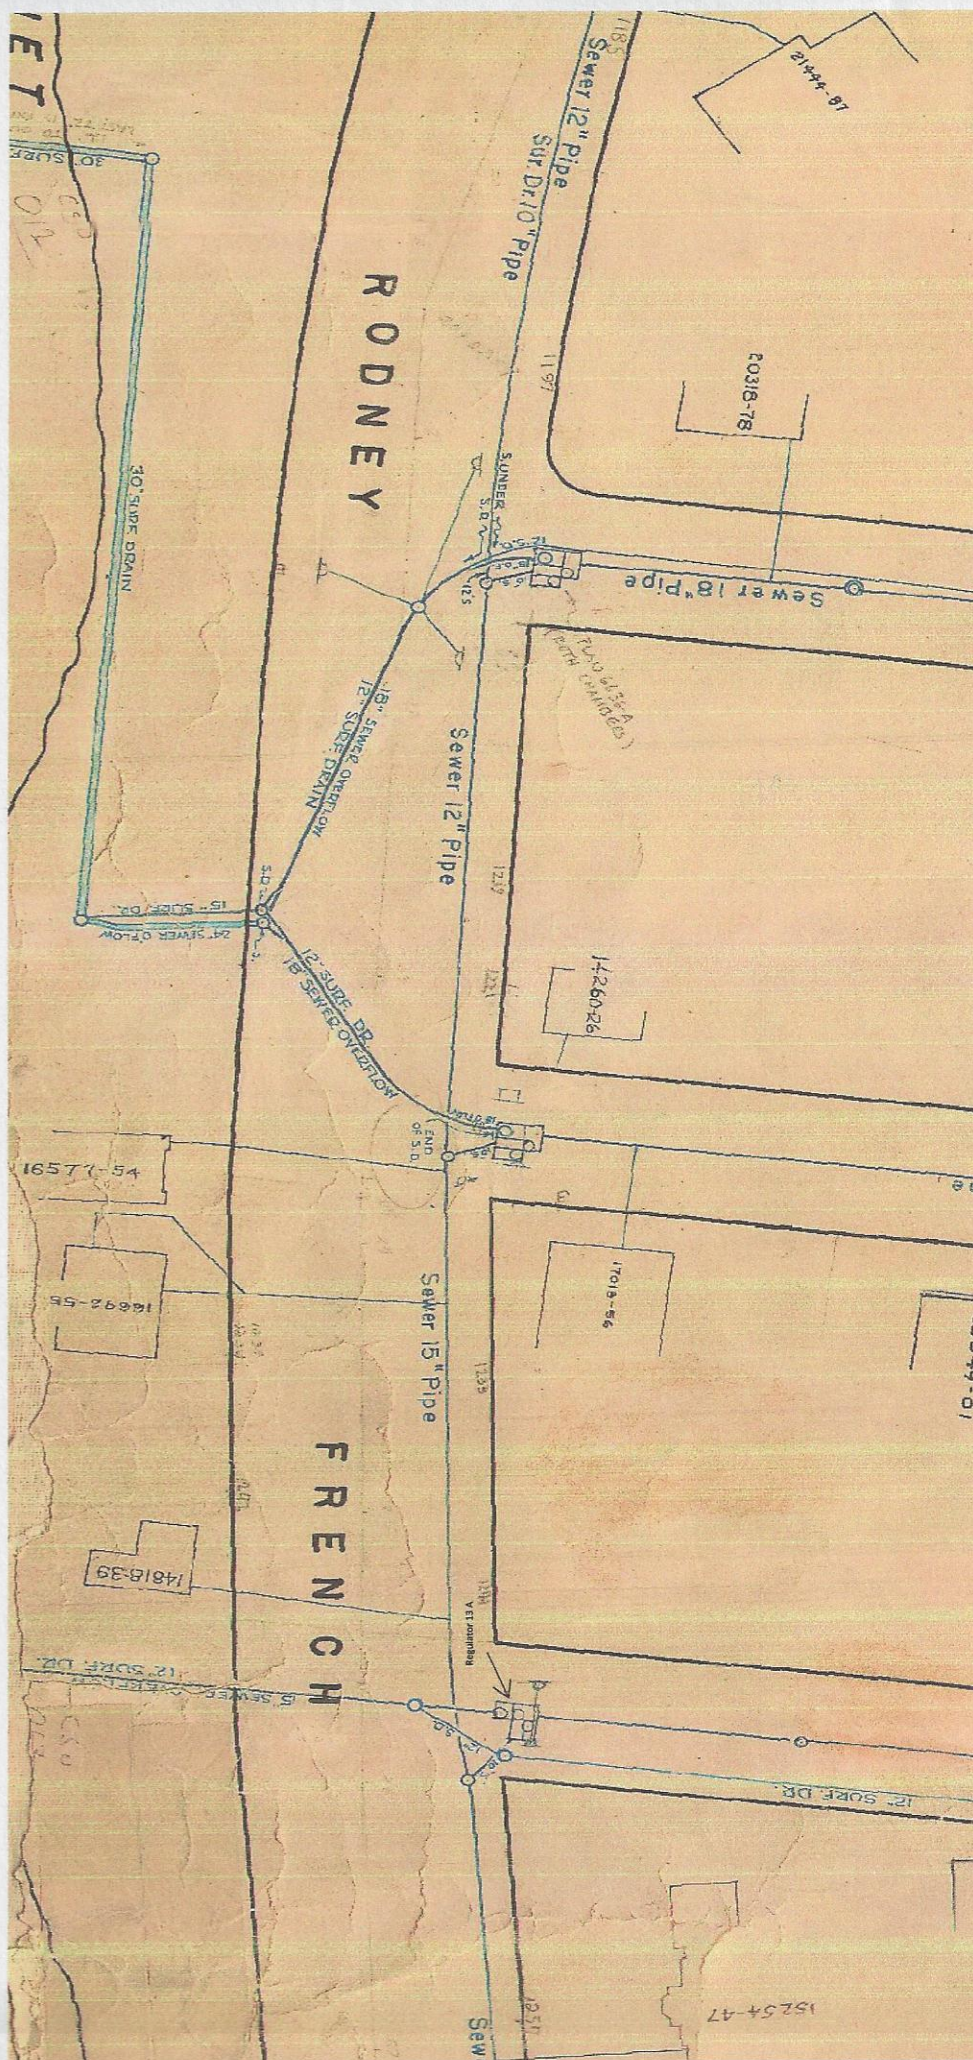

CSO/Regulator Repair Log

Structure #: C50 013A

[illegible]