




R-013A

Notes by Grace
Inman, CDM Smith
based on 12/13/2024
Field Investigation

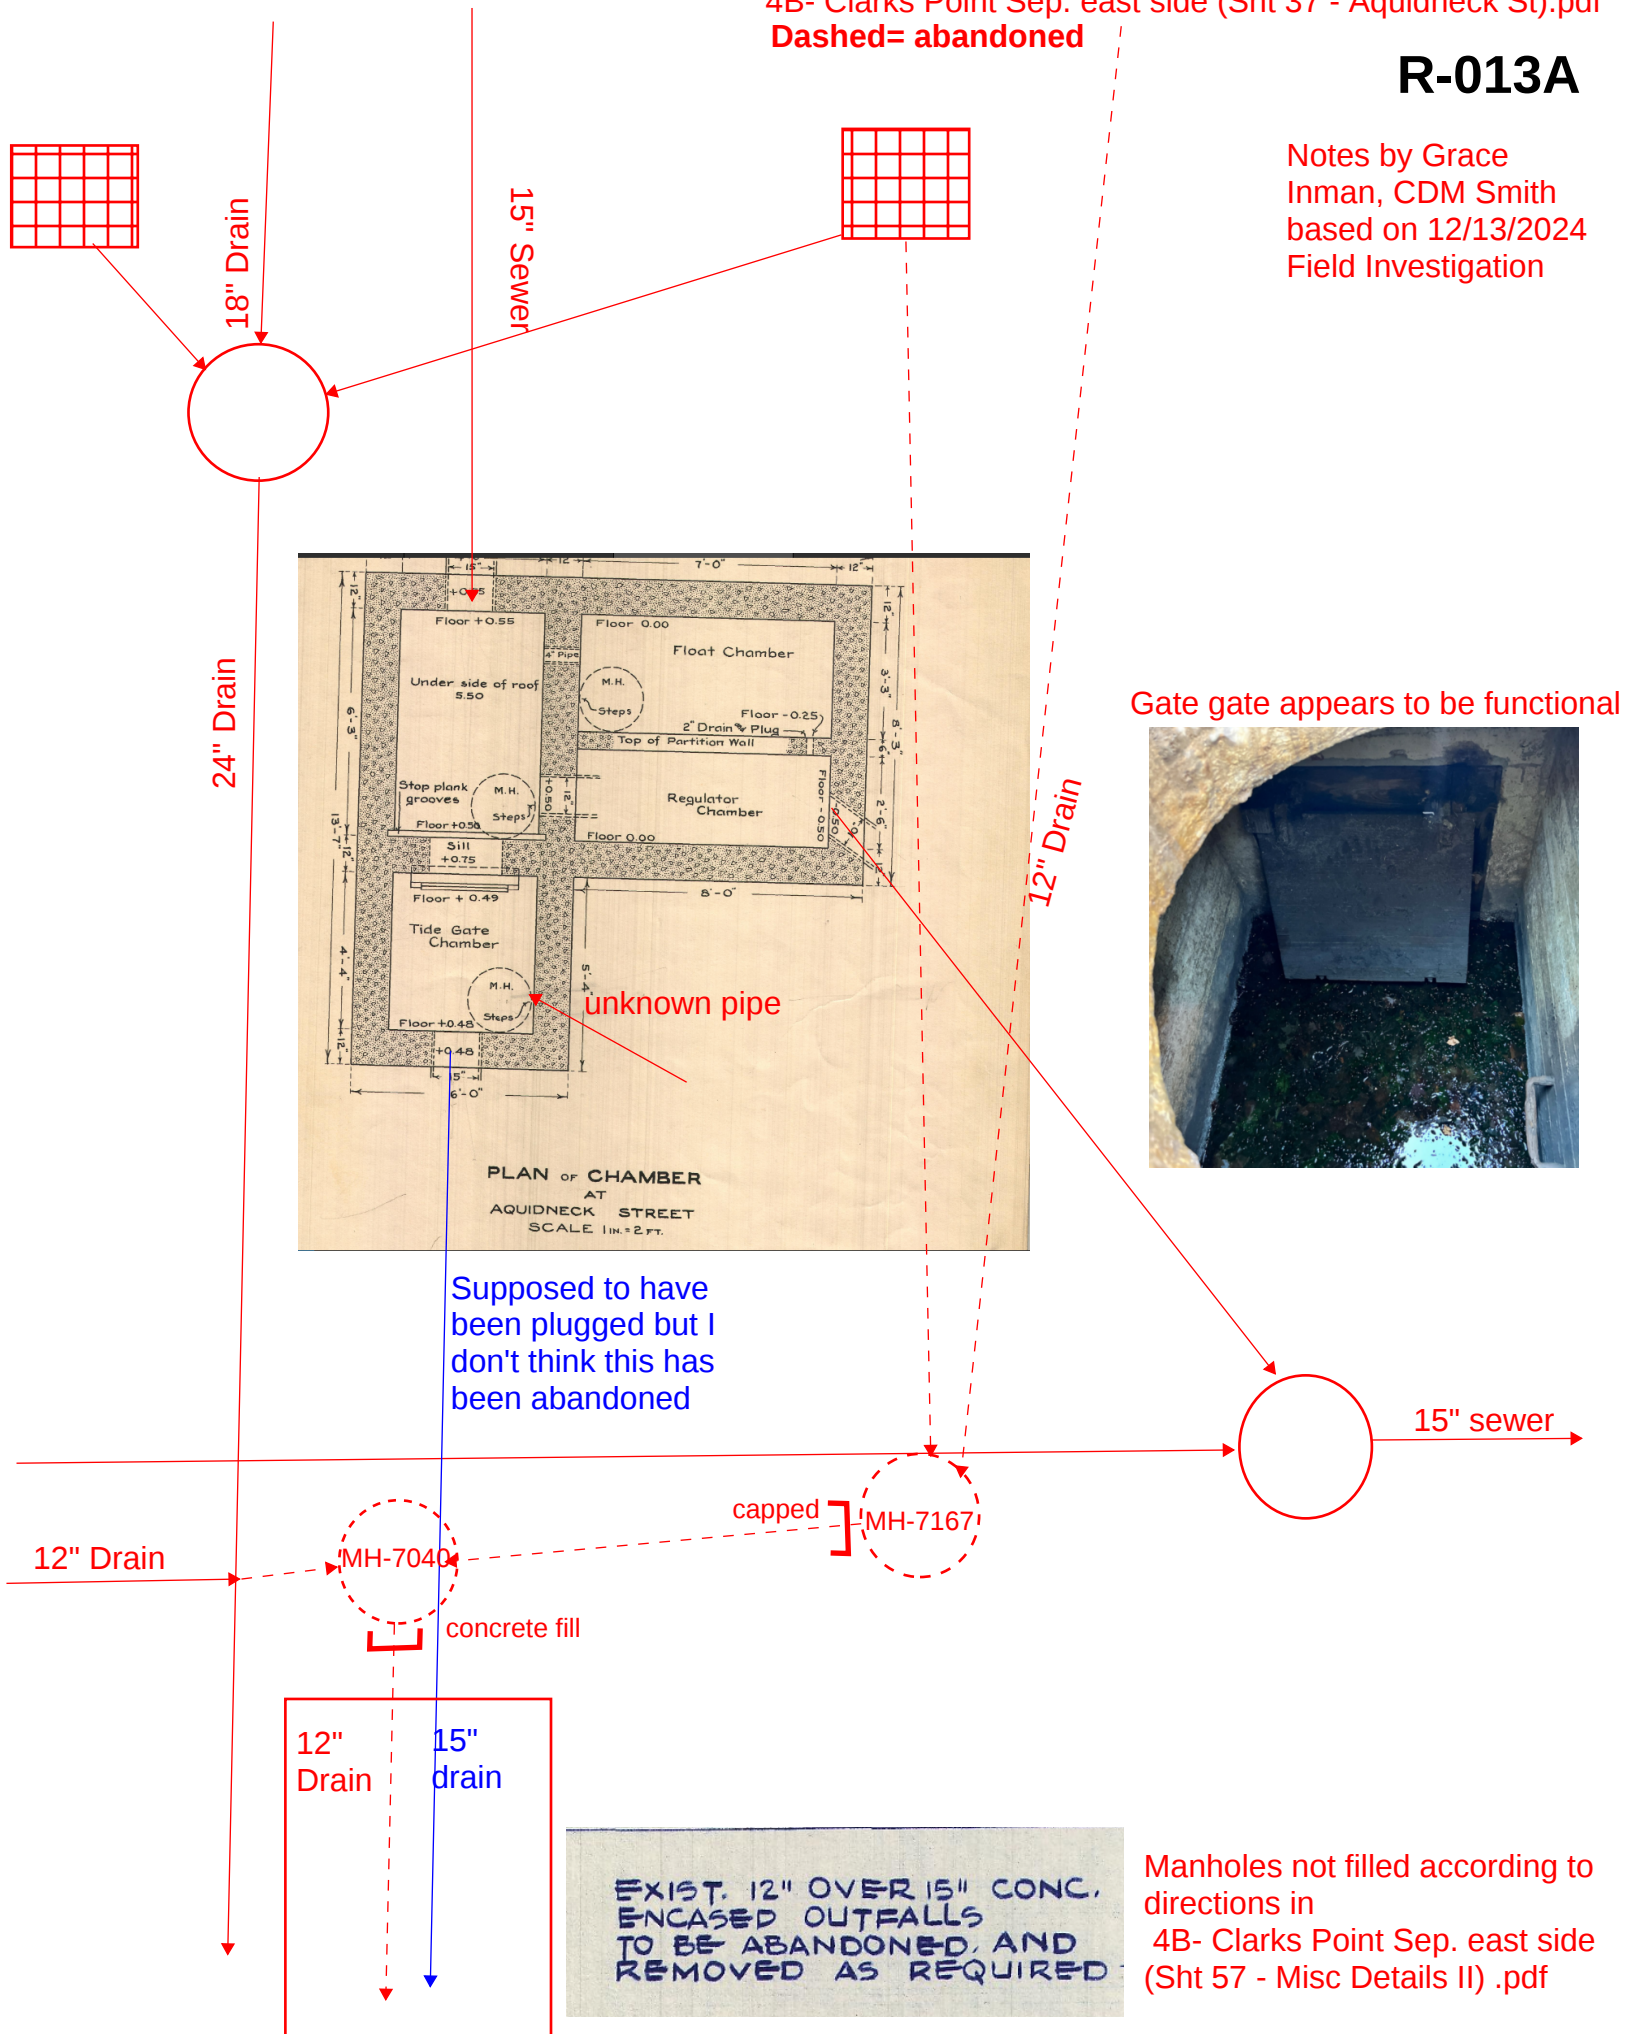


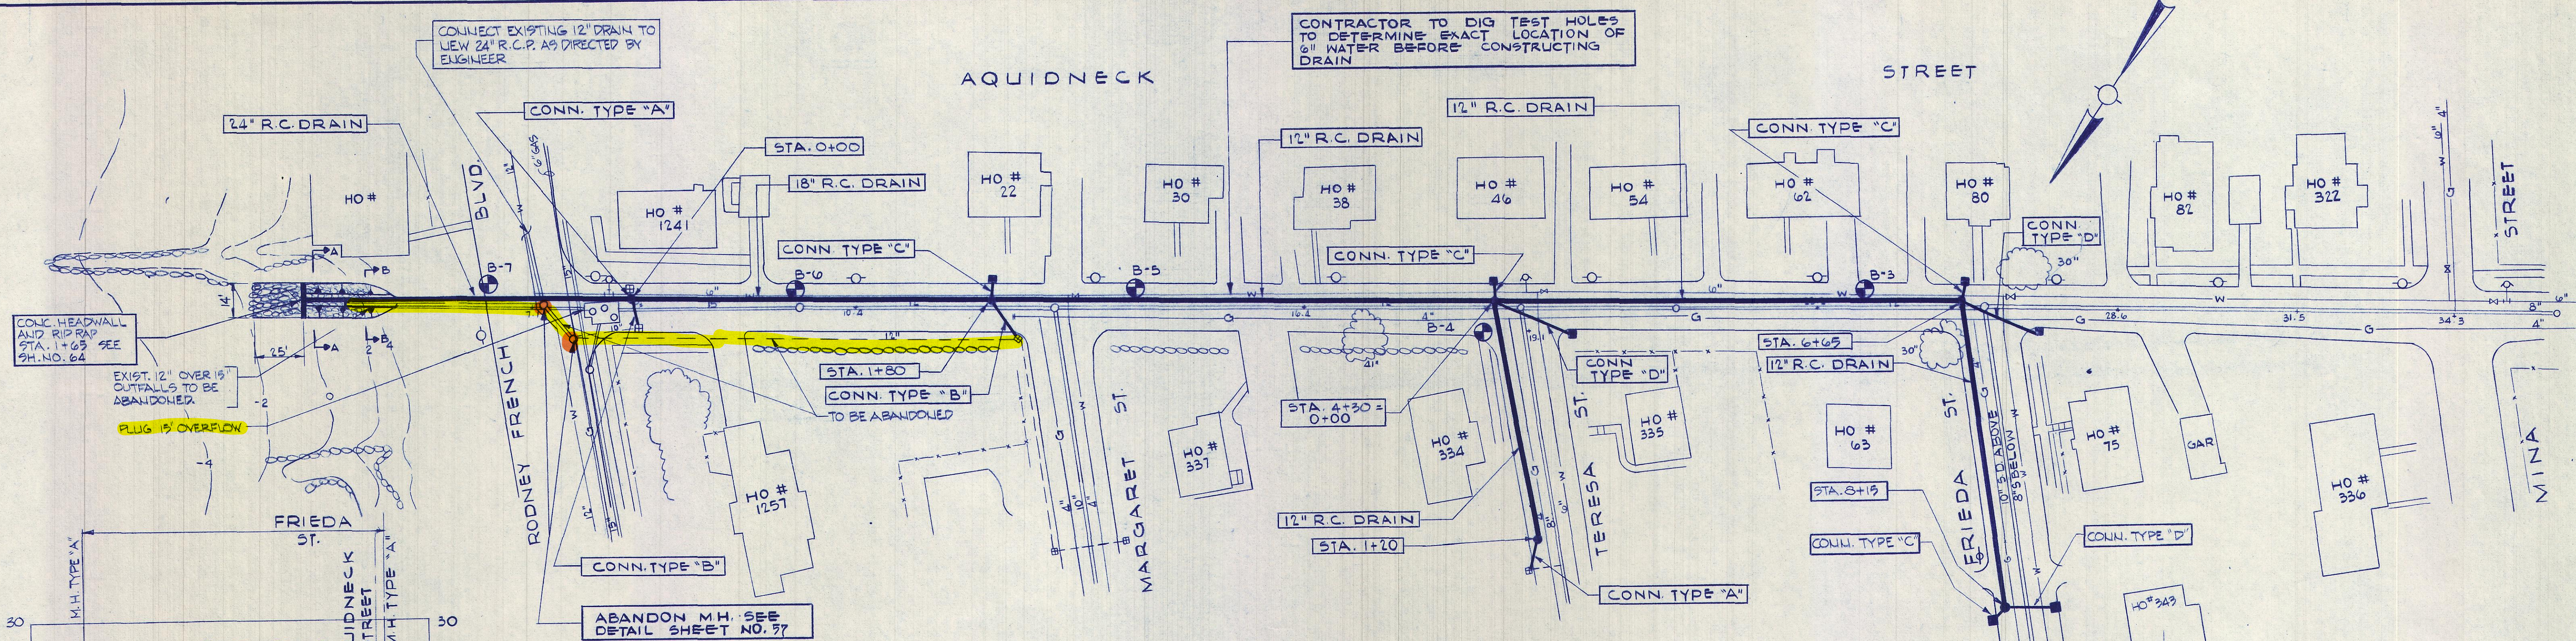



PLAN
SCALE: 1" = 40'

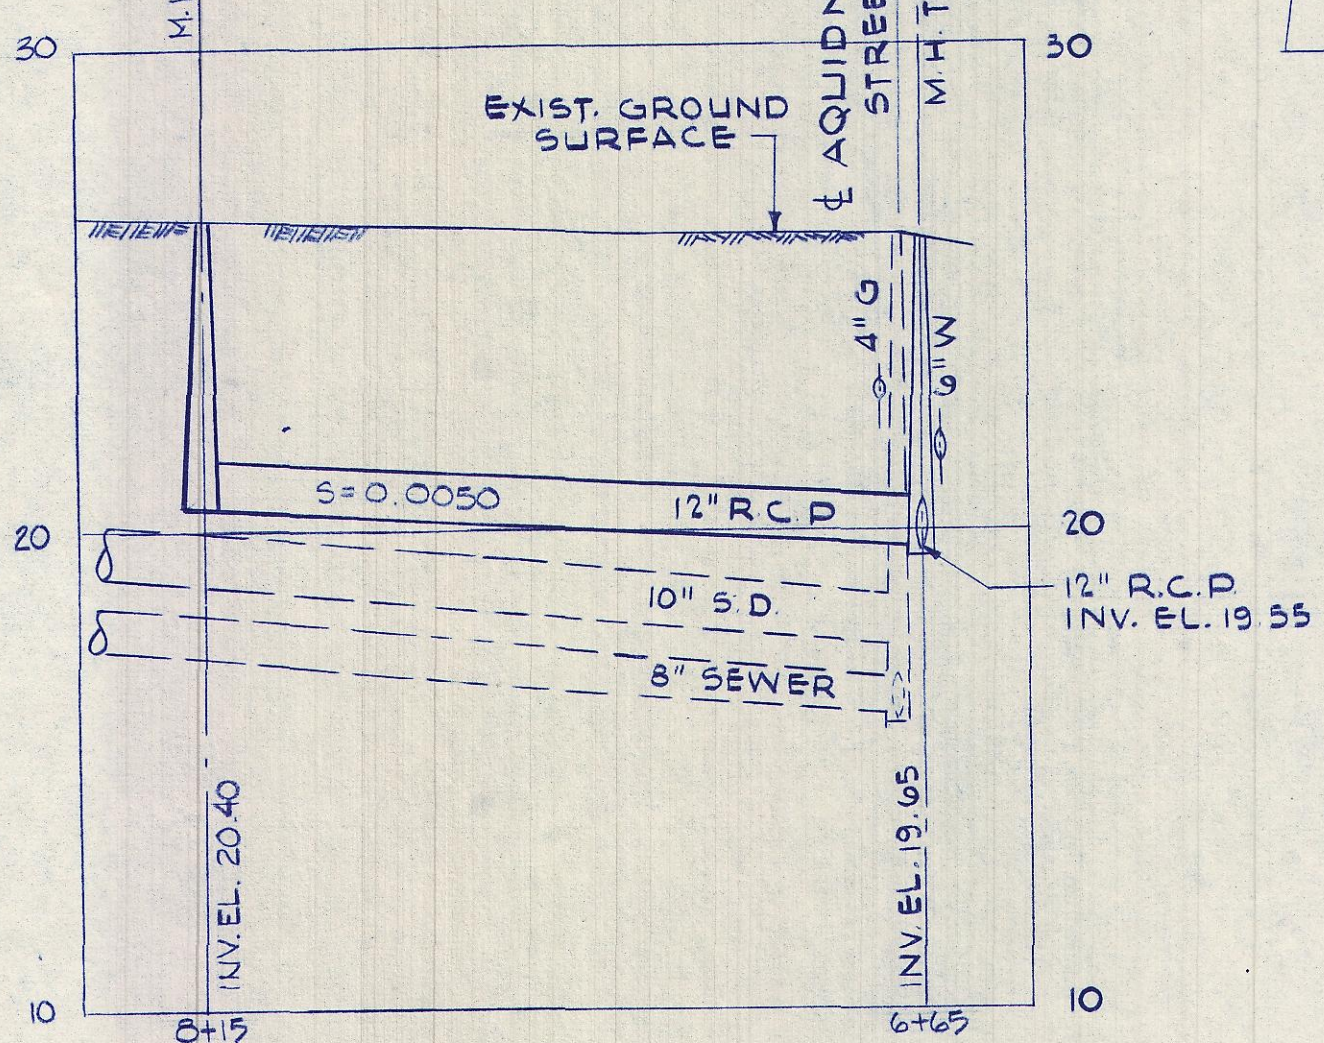


PROFILE
SCALE: HOR. 1" = 40'
VERT. 1" = 4'

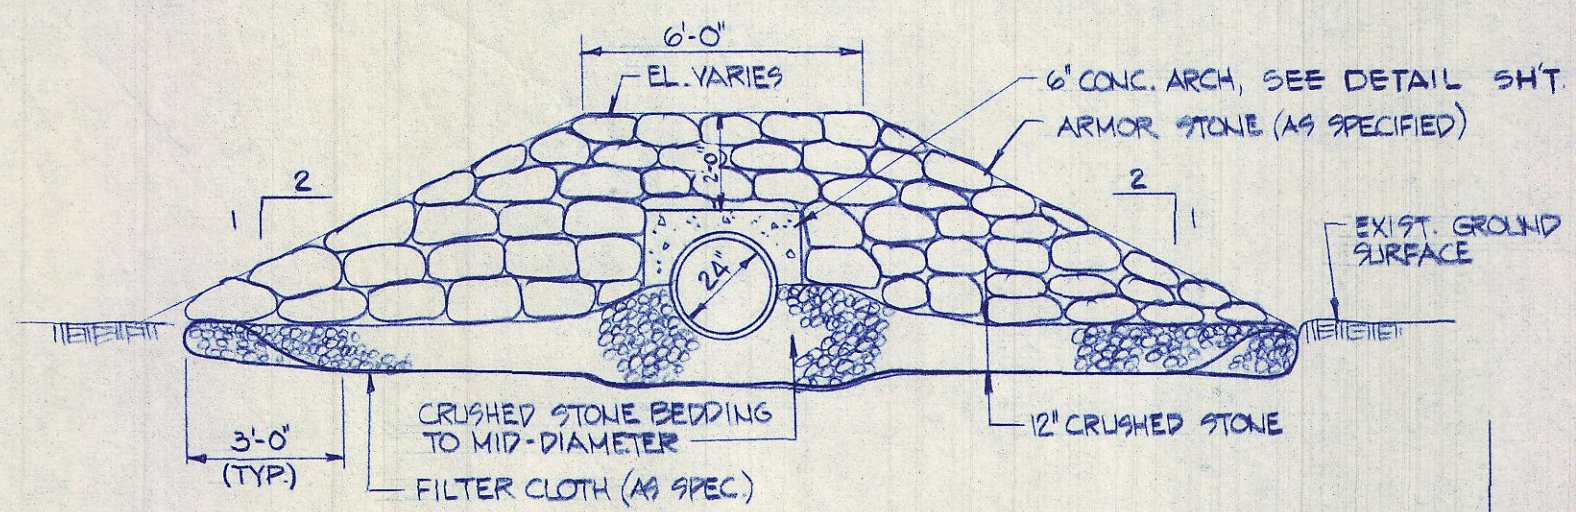

SECTION A-A
SCALE: 1/4" = 1'-0"

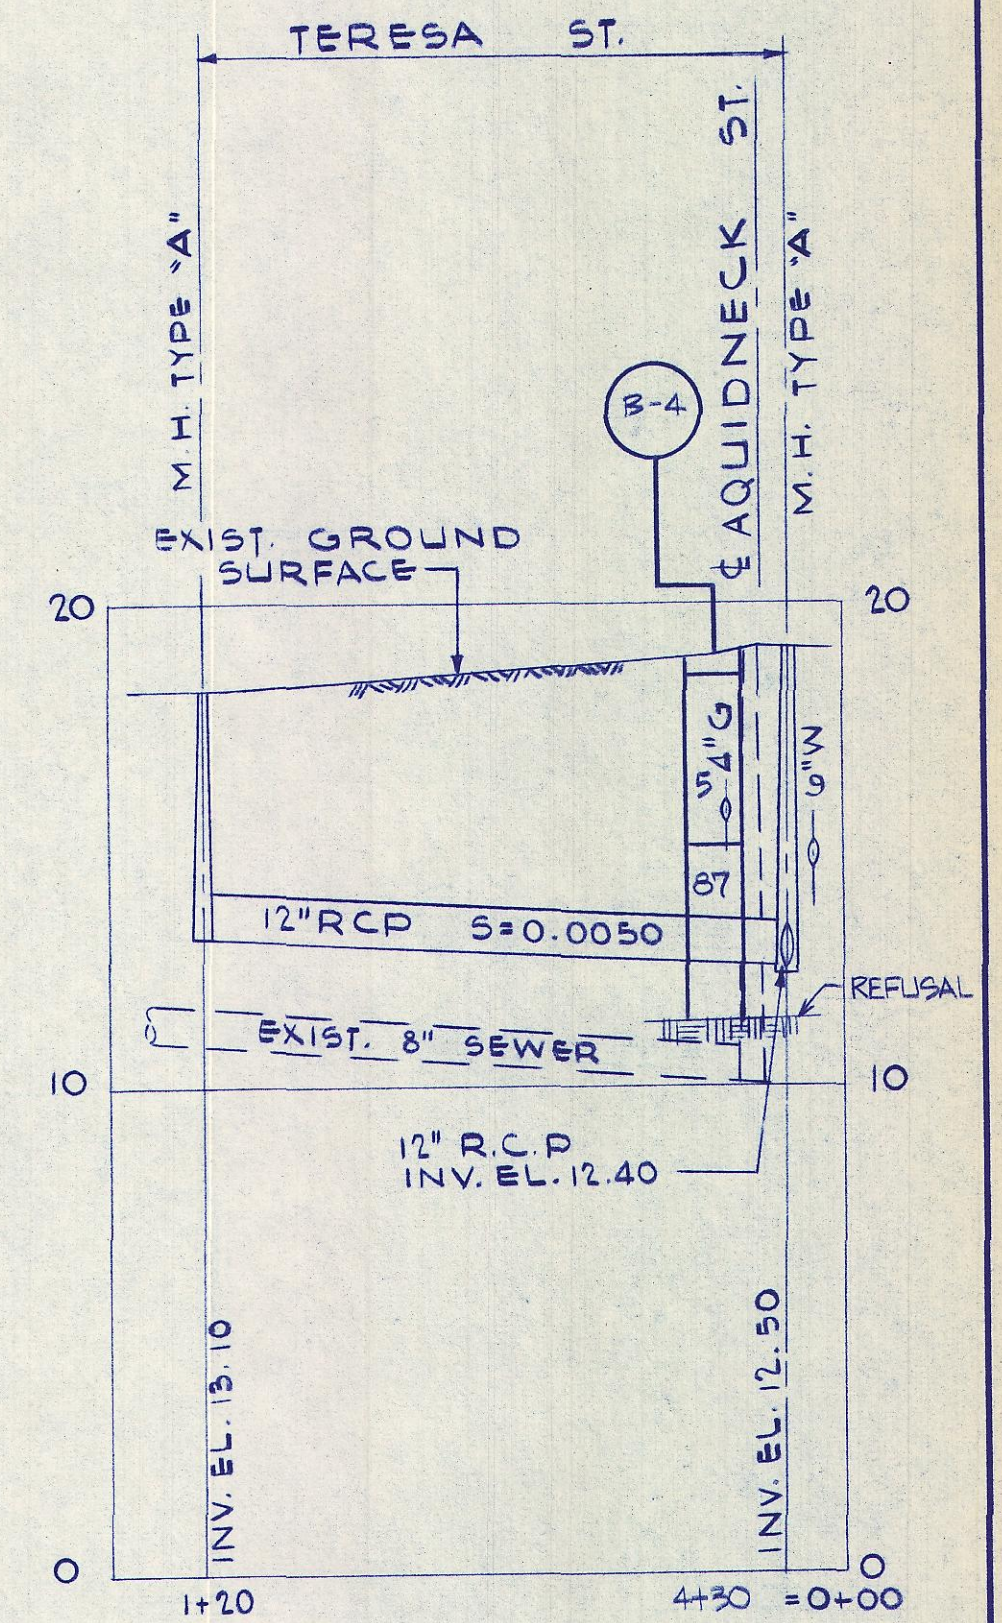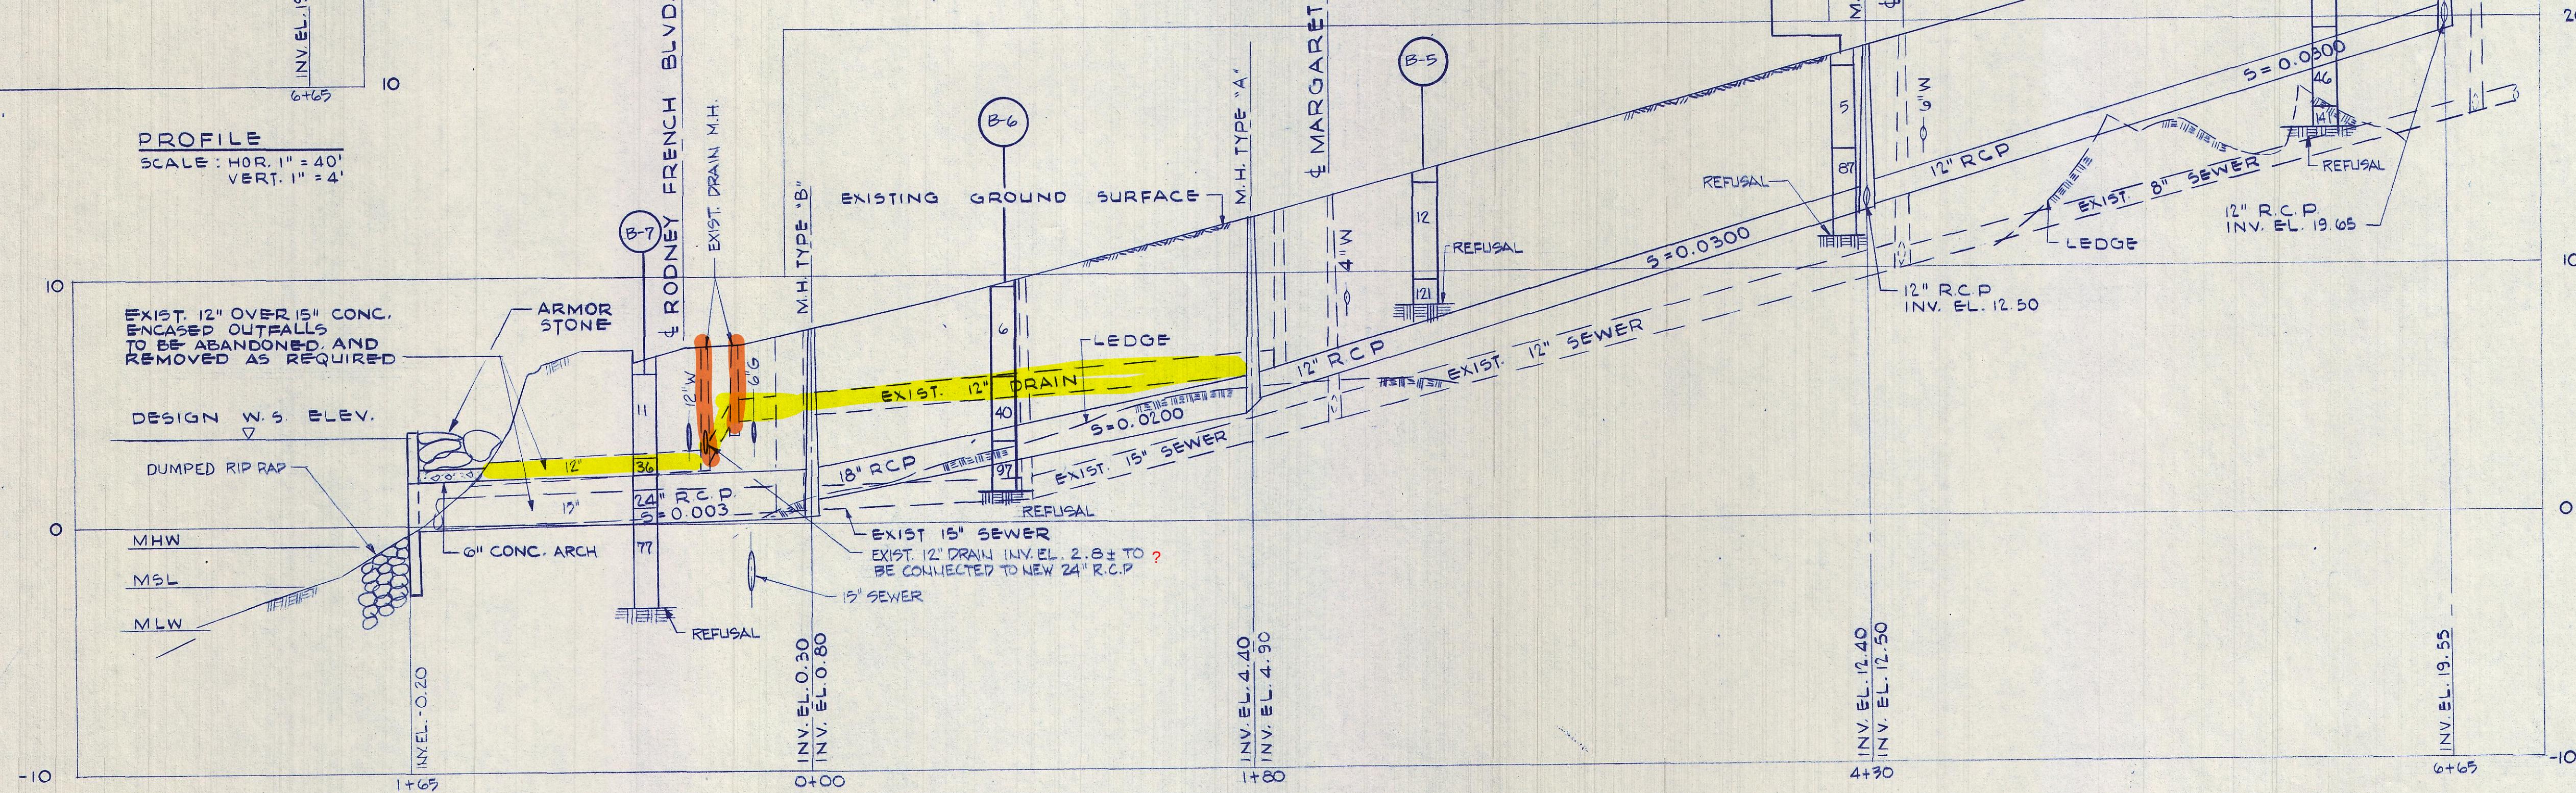

PROFILE
SCALE: HOR. 1" = 40'
VERT. 1" = 4'

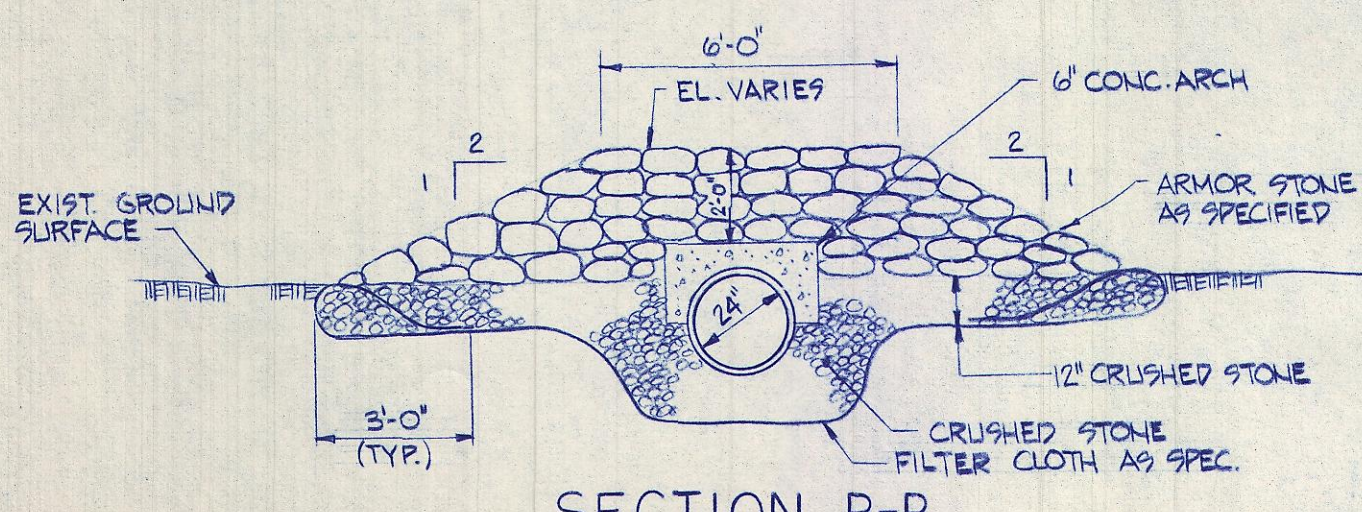

SECTION B-B
SCALE: 1/4" = 1'-0"

PROFILE
SCALE: HOR. 1" = 40'
VERT. 1" = 4'

Approved by:	Date	Name
Structural		
Electrical		
HVAC		
Project Engineer	1/4/77	J.P. Sforzini
Project Manager	1/4/77	W. R. Bogue



Date	Ch'k'd.	Revision
Designed by:	NTC/TPS	
Drawn by:	B.G.	Date: SEPTEMBER 1977
Checked by:	W.H.R.	
Approved by:	N.C.F.	Scale: AS NOTED

CITY OF NEW BEDFORD, MASSACHUSETTS
DEPARTMENT OF PUBLIC WORKS
DRAINAGE WORKS IMPROVEMENTS
CLARKS POINT SEPARATION - EAST SIDE

AQUIDNECK ST.

CAMP DRESSER & McKEE Inc.
Consulting Engineers
Boston, Mass.

SHEET NO. 37
309-28381