
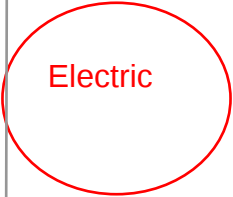
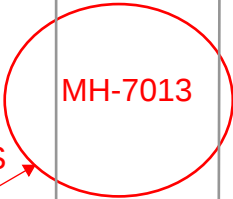


R-015A Notes 12/19/2024
See
4B- Clarks Point Sep. east side (Sht 36 - Swan St & Butler St)

6634A - ROD FR BLVD sewer.pdf
Sewer Plots 11 and 14

no other manholes nearby.
MH-7013 and MH-7014
consistent with Sewer_Plot
11 and 14

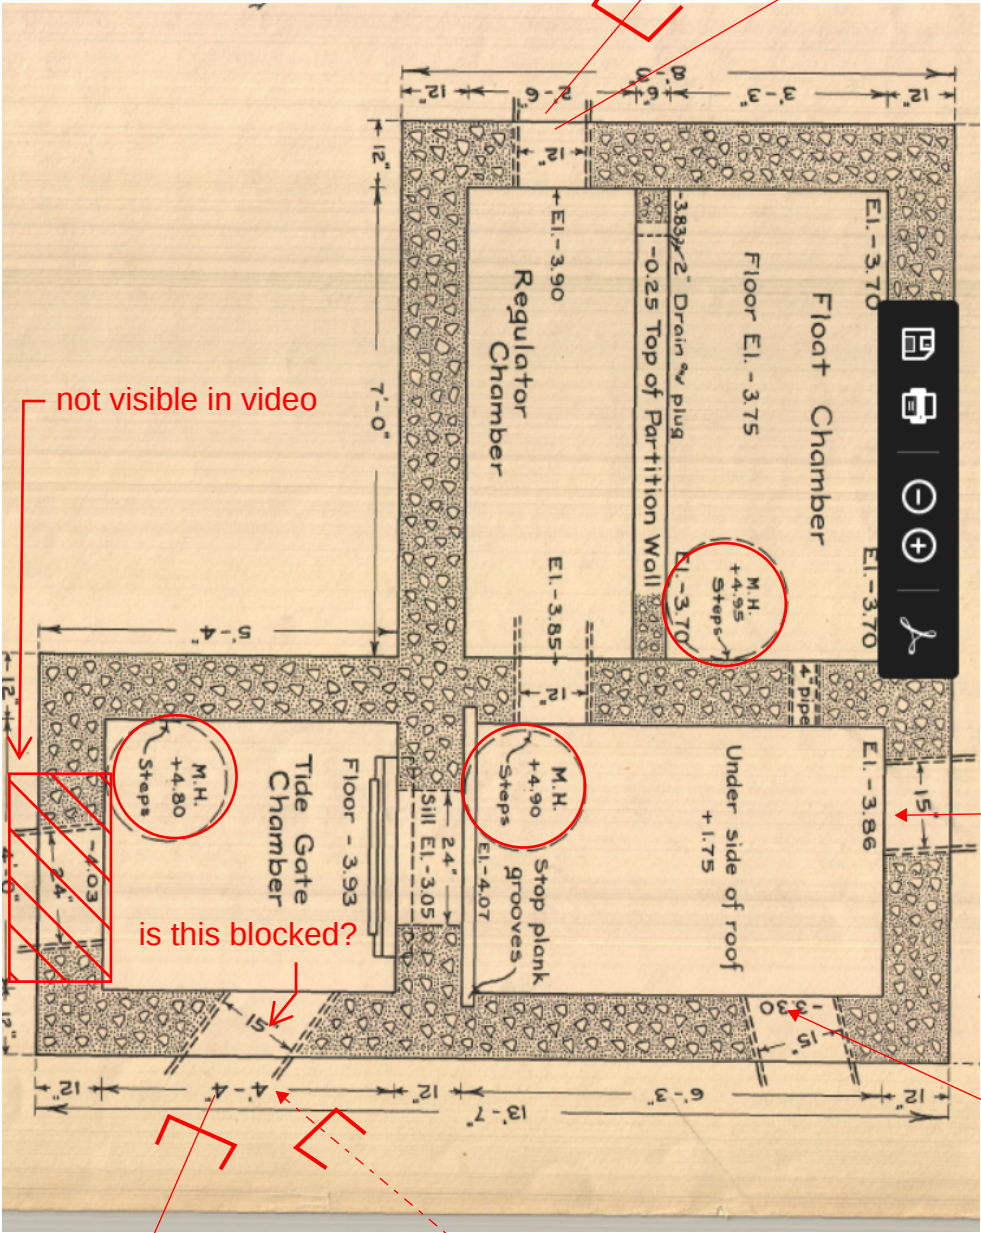

Electric MH confirmed in B-636 East Rod. french blvd
interceptors & force main (sheet 3).pdf



big lump in tide chamber- maybe covering outlet?



only pipes visible in overflow chamber. on wall adjacent to tide gate



opening between regulator and inlet chambers



tide leaking through tide gate into inlet chamber