


## METER SITE INFORMATION FIELD LOG

<b>PROJECT:</b> New Bedford, MA	<b>DATE:</b> September 9, 2013	<b>TIME:</b>
<b>LOCATION:</b> 22 Frederick Street	<b>MH#:</b>	<b>METER SITE:</b> 41
<b>COMMENTS:</b> GPS: 41.610626, -70.907296		



	Size (")	Material	Flow Depth (")	Debris	Shape	MH Depth
Incoming	34	VCP	1	0	Circular	07' 09"
Incoming						
Outgoing	6	VCP	1	0	Circular	08' 01"
Outgoing	34	VCP	0	0	Circular	08' 02"

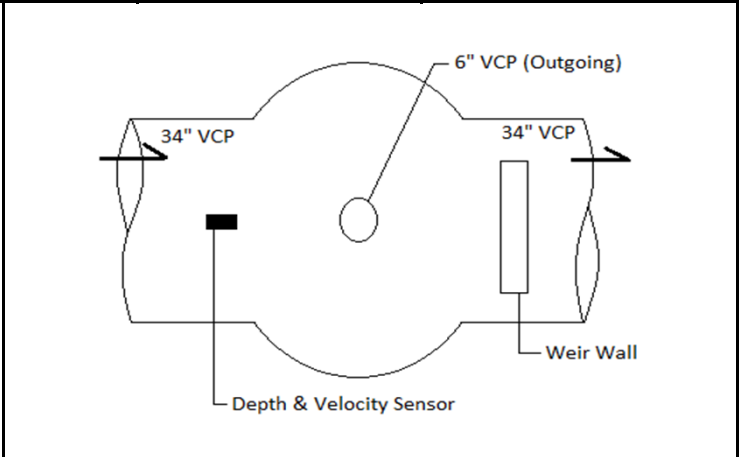

### SURCHARGE INFORMATION

<b>SURCHARGE NONE EVIDENT:</b> X
<b>SURCHARGED MARKS TO:</b>
<b>SURCHARGE CURRENTLY TO:</b>

### WEIR INFORMATION

<b>LENGTH:</b> 27.1"	<b>HEIGHT ABOVE WEIR:</b> 27.5"
<b>BREADTH:</b> 8.5"	<b>OVERFLOW OCCURS AT:</b> 6"
<b>LEVEL:</b> No	

