


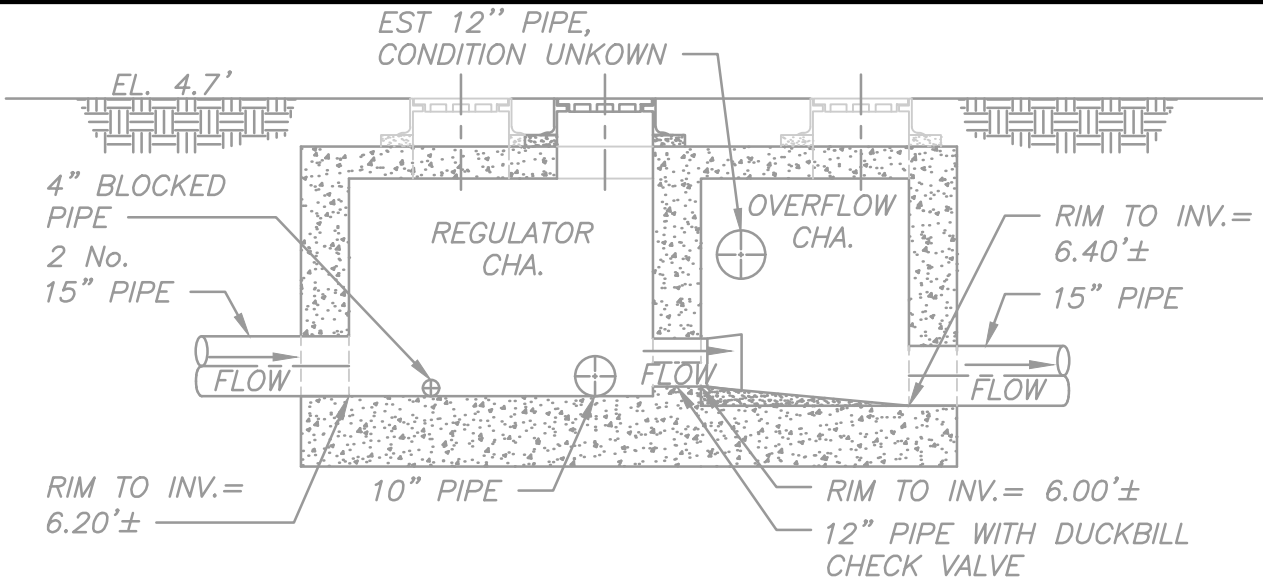


SECTION

1/4" = 1'-0"

1

SH.1

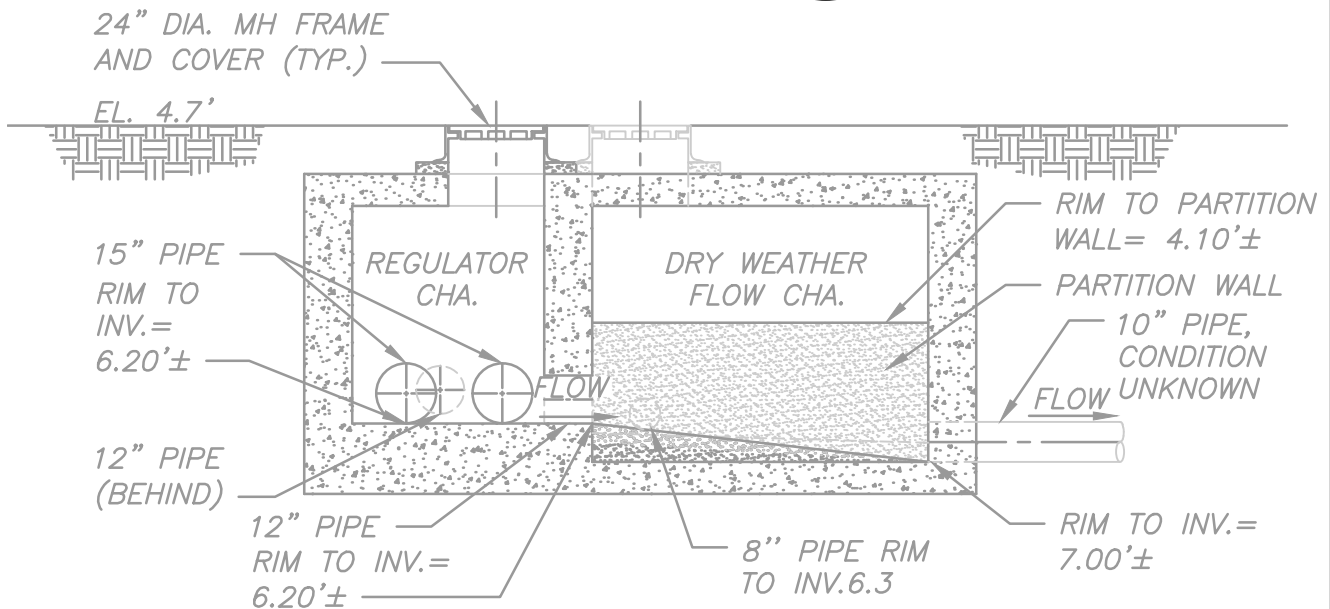


SECTION

1/4" = 1'-0"

2

SH.1

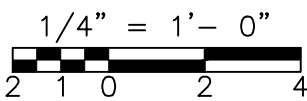

NOTE:

ELEVATIONS SHOWN ARE IN NEW BEDFORD CITY DATUM.