


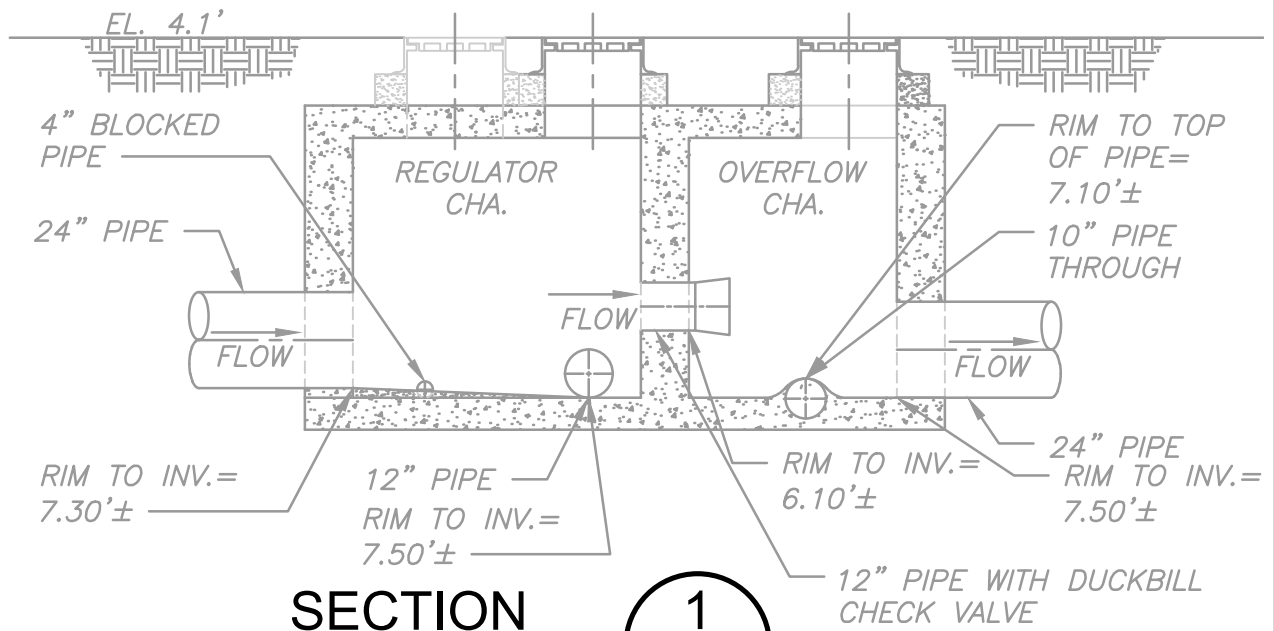


SECTION

1

1/4" = 1'-0"

SH.1

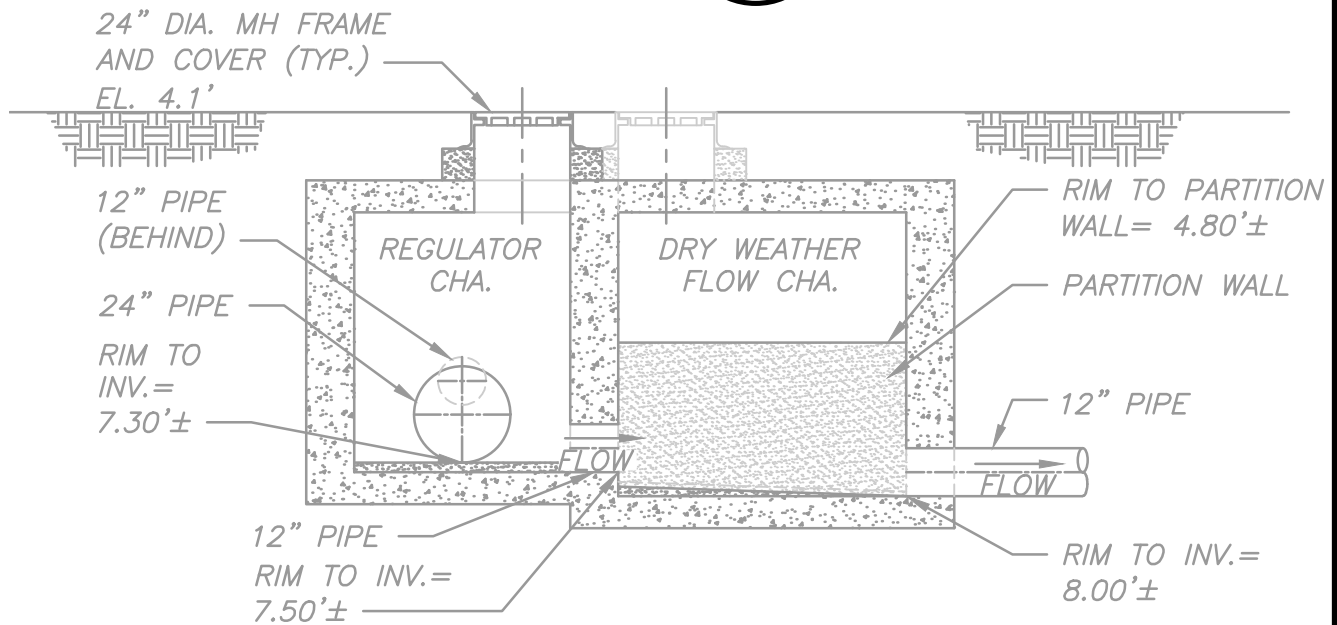


SECTION

2

1/4" = 1'-0"

SH.1

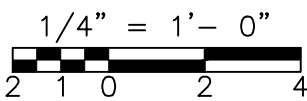

NOTE:

ELEVATIONS SHOWN ARE IN NEW BEDFORD CITY DATUM.