




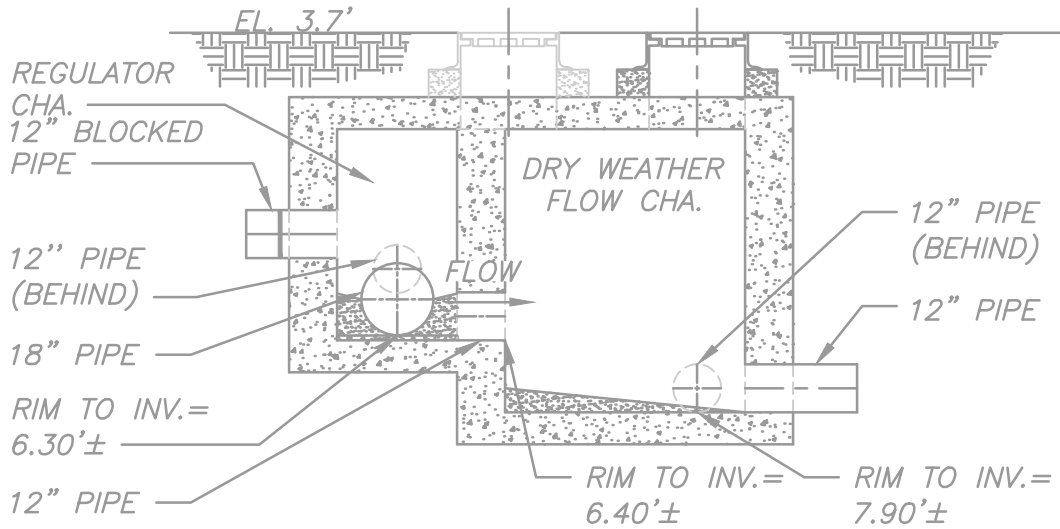

SECTION 1
1/4" = 1'-0" SH.1

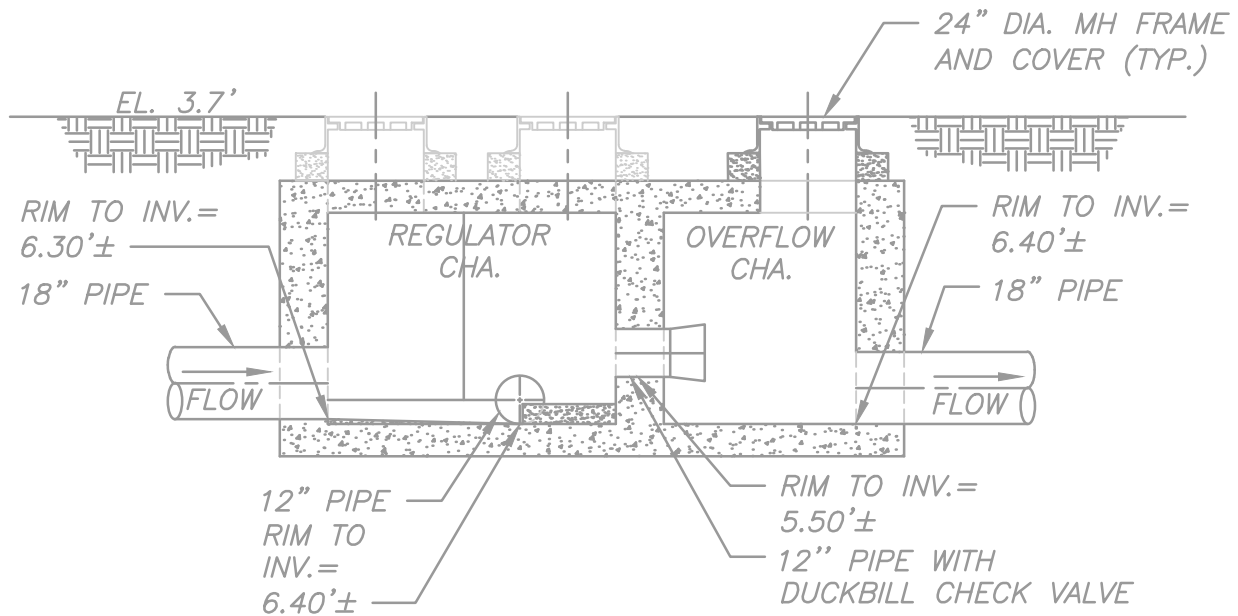

SECTION 2
1/4" = 1'-0" SH.1

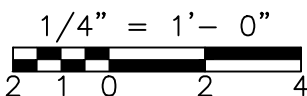

NOTE:
ELEVATIONS SHOWN ARE IN NEW BEDFORD CITY DATUM.