
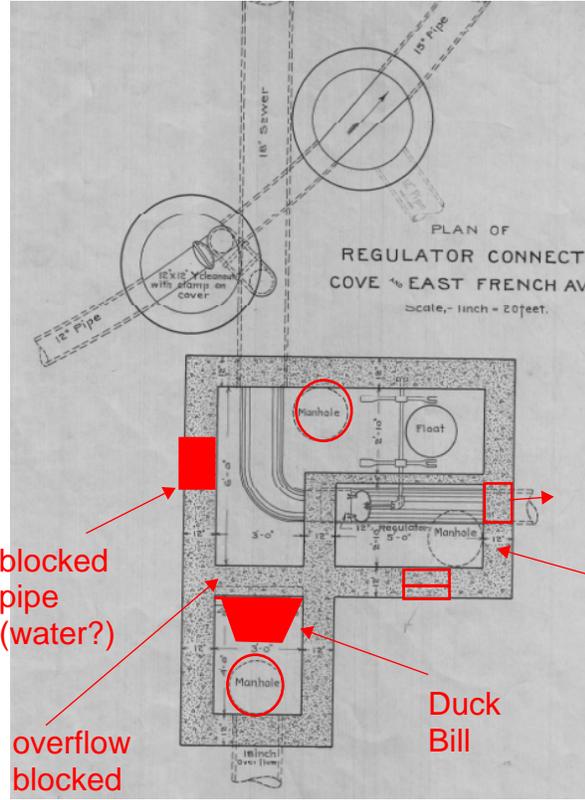


# R-018A Field Visit on 2/14/2025

SEE THESE NOTES:

pw://cdmsmith-az02-pw.bentley.com:pw\_pl1/Documents/0309/97426\_Phase&space;1/02&space;Project&space;Information/03&space;Data/40&space;Field&space;Data/Outfall&space;018&space;Investigation/CJK&space;Field&space;Notes.pdf

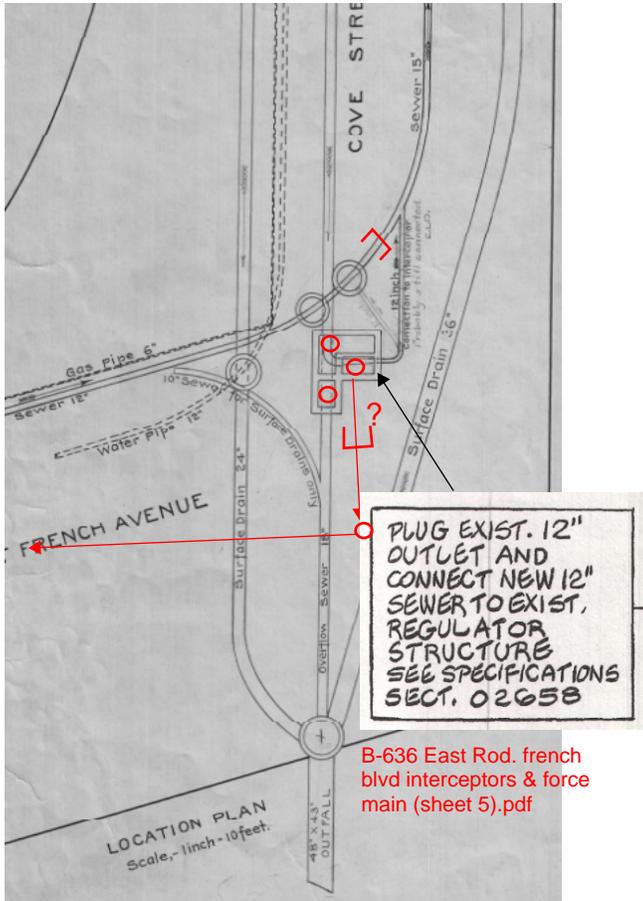


blocked pipe (water?)

overflow blocked 7/1984??

Duck Bill

MH submerged. Potentially saw two outgoing pipes. Very little flow



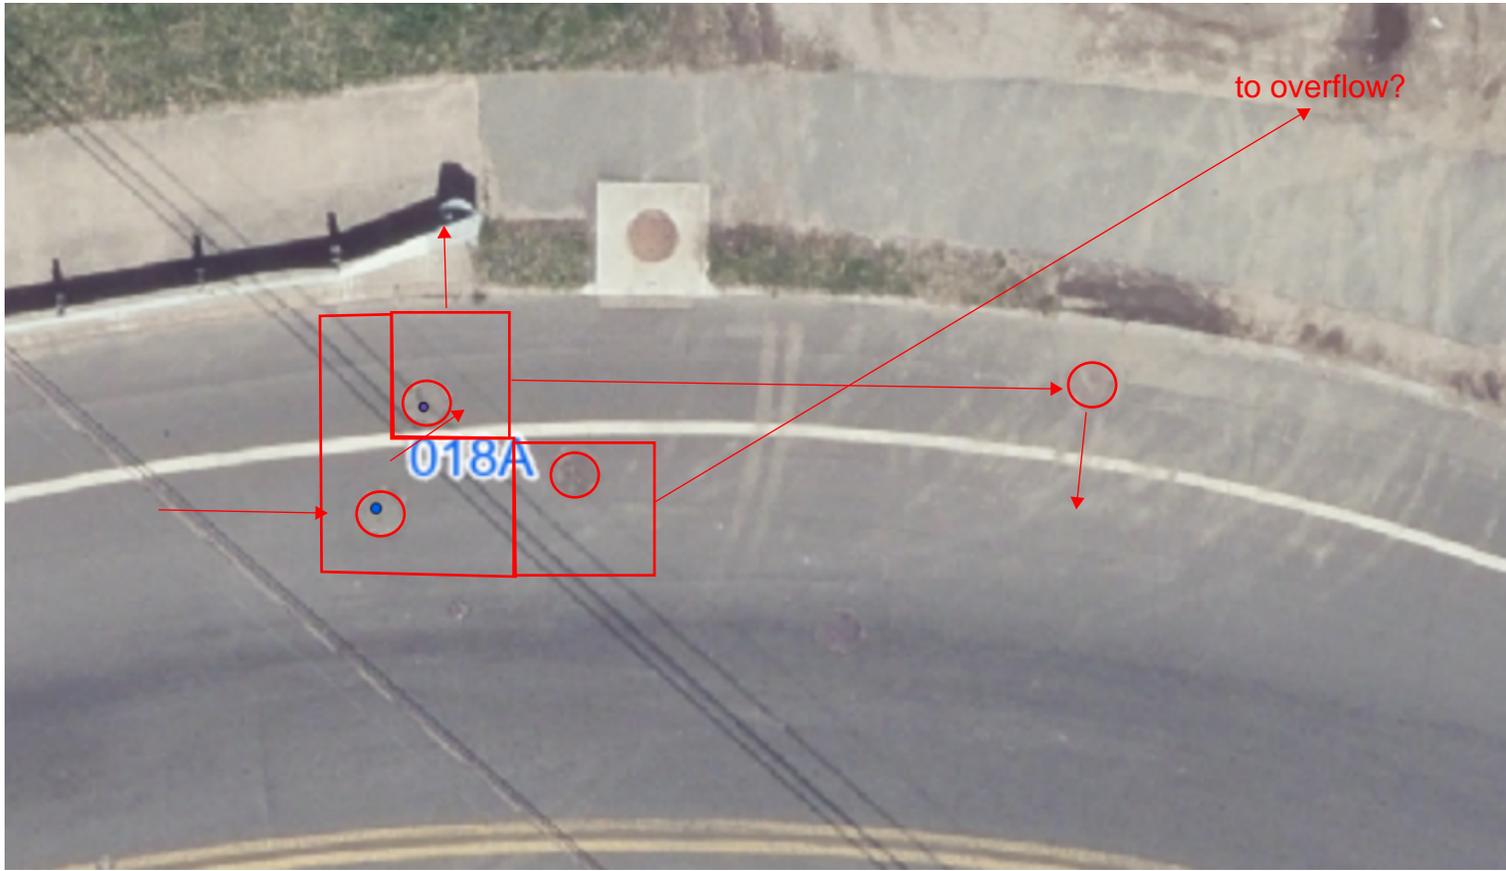

to overflow?

018A