

CSO SPEC SHEET

Structure #: REG 018 B

Date: 08/28/2012
Insp. By: AH and AK

Location: At the Intersection of Cove St. and Cleveland St.

Structure Type: Poured in Place

Regulator Type: Weir Wall

Structure DIM's: _____

Weir Dim's: _____

Size of Sewer Pipe: 12"

Rim to Top of Weir Wall: 5.4'

Size of Storm Drain Pipe: 12"

Rim to Storm Drain Invert: 5.7'

Sewer Direction: West to North

Rim to Top of Sewer (Normal Flow): 6.1'

Free Board: 0.4'

Over All Rating: (Circle One)

Poor


Fair

Good

Excellent

Comments: Weir wall needs repair.

Field Sketch:

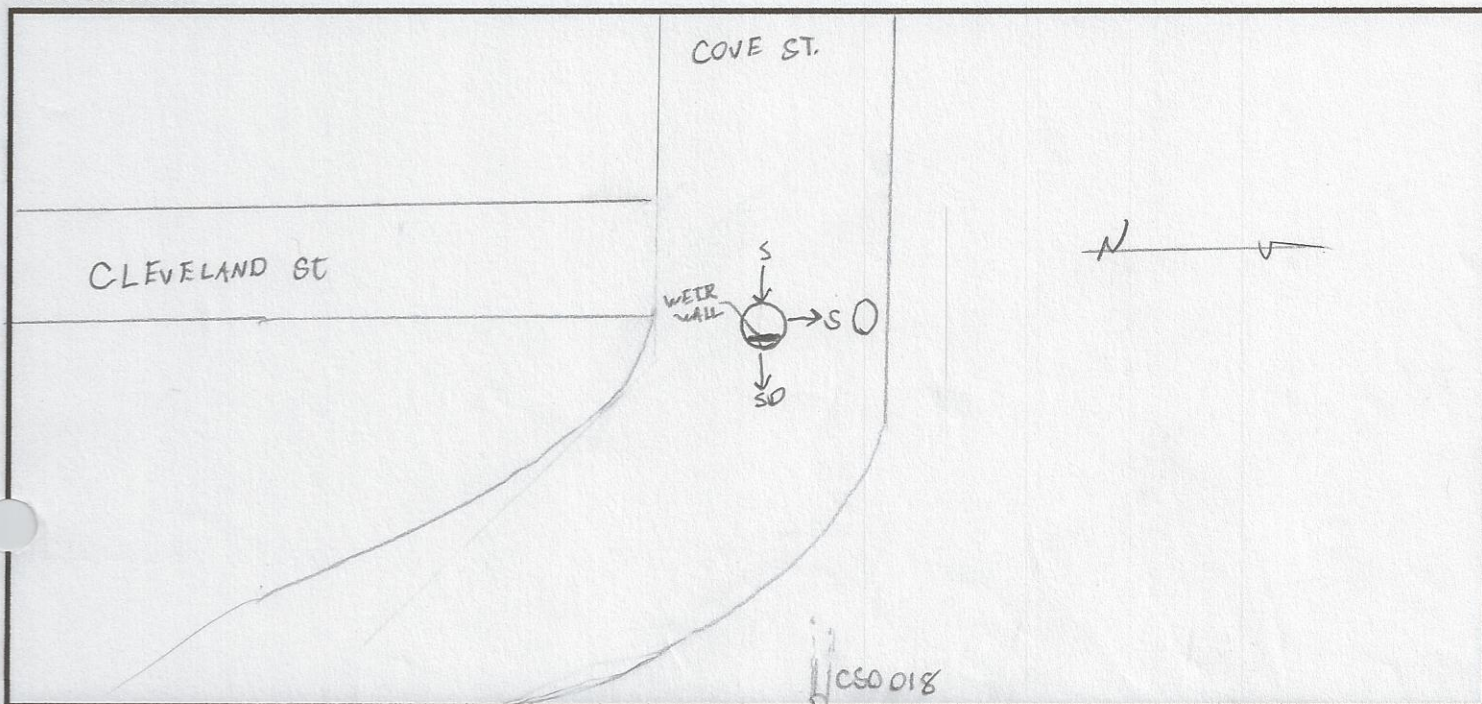

CSO FIELD PHOTOS

Structure#: REG 018 B

Location: At the Intersection of Cove St. and Cleveland St.

Figure 1.



Figure 2.



Figure 3.



Figure 4.




Descriptions

Figure 1: View of Regulator 018 B. Facing North.

Figure 2: Inside view of manhole. A- Sewer; B- Weir Wall; C- Storm Drain.

Figure 3: Street view of Regulator 018 B. Facing North.

Figure 4: Google Earth Image of location of Regulator 018 B. A- Reg 018 B; B- Hurricane Barrier.

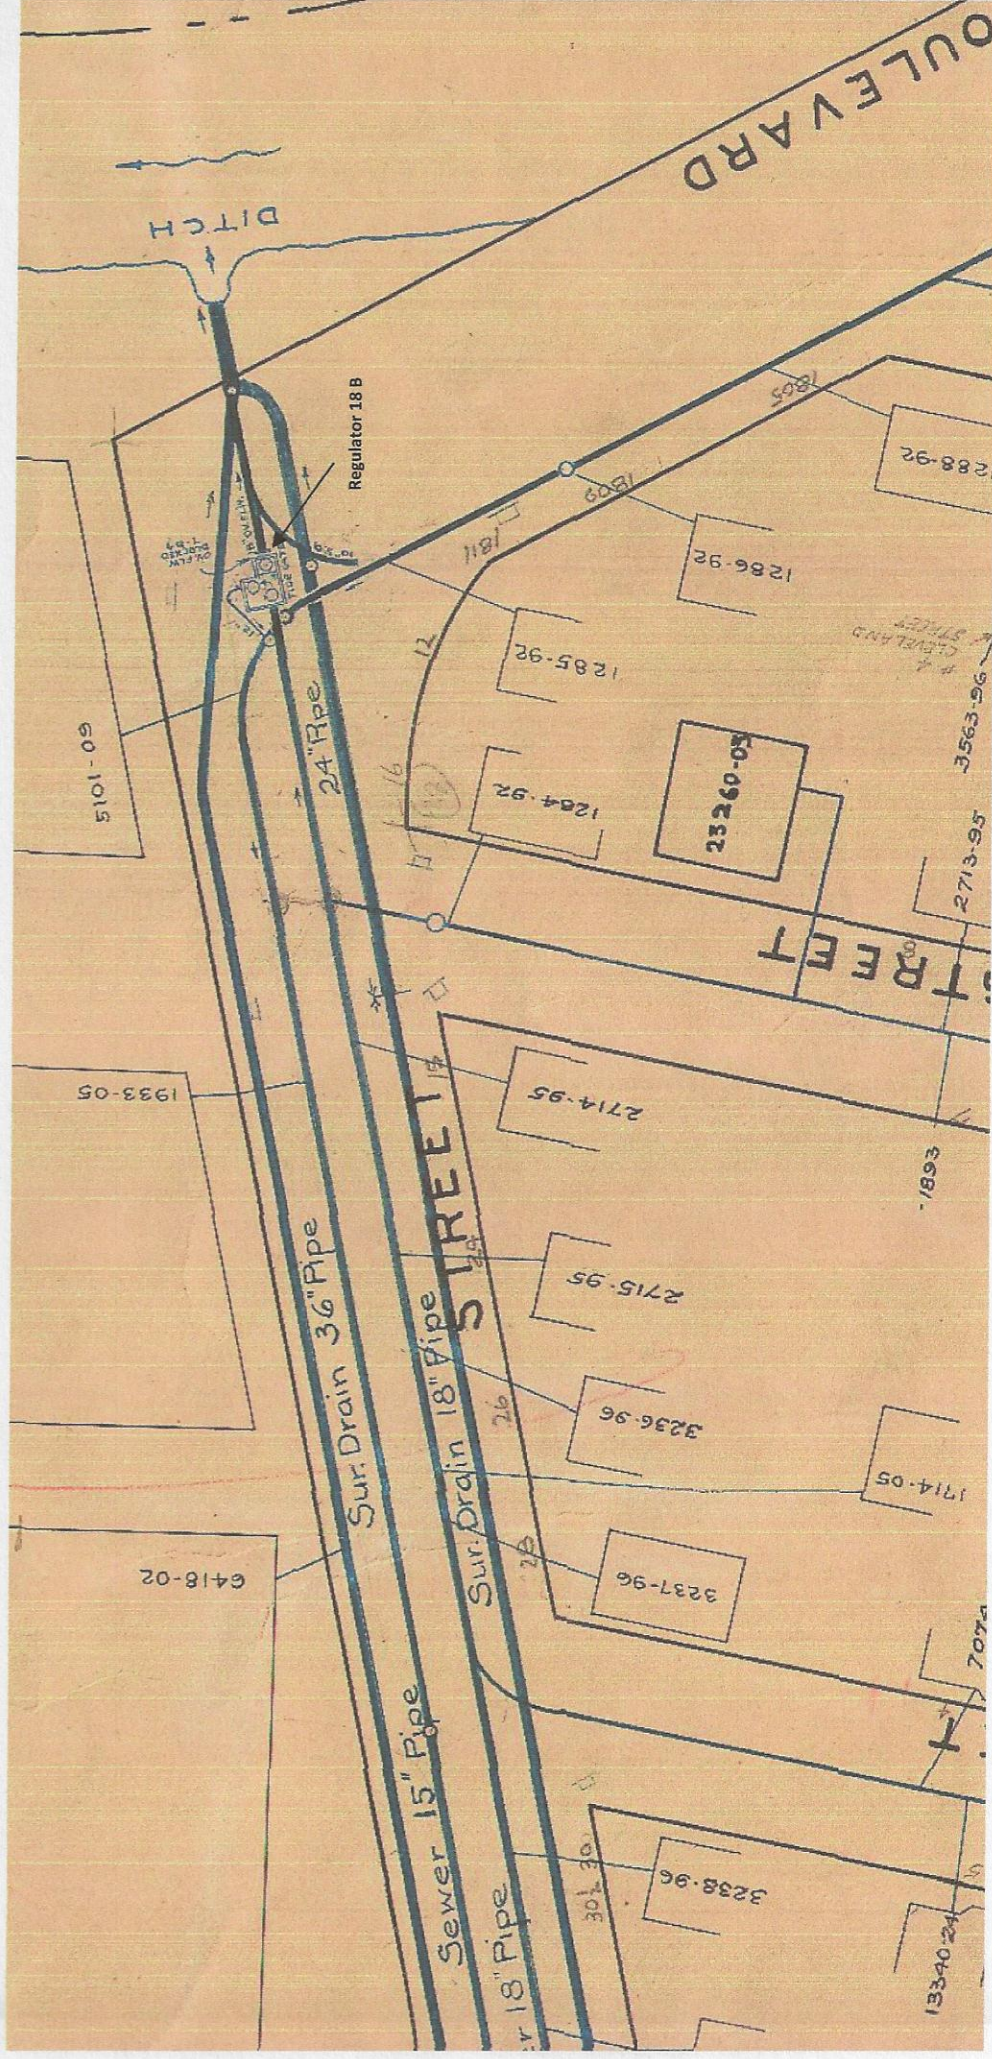

CSO/Regulator Repair Log

Structure #: Reg 018B

[illegible]