

CSO SPEC SHEET

Structure #: REG 020 A

Date: 09/27/2012
Insp. By: AK & AH

Location: At the Intersection of Purchase St. and Wammsutta St.

Structure Type: Double Side Weir Wall

Regulator Type: Block Regulator

Structure DIM's: _____

Weir Dim's: _____

Size of Sewer Pipe: Twin 24"

Rim to Weir Wall: 12.7'

Size of Storm Drain Pipe: 30.0"

Rim to Storm Drain Invert: _____

Rim to Top of Sewer (Normal Flow): 13.4'

Sewer Direction: West to East

Free Board: 0.7'

Over All Rating: (Circle One)

Poor


Fair


Good

Excellent

Comments: No repairs needed.

Field Sketch:

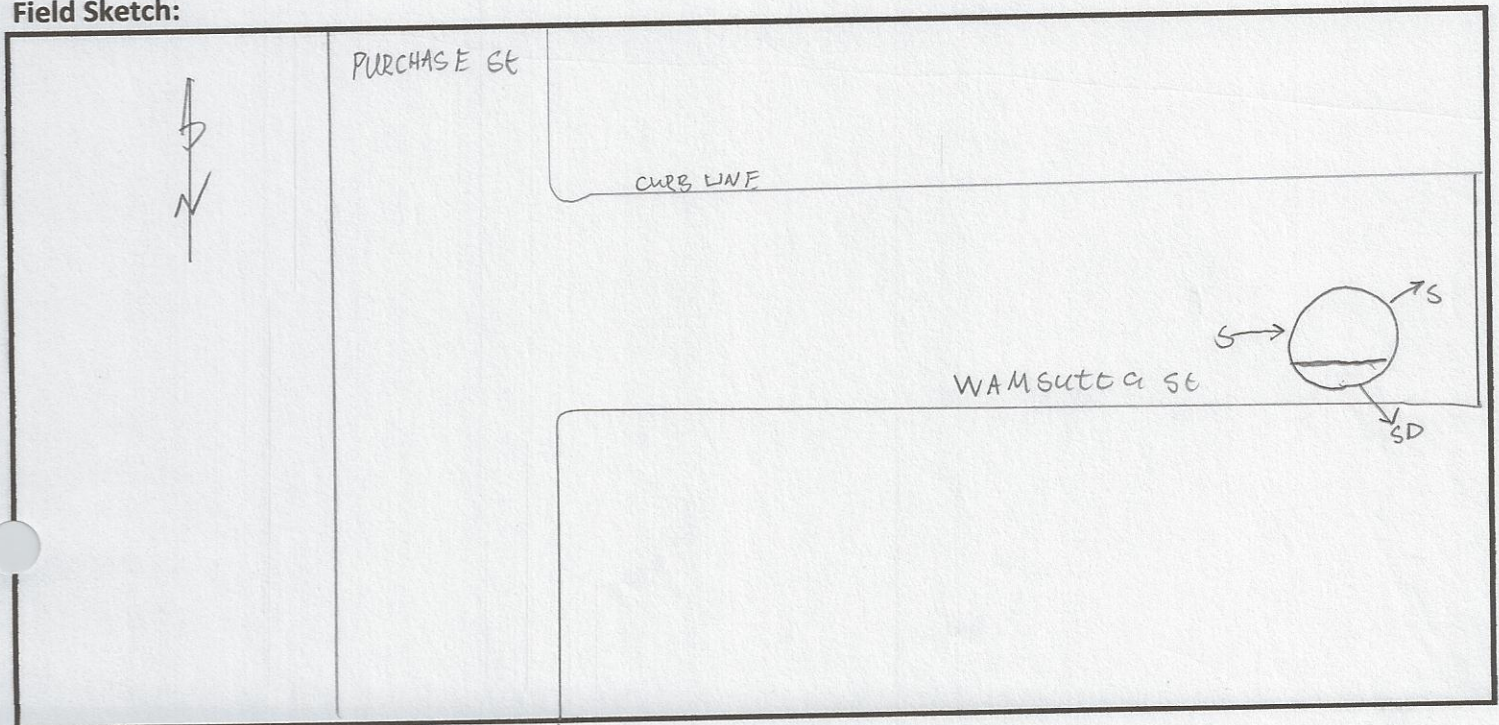

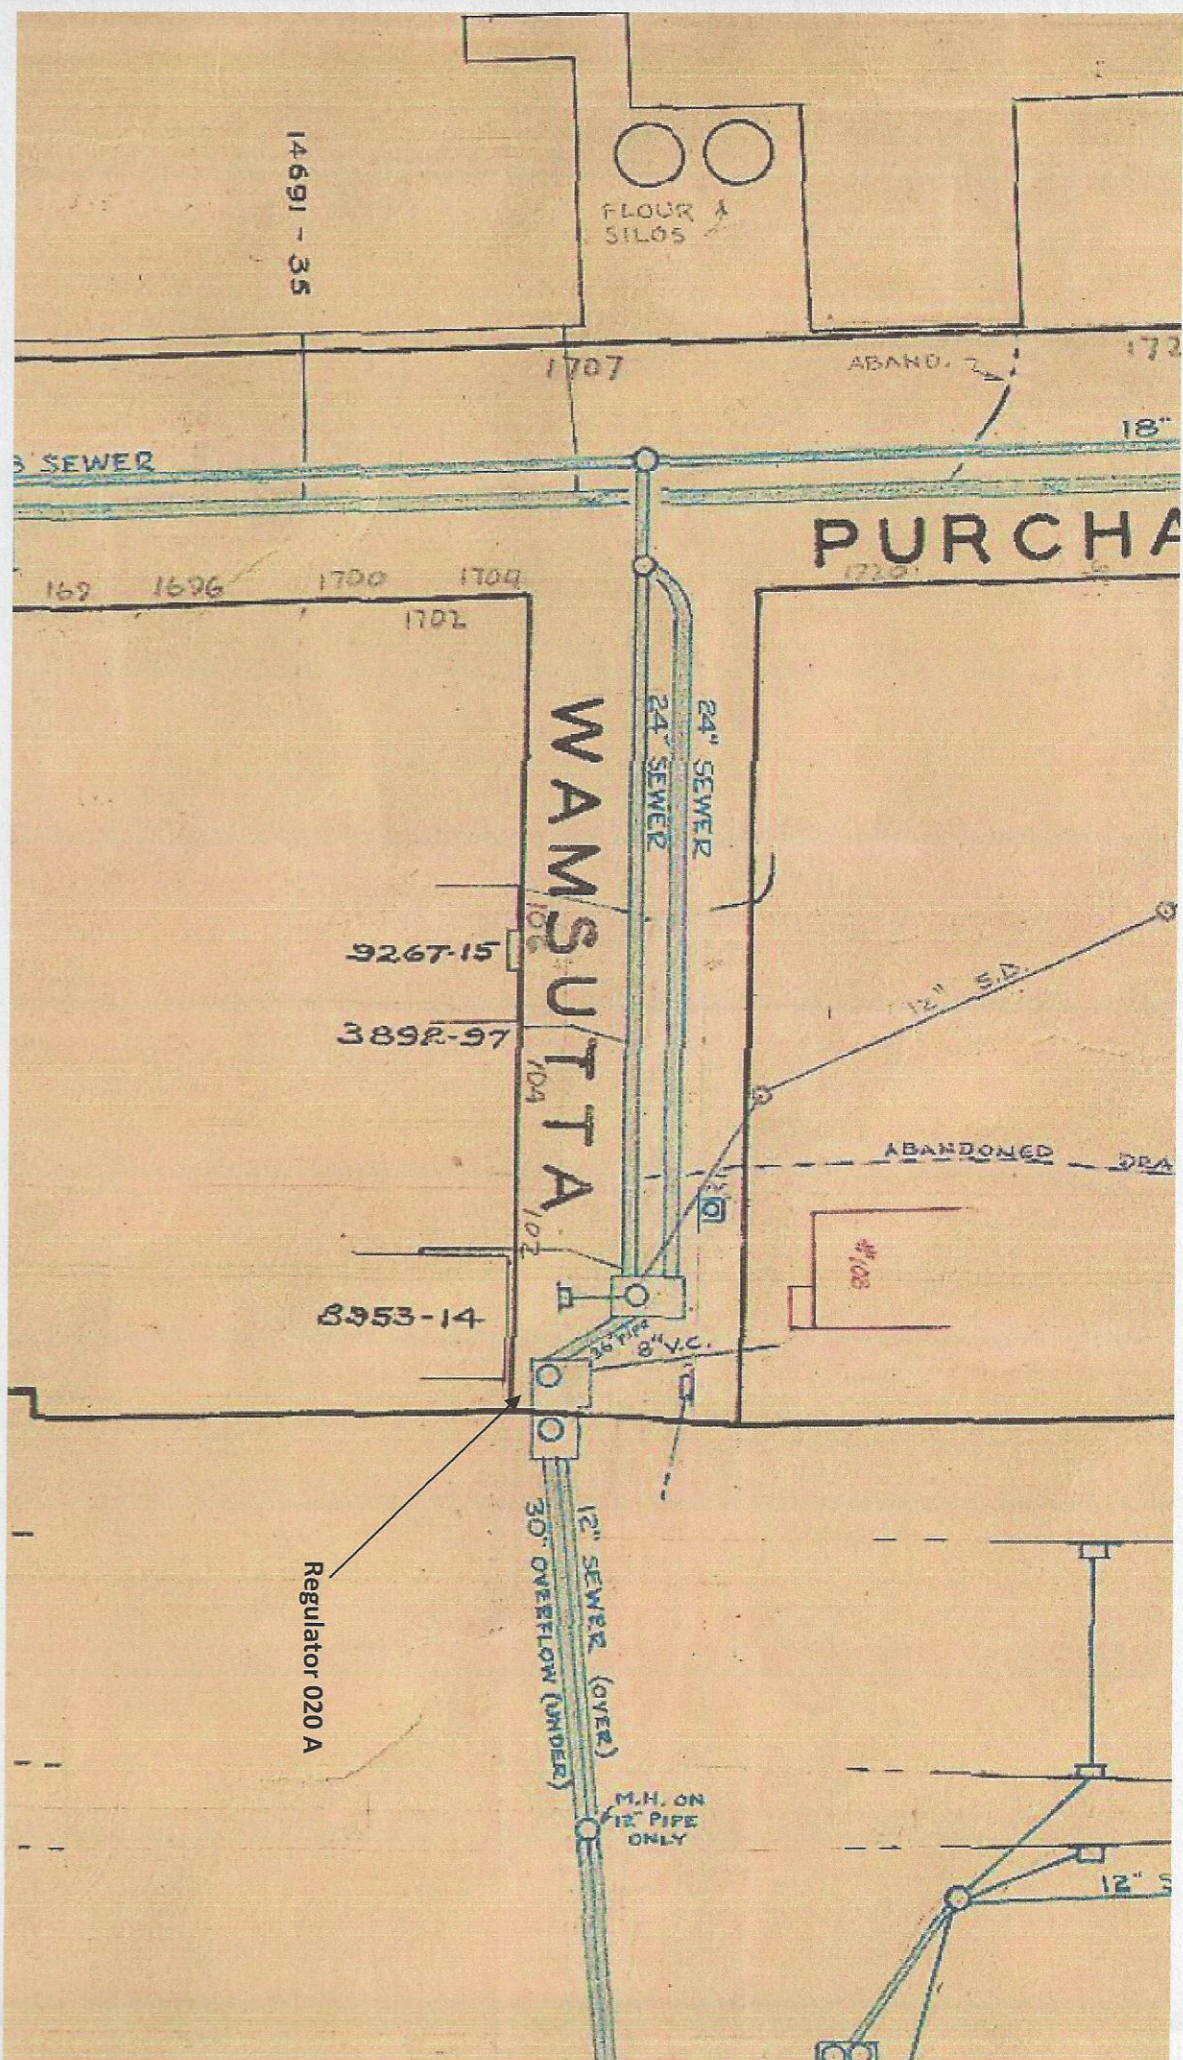

CSO FIELD PHOTOS

Structure#: REG 020 A

Location: At the Intersection of Purchase St. and Wamsutta St.

Figure 1.



Figure 2.

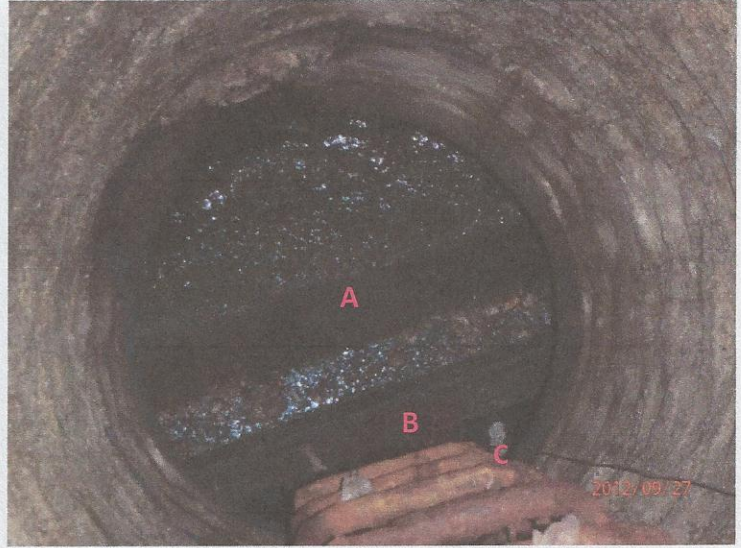


Figure 3.



Descriptions

Figure 1: View of Regulator 020 A. Facing North.

Figure 2: Inside view of manhole. A- Sewer; B- Weir Wall; C- Storm Drain.

Figure 3: Google Earth Image of location of Regulator 020 A. A- Reg 020 A.

CSO/Regulator Repair Log

Structure #: Reg 020A

[illegible]