

New Bedford Regulator Specification Sheet

Regulator #: R-020A

Location: Wamsutta St. west of Rt. 18

Date: 6/25/25

Structure Measurements

Structure Type: Multichamber (2)

Rim Elevation (ft City Datum): 16.9

Regulator Type: Fixed Weir

Overflow Height (ft or in): 1.5'

Rim to Top of Weir (ft): 11.6

Weir Dims (ft or in): Length: 7.5', Width: 5", Height: 1.5' above inlet elevation

Influent pipe ø (in): 36

Rim to Influent Invert (ft): 13.1

Dry Weather Connection ø (in): 12

Rim to Dry Weather Invert (ft): 14.3

Overflow pipe ø (in): 30

Rim to Overflow Invert (ft): 19.1

Sensor Measurements

Block Present: Yes

Level Sensor Status: Metered


Sensor Installation Date: 2/28/2018


Intra-System Status: No


Tide Gate Status: Gate at outfall

Notes: Redzone scanned the inlet chamber in 2023. The second chamber is on the other side of the fence only accessible from Route 18. During Feb 2025 fieldwork, it was discovered that the dry weather outlet was blocked by debris (Figure 2) and a stop plank was missing (not shown). The overflow chamber needs to be cleaned. All other dimensions taken from drawings from MassDOT.


Location Sketch:

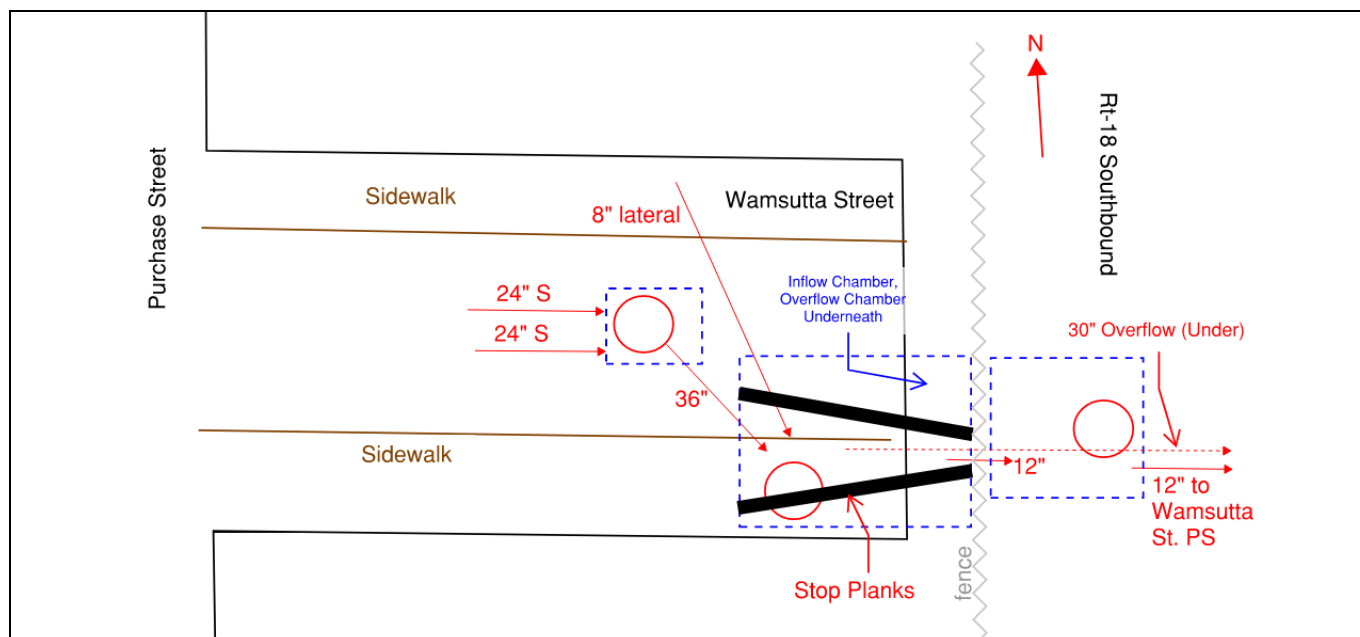

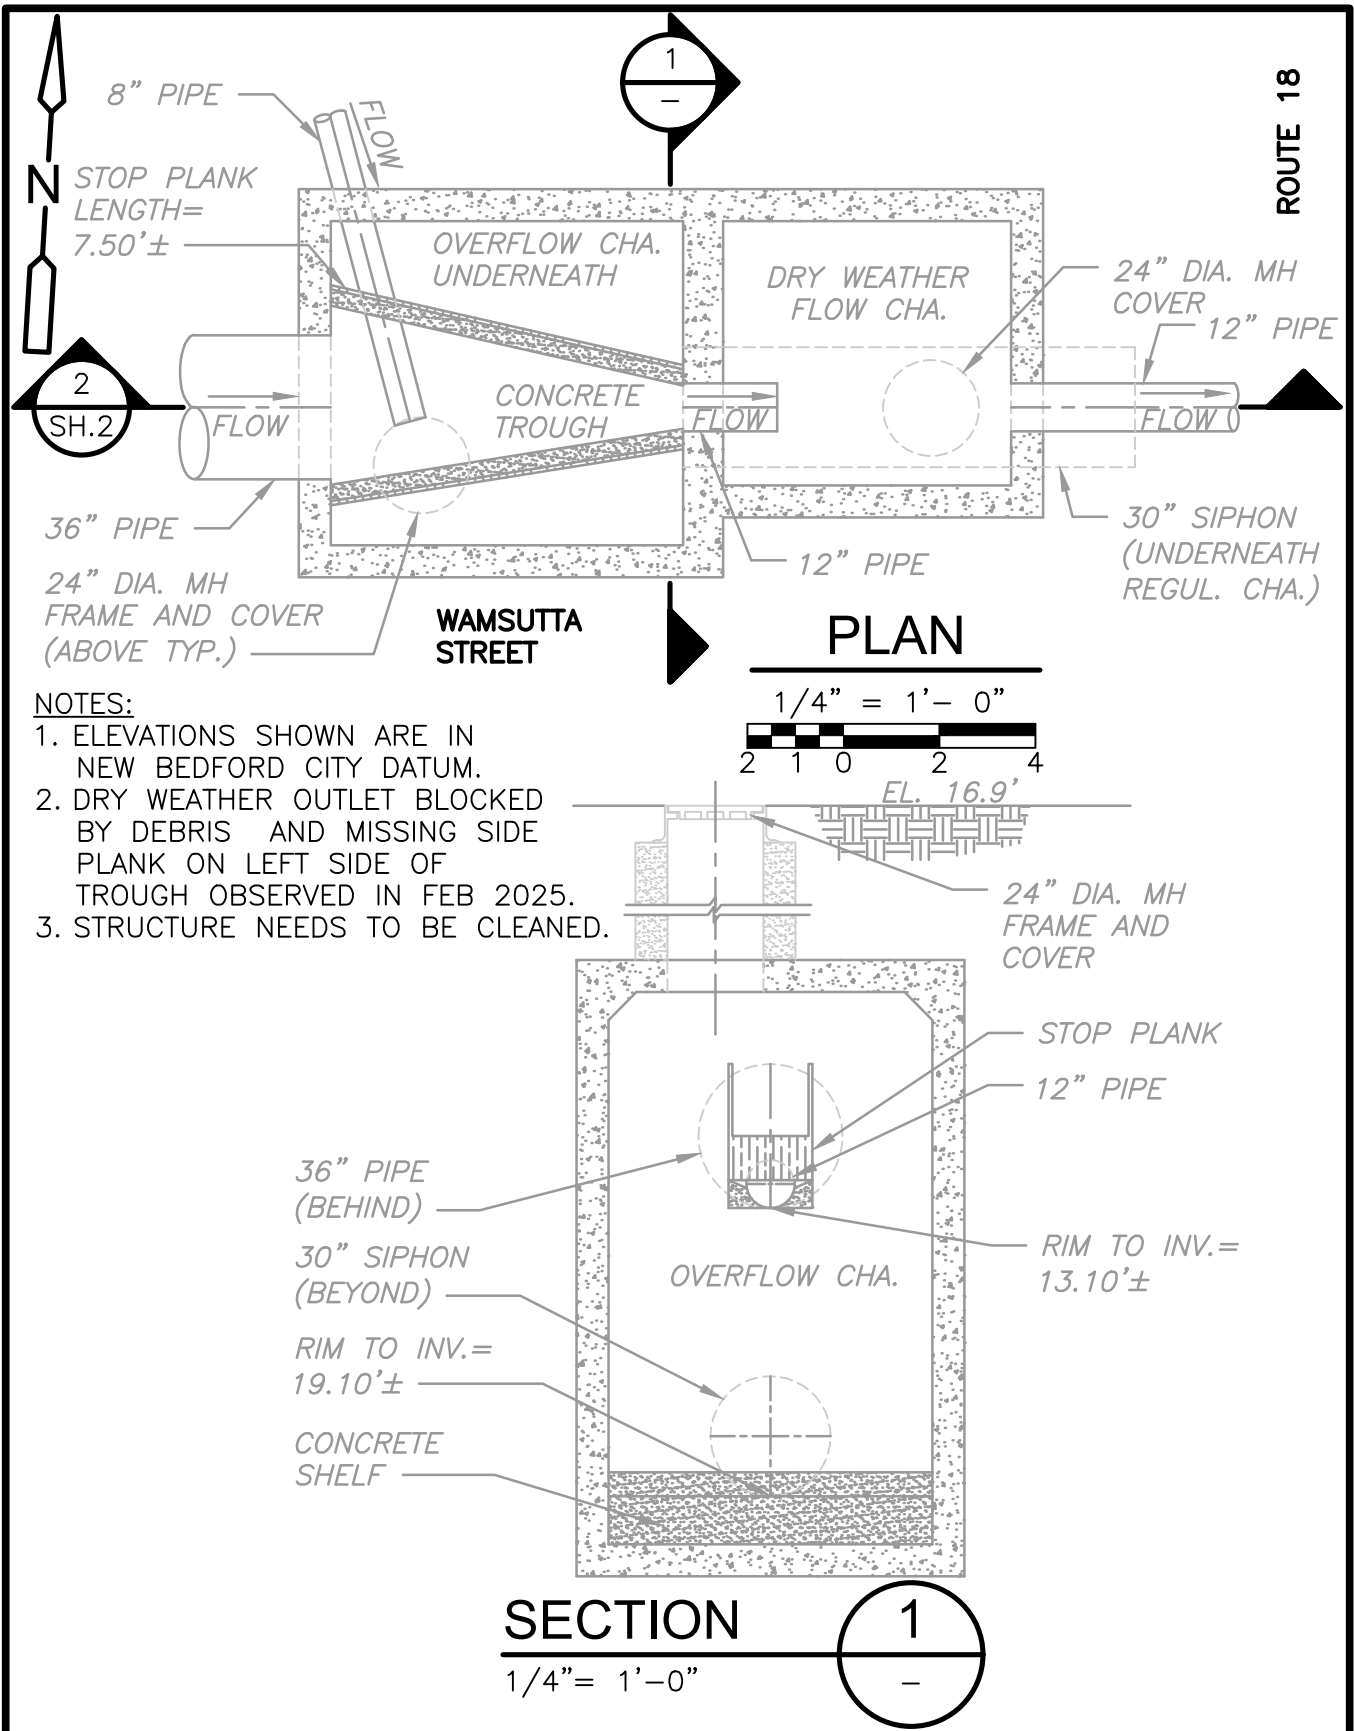

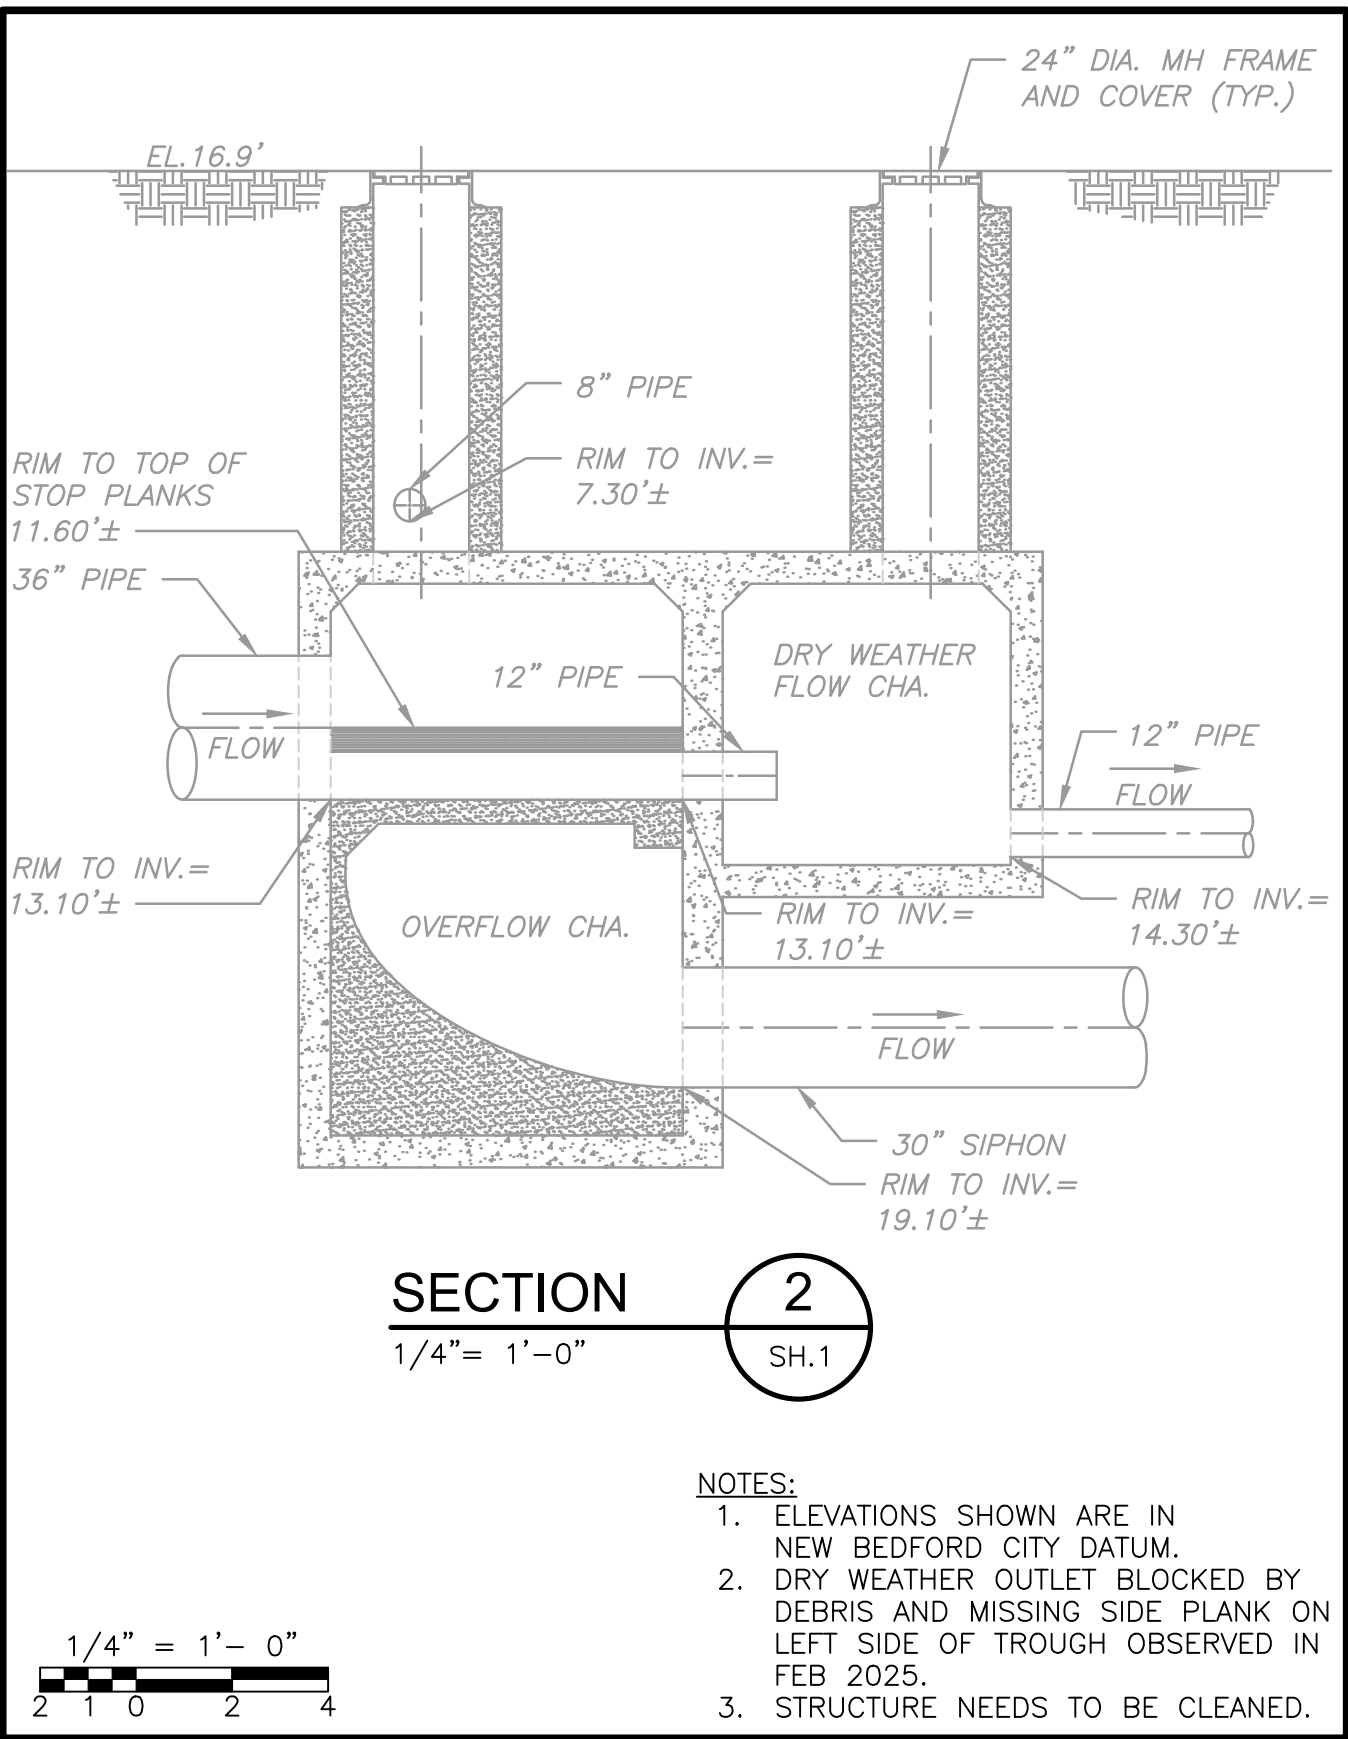

020A

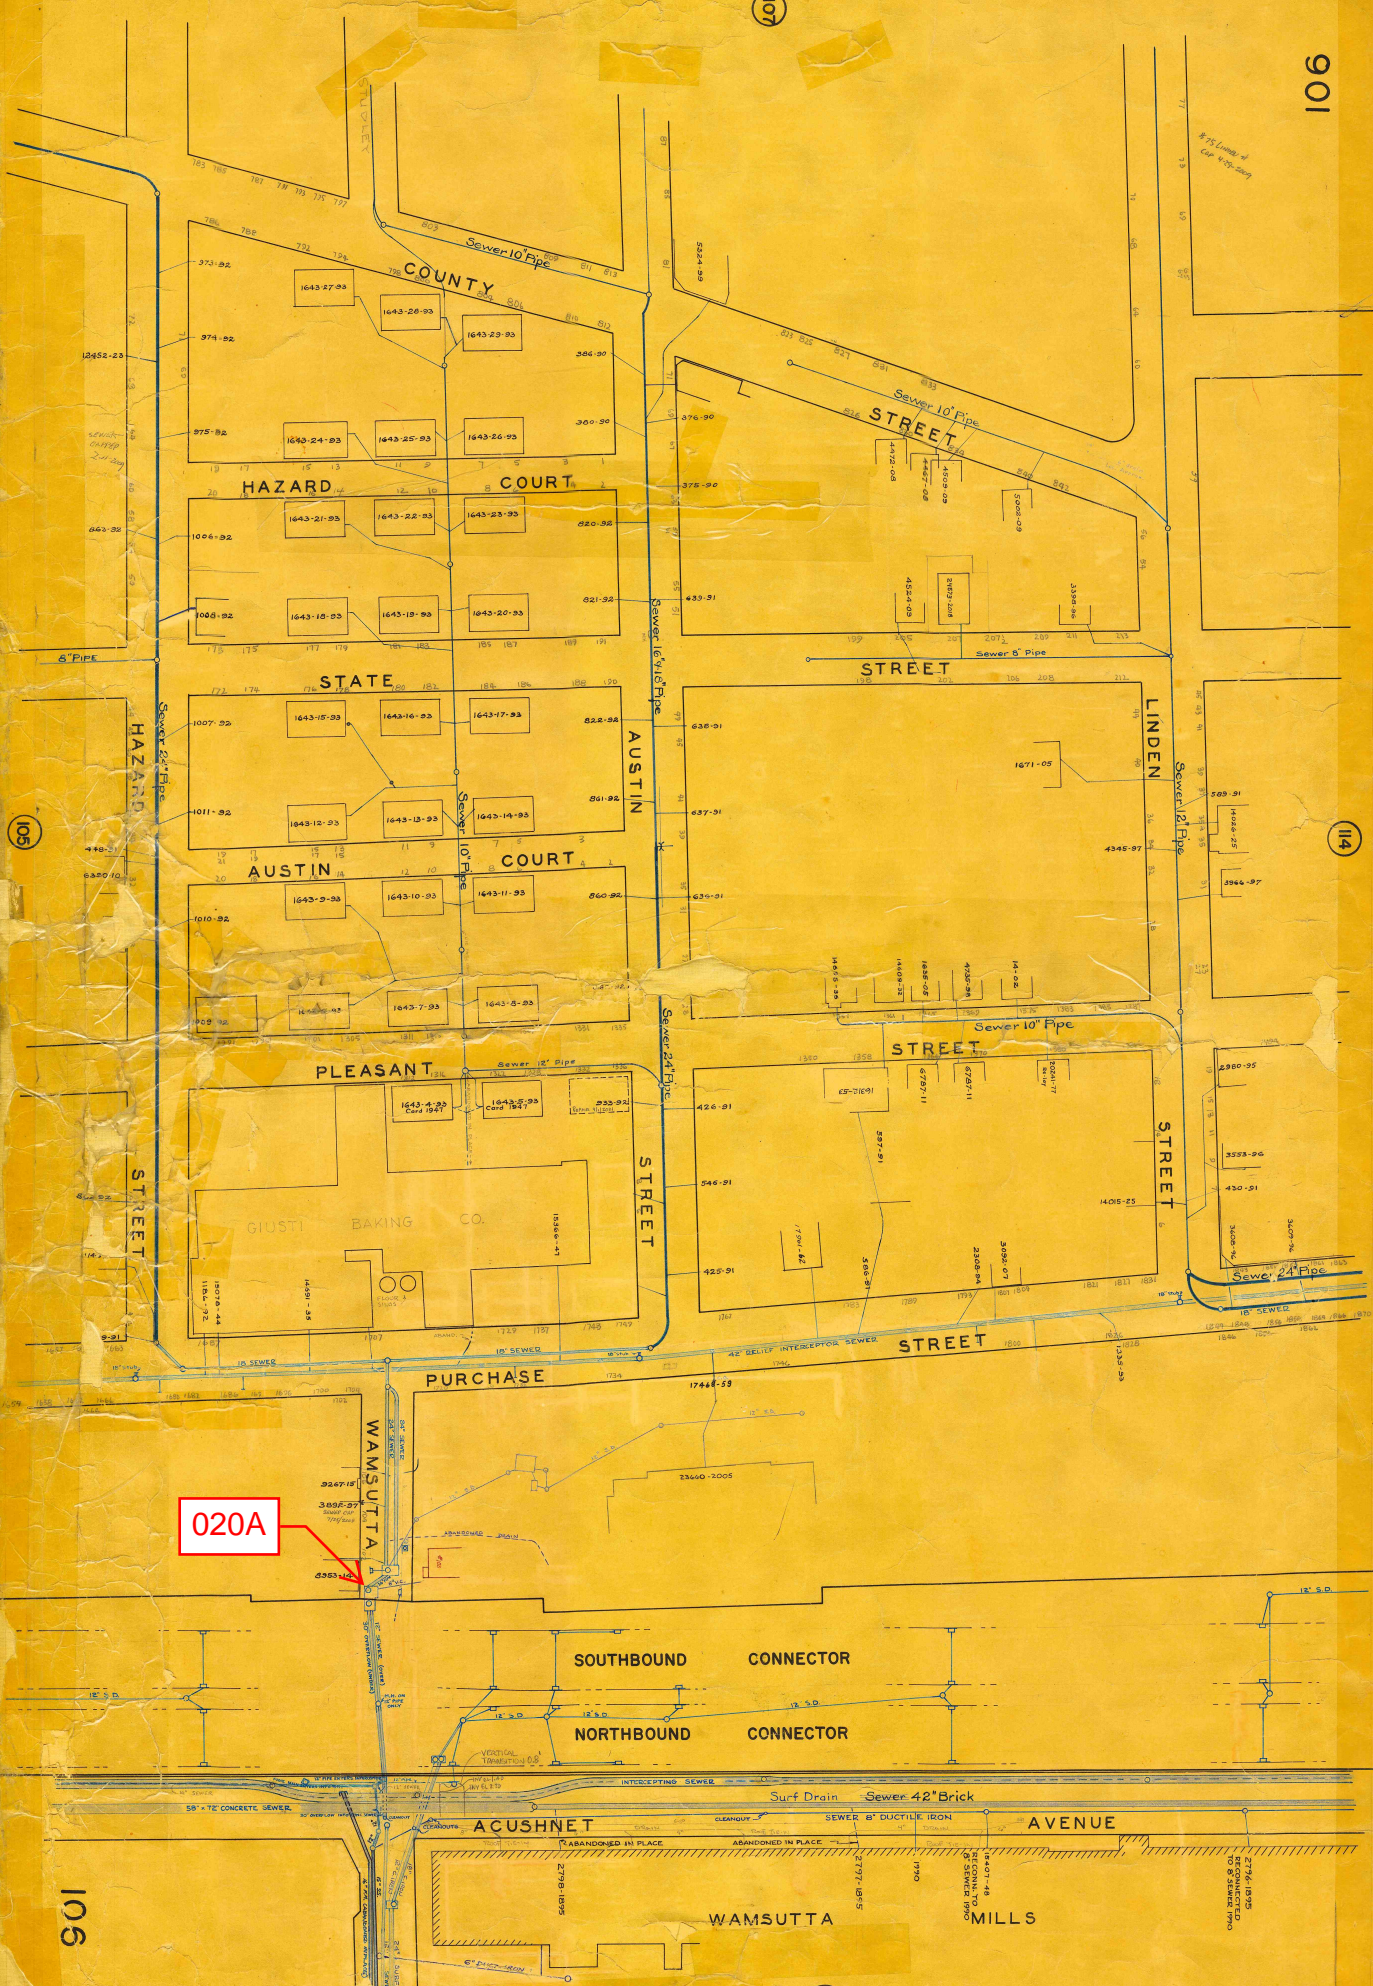

REGULATOR FIELD PHOTOS

Figure 1




Figure 2



Figure 3



Figure 4

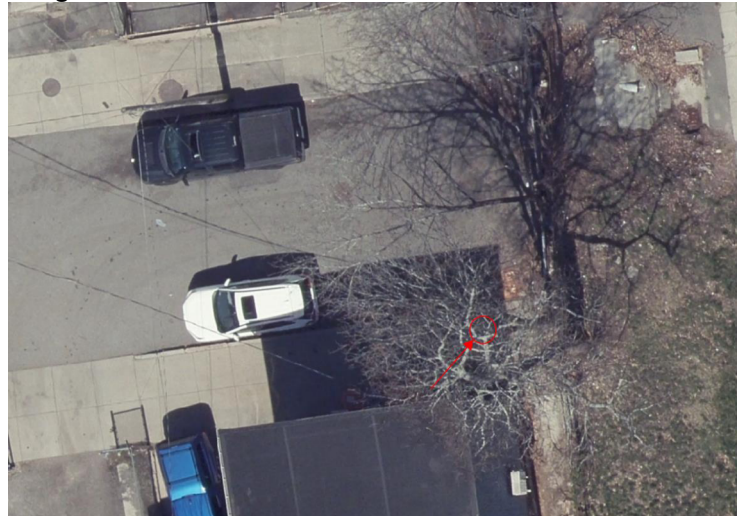

Descriptions:

Figure 1: Inside of R-020A. Dry weather flow, weir, and overflow chamber visible.

Figure 2: Inside Regulator Chamber of R-020A. Redzone scan taken Dec 2023

Figure 3: Location of manhole facing east at the end of Wamsutta St. on west side of Route 18.

Figure 4: Aerial location with arrow pointing to corresponding manhole drawn in red.