




LOGAN STREET

12" ORIFICE
TO 18" SEWER

42" PIPE

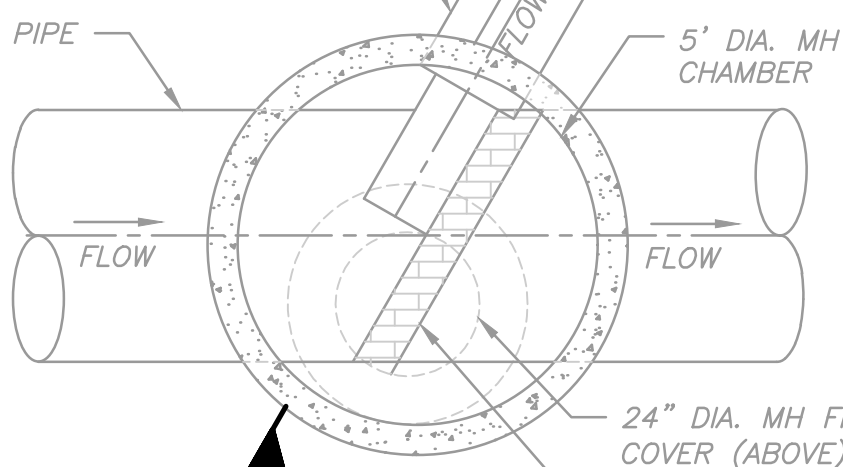

PLAN

$\frac{3}{8}" = 1' - 0"$




24" DIA. MH FRAME AND
COVER (ABOVE)

46.5"x6.5" BROAD CRESTED
BRICK WEIR WALL

NOTE:

ELEVATIONS SHOWN ARE IN
NEW BEDFORD CITY DATUM.

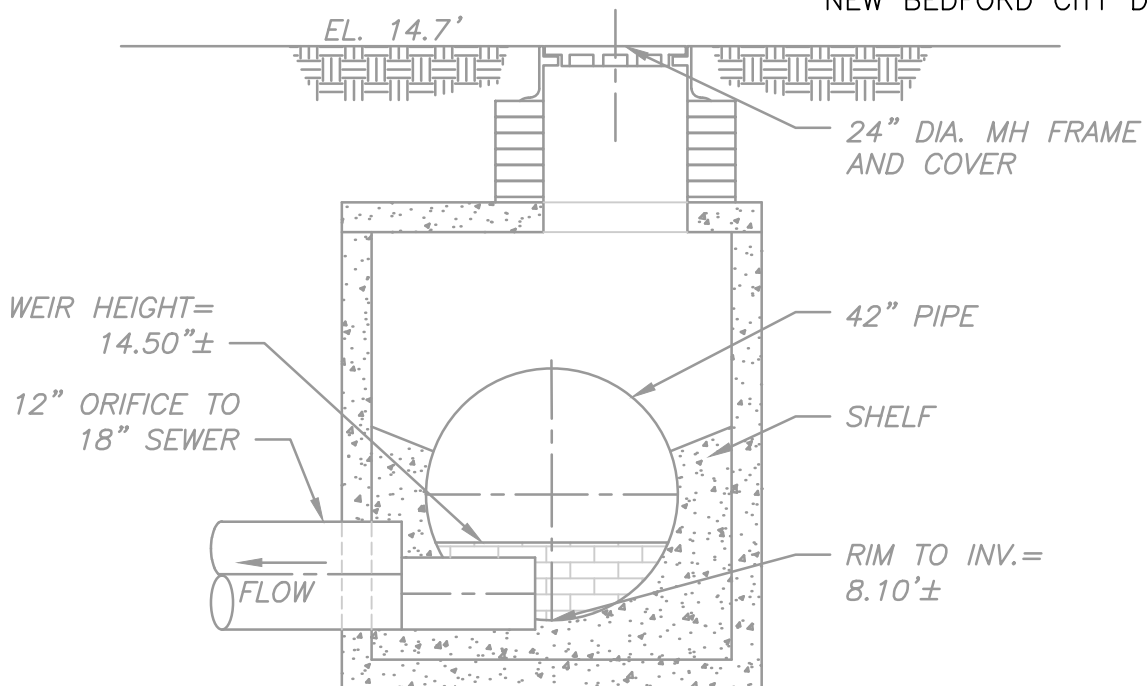

SECTION

$\frac{3}{8}" = 1' - 0"$

