

CSO SPEC SHEET

Structure #: REG 020 B

Date: 09/ 27 / 2012
Insp. By: AK & AH

Location: At the Intersection of Acushnet Ave. and Logan St.

Structure Type: Double Side Weir Wall

Structure DIM's: _____

Size of Sewer Pipe: 36"

Size of Storm Drain Pipe: 30.0" & 18.0"

Sewer Direction: West to North

Regulator Type: Block Regulator

Weir Dim's: _____

Rim to Weir Wall: 7.3'

Rim to Storm Drain Invert: _____

Rim to Top of Sewer (Normal Flow): 8.2'

Free Board: 0.9'

Over All Rating: (Circle One)

Poor


Fair

Good

Excellent

Comments: No repairs needed.

Field Sketch:

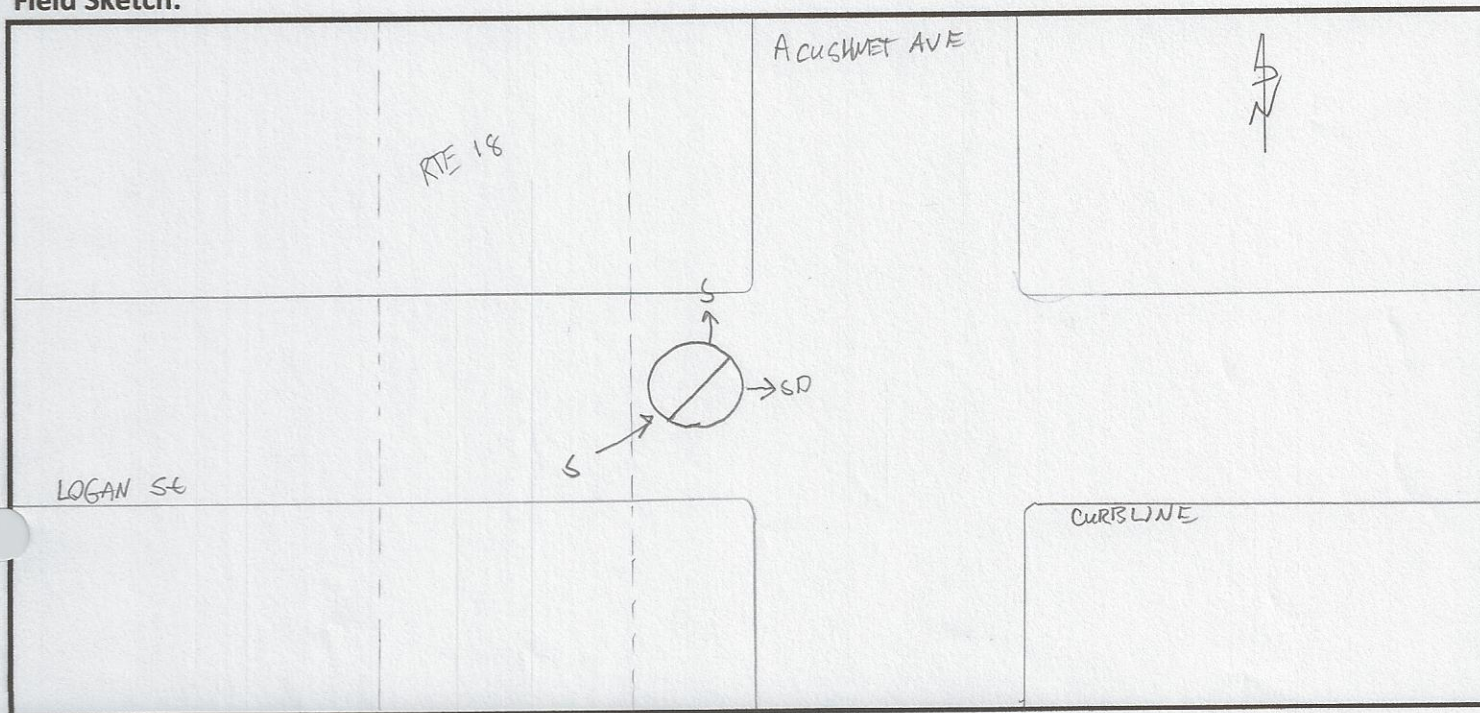

CSO FIELD PHOTOS

Structure#: REG 020 B

Location: At the Intersection of Acushnet Ave. and Logan St.

Figure 1.



Figure 2.


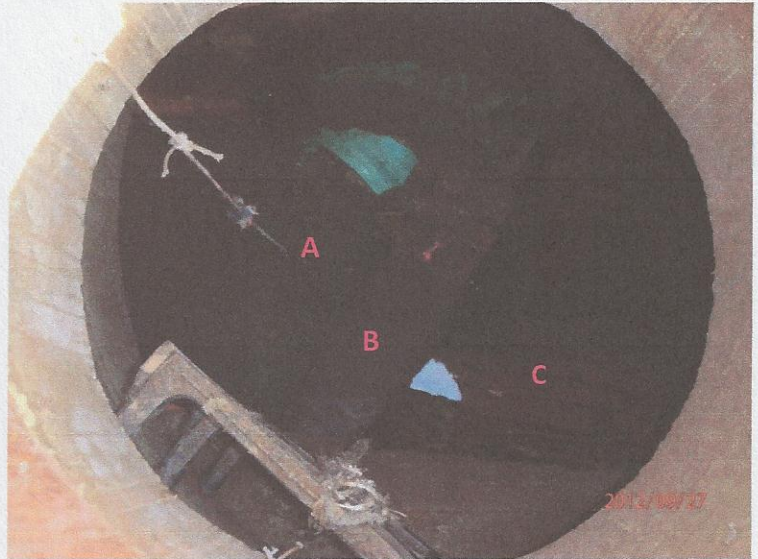


Figure 3.

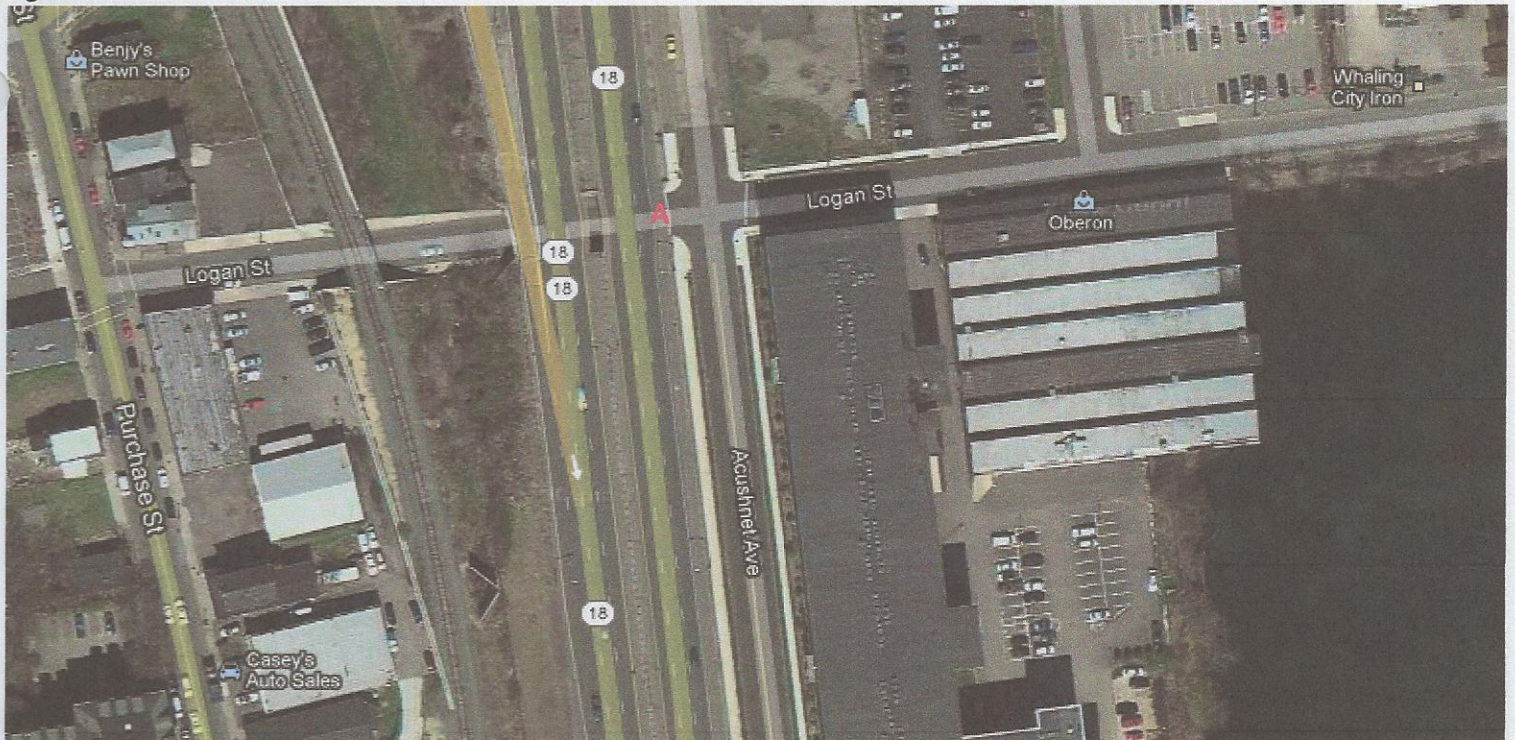

Descriptions

Figure 1: View of Regulator 020 B. Facing North.

Figure 2: Inside view of manhole. A- Sewer; B- Weir Wall; C- Storm Drain.

Figure 3: Google Earth Image of location of Regulator 020 B. A- Reg 020 B.

SEWER 36" BRICK

Regulator 020 B

ACUSHNET

830

844

840

14825 39

2321-96

STONE CONCRETE

POCKET

SEWER 18" PIPE

FORWARD INTERCEPTOR

HOWE

CSO/Regulator Repair Log

Structure #: Reg 020B

[illegible]