

New Bedford Regulator Specification Sheet

Regulator #: R-020B

Location: Acushnet Ave. at Logan St.

Date: 6/25/25

Structure Measurements

Structure Type: Single manhole

Rim Elevation (ft City Datum): 14.7

Regulator Type: Fixed Weir

Overflow Height (ft or in): 14.5

Rim to Top of Weir (ft): 6.9

Weir Dims (ft or in): Length: 46.5", Width: 6.5", Height: 14.5"

Influent pipe ø (in): 42

Rim to Influent Invert (ft): 8.1

Dry Weather Connection ø (in): 12" orifice to 18" sewer

Rim to Dry Weather Invert (ft): 8.1

Overflow pipe ø (in): 42

Rim to Overflow Invert (ft): 8.1

Sensor Measurements

Block Present: Yes

Level Sensor Status: Metered


Sensor Installation Date: 10/15/2020

Intra-System Status: No

Tide Gate Status: Gate at outfall

Notes: RedZone LIDAR scan recorded a 42 " diameter for the incoming combined sewer and overflow, consistent with the Flow Assessment Services Site Sketch; the record drawing and sewer plot describe it as a 36" pipe.

Location Sketch:

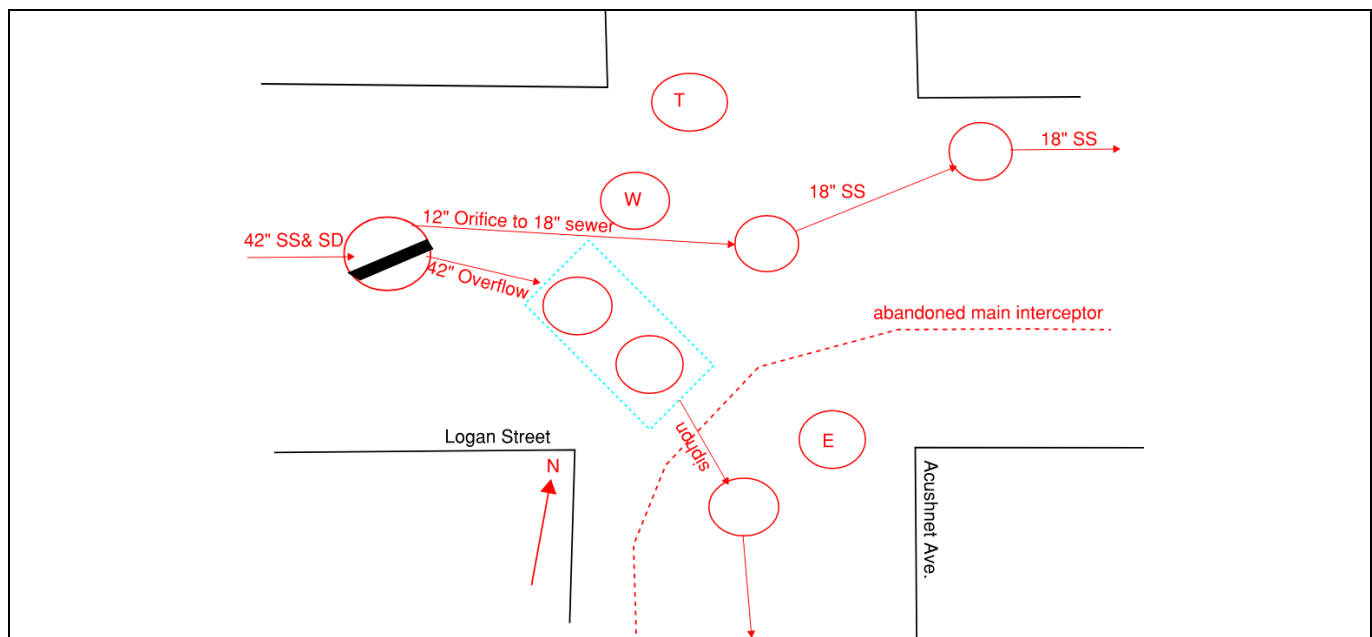




LOGAN STREET

12" ORIFICE
TO 18" SEWER

42" PIPE

5' DIA. MH
CHAMBER

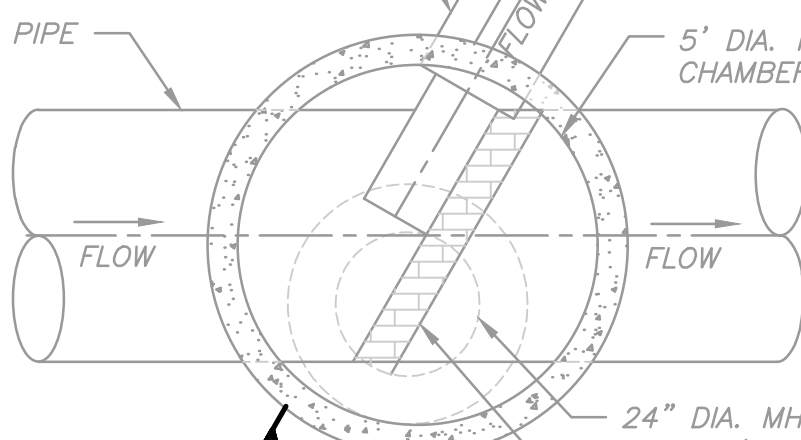

PLAN

$\frac{3}{8}" = 1' - 0"$




24" DIA. MH FRAME AND
COVER (ABOVE)

46.5"x6.5" BROAD CRESTED
BRICK WEIR WALL

NOTE:

ELEVATIONS SHOWN ARE IN
NEW BEDFORD CITY DATUM.

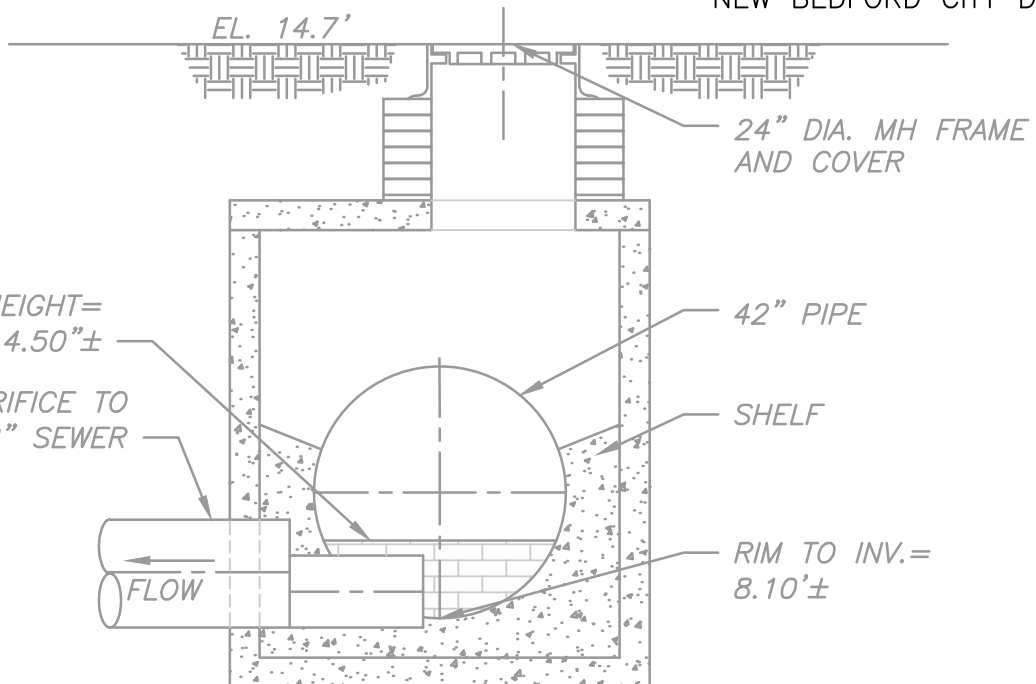

WEIR HEIGHT=
14.50"±

12" ORIFICE TO
18" SEWER


42" PIPE

SHELF





RIM TO INV.=
8.10'±


SECTION

$\frac{3}{8}" = 1' - 0"$

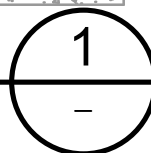

Relevant Notes from B-622 (pages 8, 9, and 16)

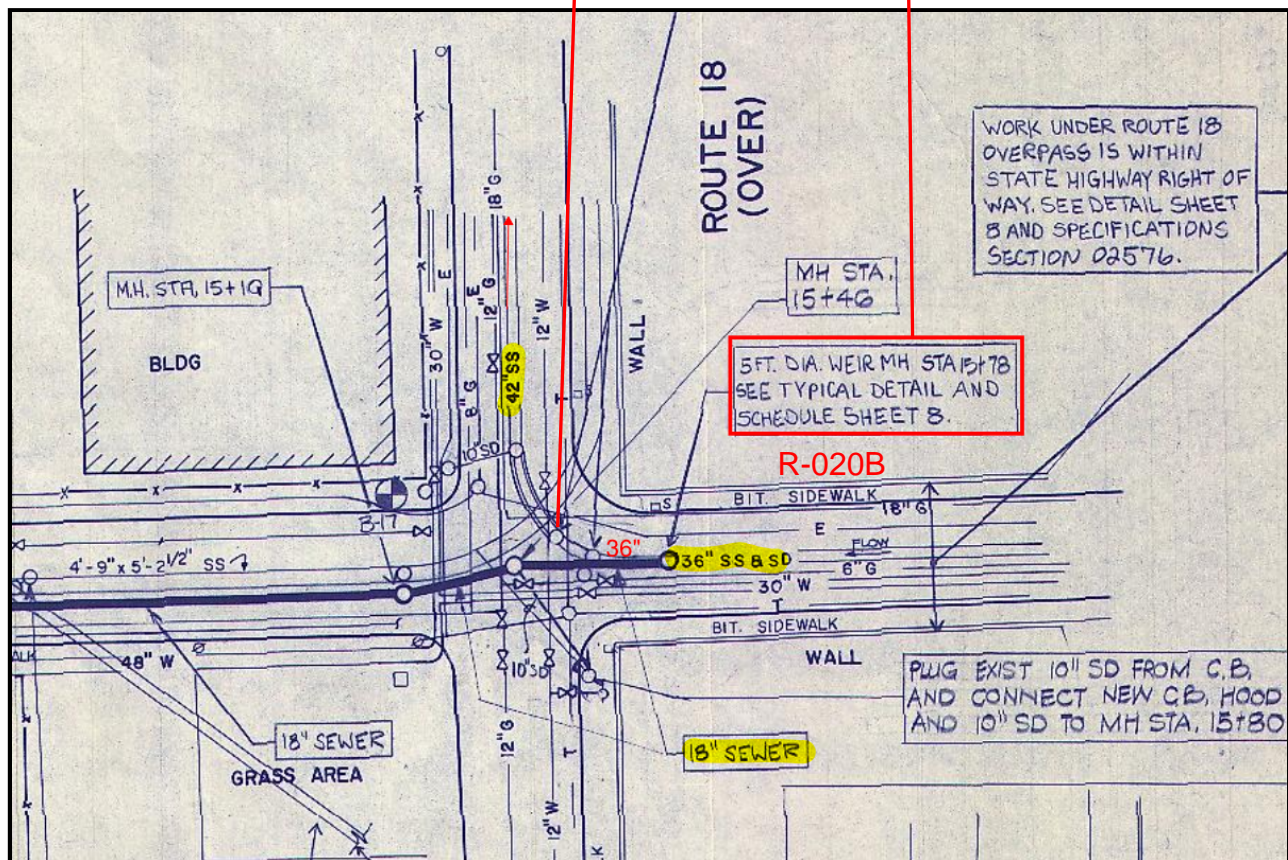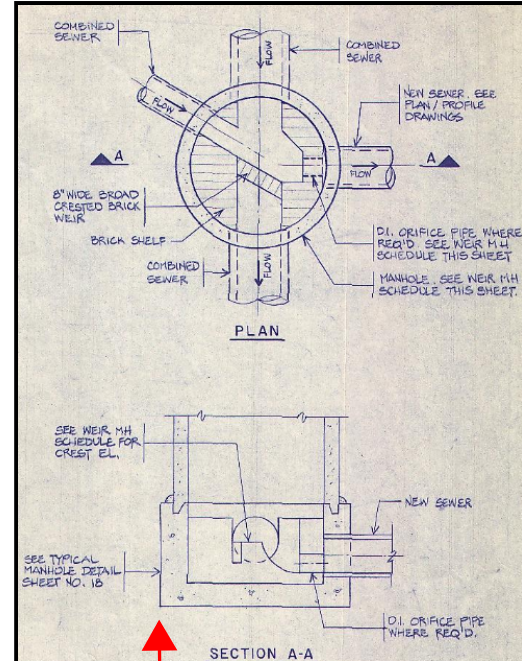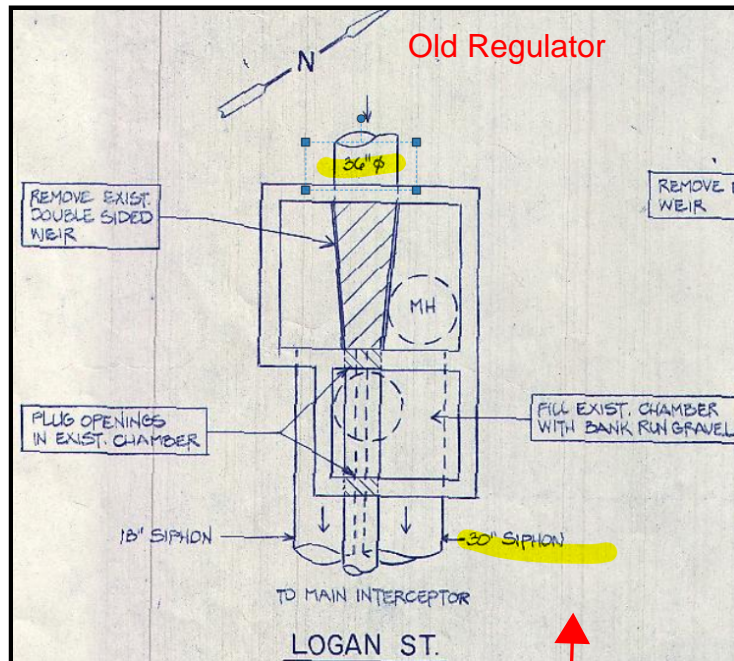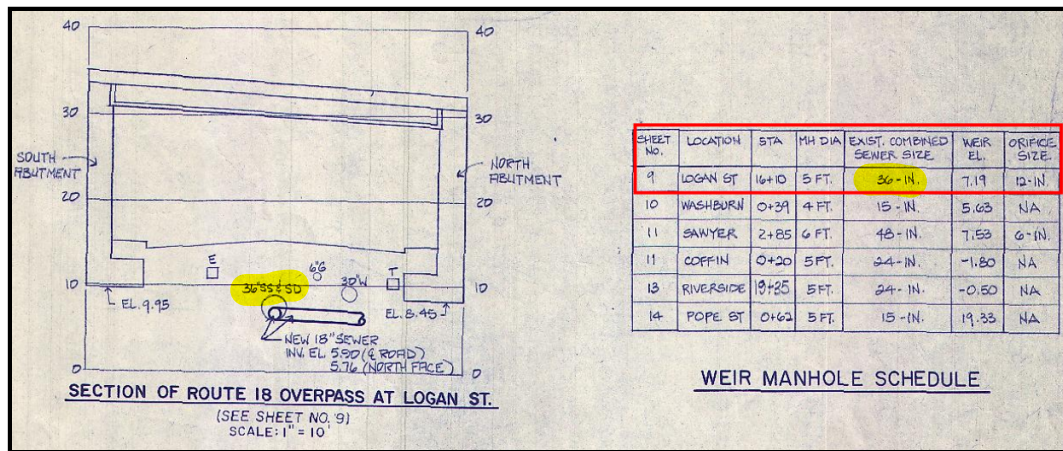

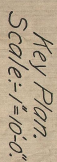


Sectional Elevation A-A.
Scale: $\frac{1}{2}'' = 1'-0''$

Dr. A-8207

217

ROUTE 5

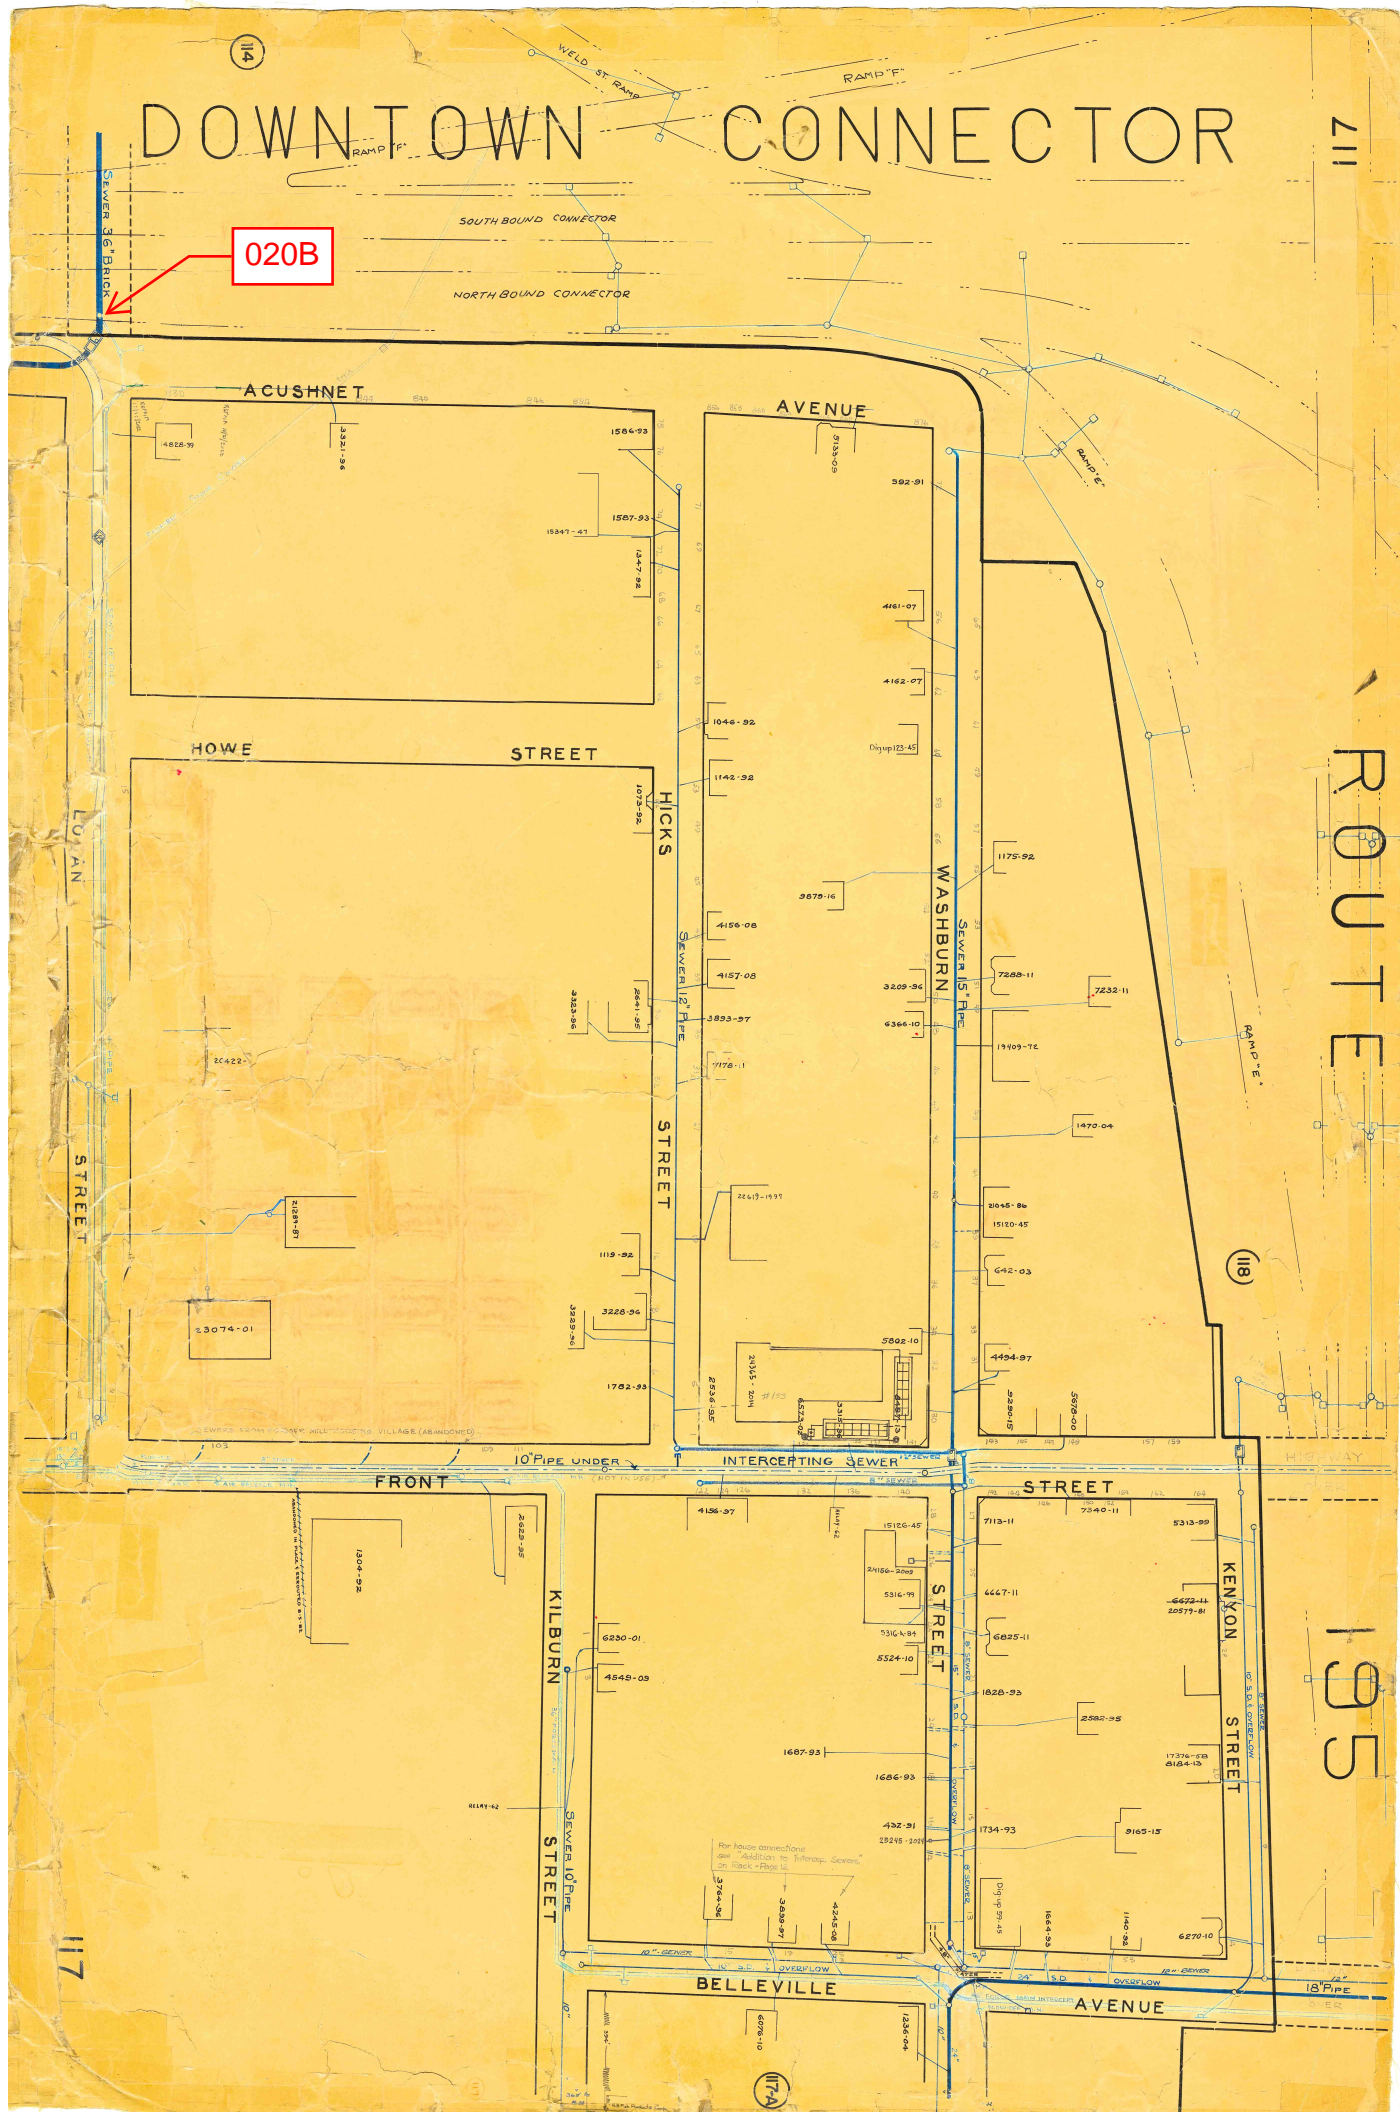

REGULATOR FIELD PHOTOS

Figure 1



Figure 2


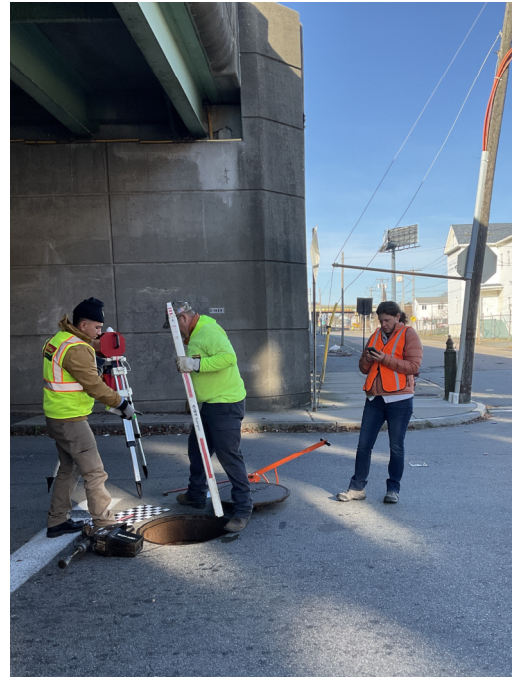


Figure 3

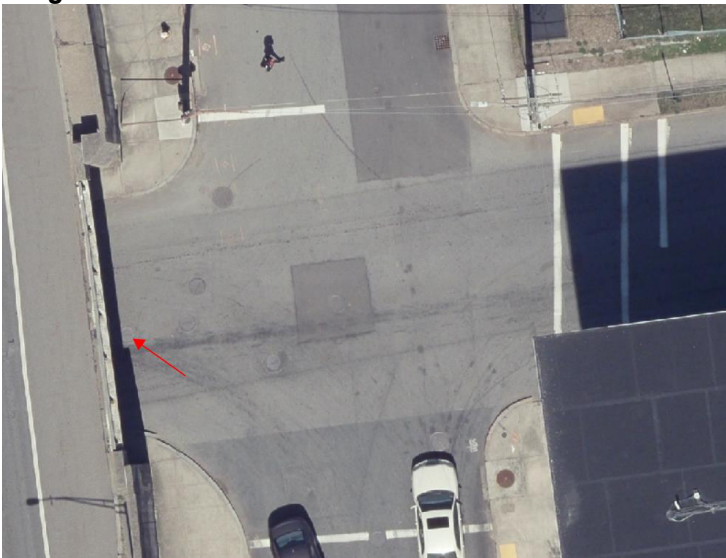

Descriptions:

Figure 1: Inside of R-020B. Inflow, outflow, weir, and overflow visible.

Figure 2: Location of manhole, facing north along Acushnet Ave.

Figure 3: Aerial location with arrow pointing to corresponding manhole.