

CSO SPEC SHEET

Structure #: REG 021 A

Date: 09/27/2012

Insp. By: AK & AH

Location: At the Intersection of Washburn St. and North Front St.

Structure Type: Weir Wall

Regulator Type: Block Regulator

Structure DIM's: _____

Weir Dim's: _____

Size of Sewer Pipe: 10.0"

Rim to Weir Wall: 9.9'

Size of Storm Drain Pipe: 10.0"

Rim to Storm Drain Invert: _____

Sewer Direction: South and West to North

Rim to Top of Sewer (Normal Flow): 10.7'

Free Board: 0.8'

Over All Rating: (Circle One)

Poor


Fair

Good

Excellent

Comments: No repairs needed.

Field Sketch:

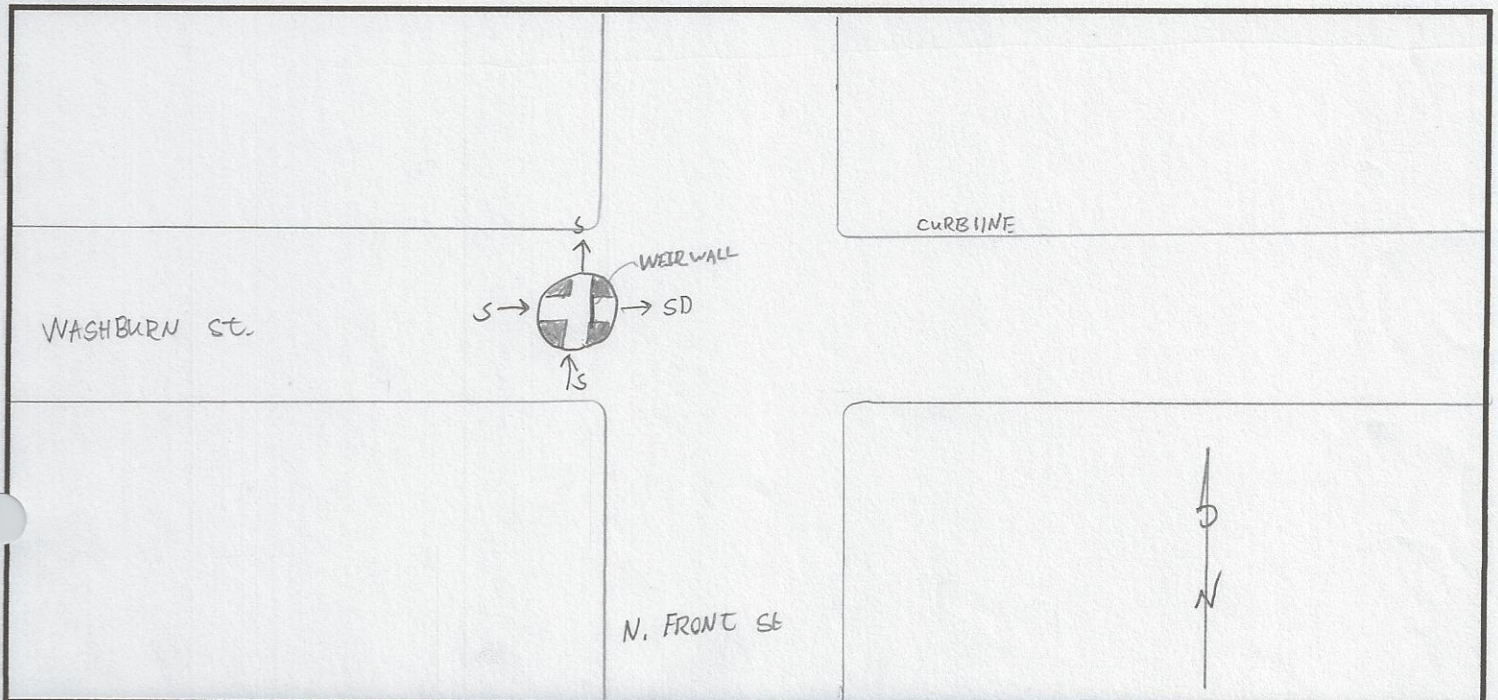

CSO FIELD PHOTOS

Structure#: REG 021 A

Location: At the Intersection of Washburn St. and North Front St.

Figure 1.



Figure 2.


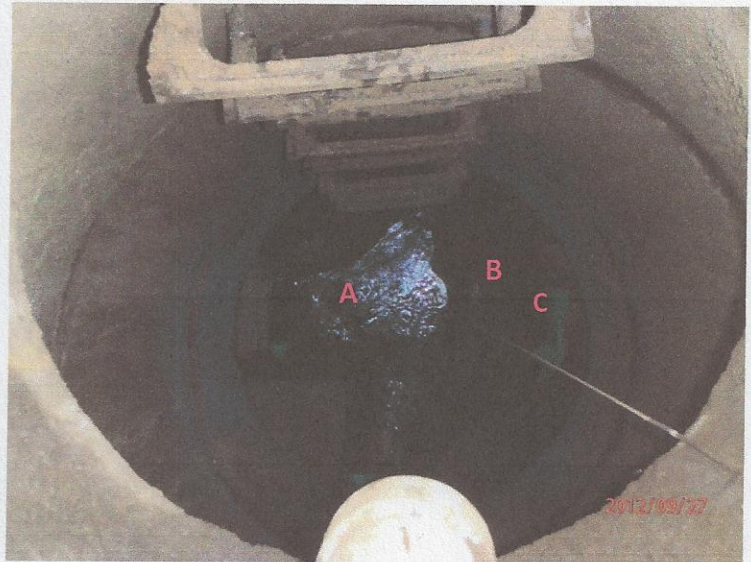


Figure 3.

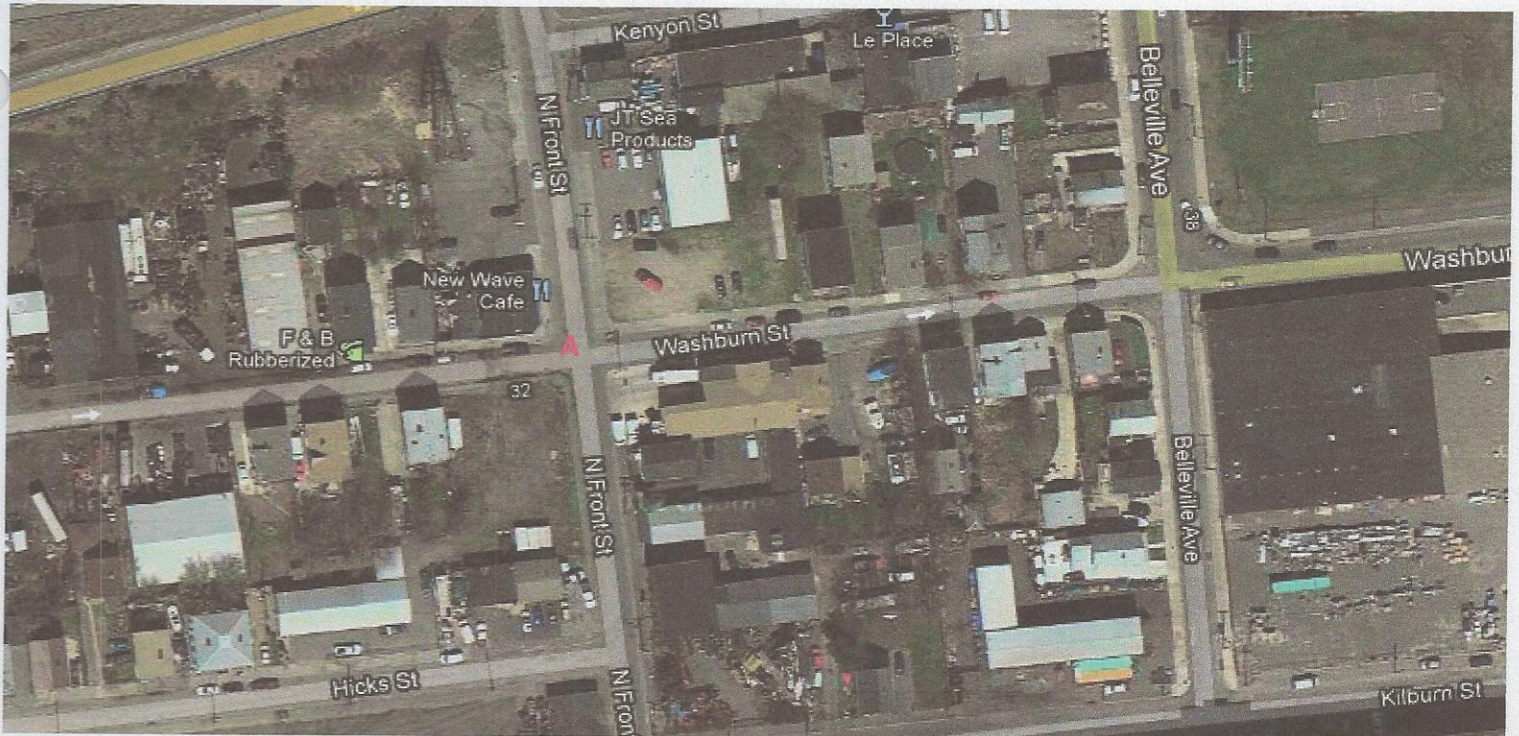


Descriptions

Figure 1: View of Regulator 021 A. Facing North.

Figure 2: Inside view of manhole. A- Sewer; B- Weir Wall; C- Storm Drain.

Figure 3: Google Earth Image of location of Regulator 021 A. A- Reg 021 A.

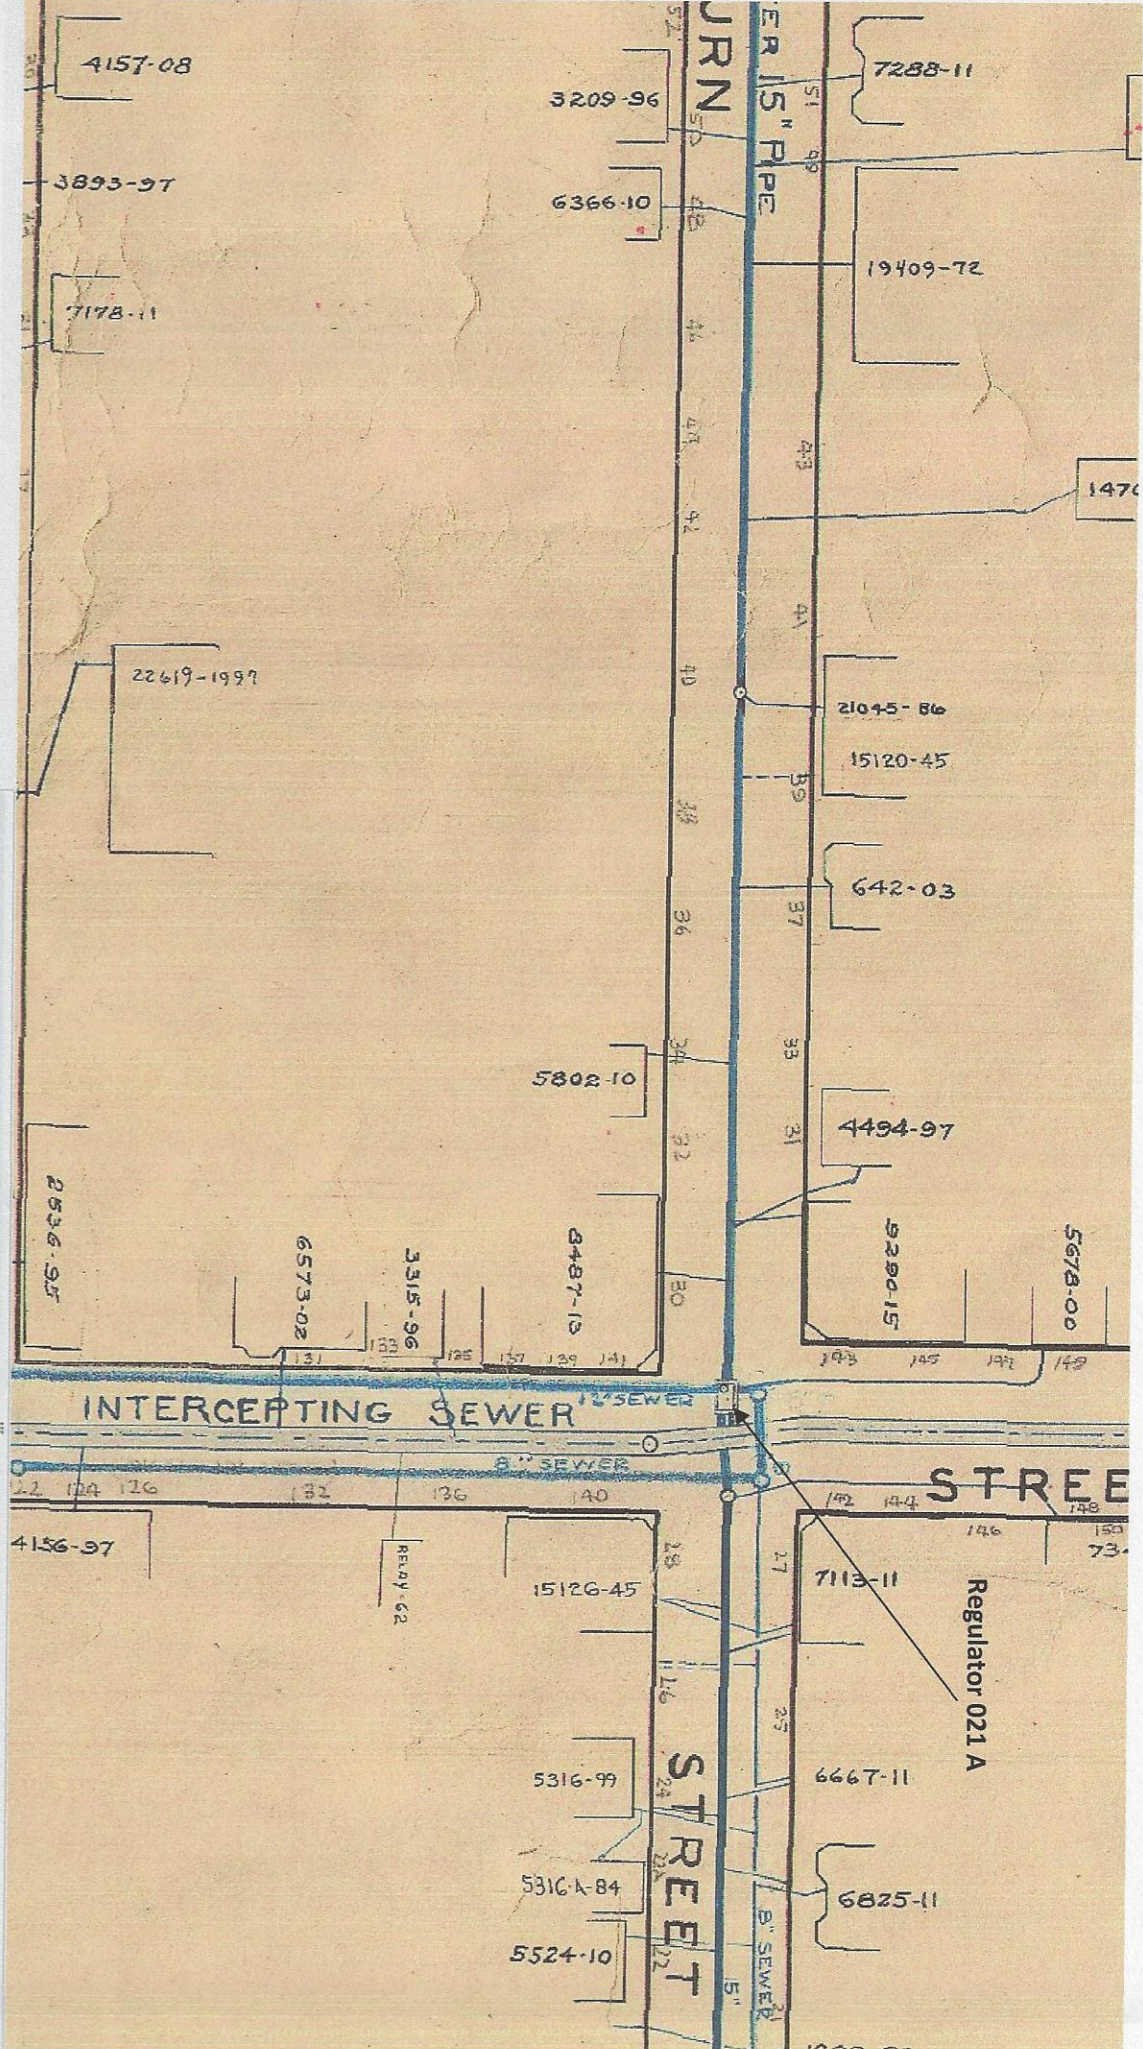

CSO/Regulator Repair Log

Structure #: Reg 021A

[illegible]