

CSO SPEC SHEET

Structure #: REG 022 A

Date: 09/19/2012

Insp. By: AK & AH

Location: At the Intersection of Sawyer St. and North Front St.

Structure Type: Brick Weir Wall

Regulator Type: Block Regulator

Structure DIM's: _____

Weir Dim's: _____

Size of Sewer Pipe: 48"

Rim to Weir Wall: 13.8'

Size of Storm Drain Pipe: 48"

Rim to Storm Drain Invert: _____

Sewer Direction: West to South

Rim to Top of Sewer (Normal Flow): 15.0'

Free Board: 1.2'

Over All Rating: (Circle One)

Poor


Fair

Good

Excellent

Comments: No Repairs Needed.

Field Sketch:

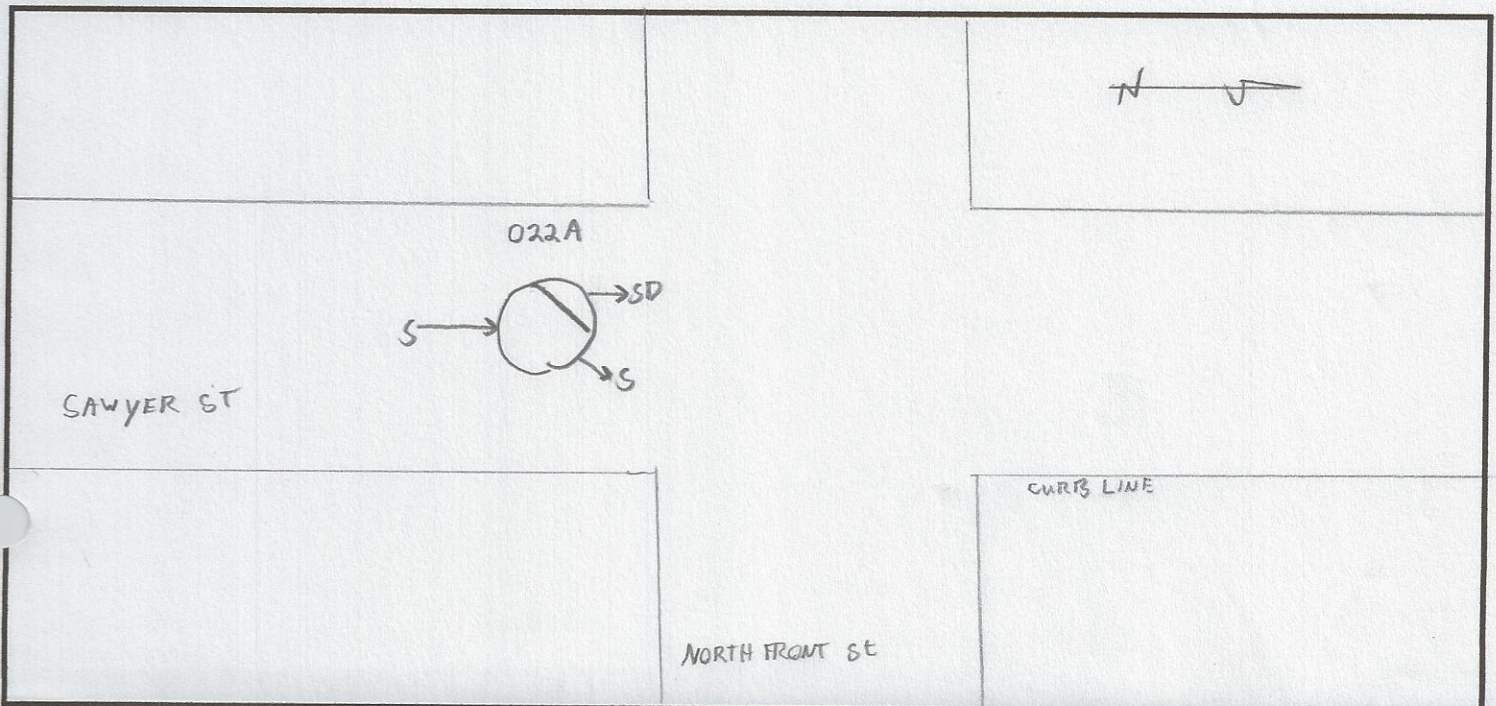

CSO FIELD PHOTOS

Structure#: REG 022 A

Location: At the Intersection of Sawyer St. and North Front St.

Figure 1.



Figure 2.



Figure 3.




Descriptions

Figure 1: View of Regulator 022 A. Facing North.

Figure 2: Inside view of manhole. A- Sewer; B- Weir Wall; C- Storm Drain.

Figure 3: Google Earth Image of location of Regulator 022 A. A- Reg 022 A.

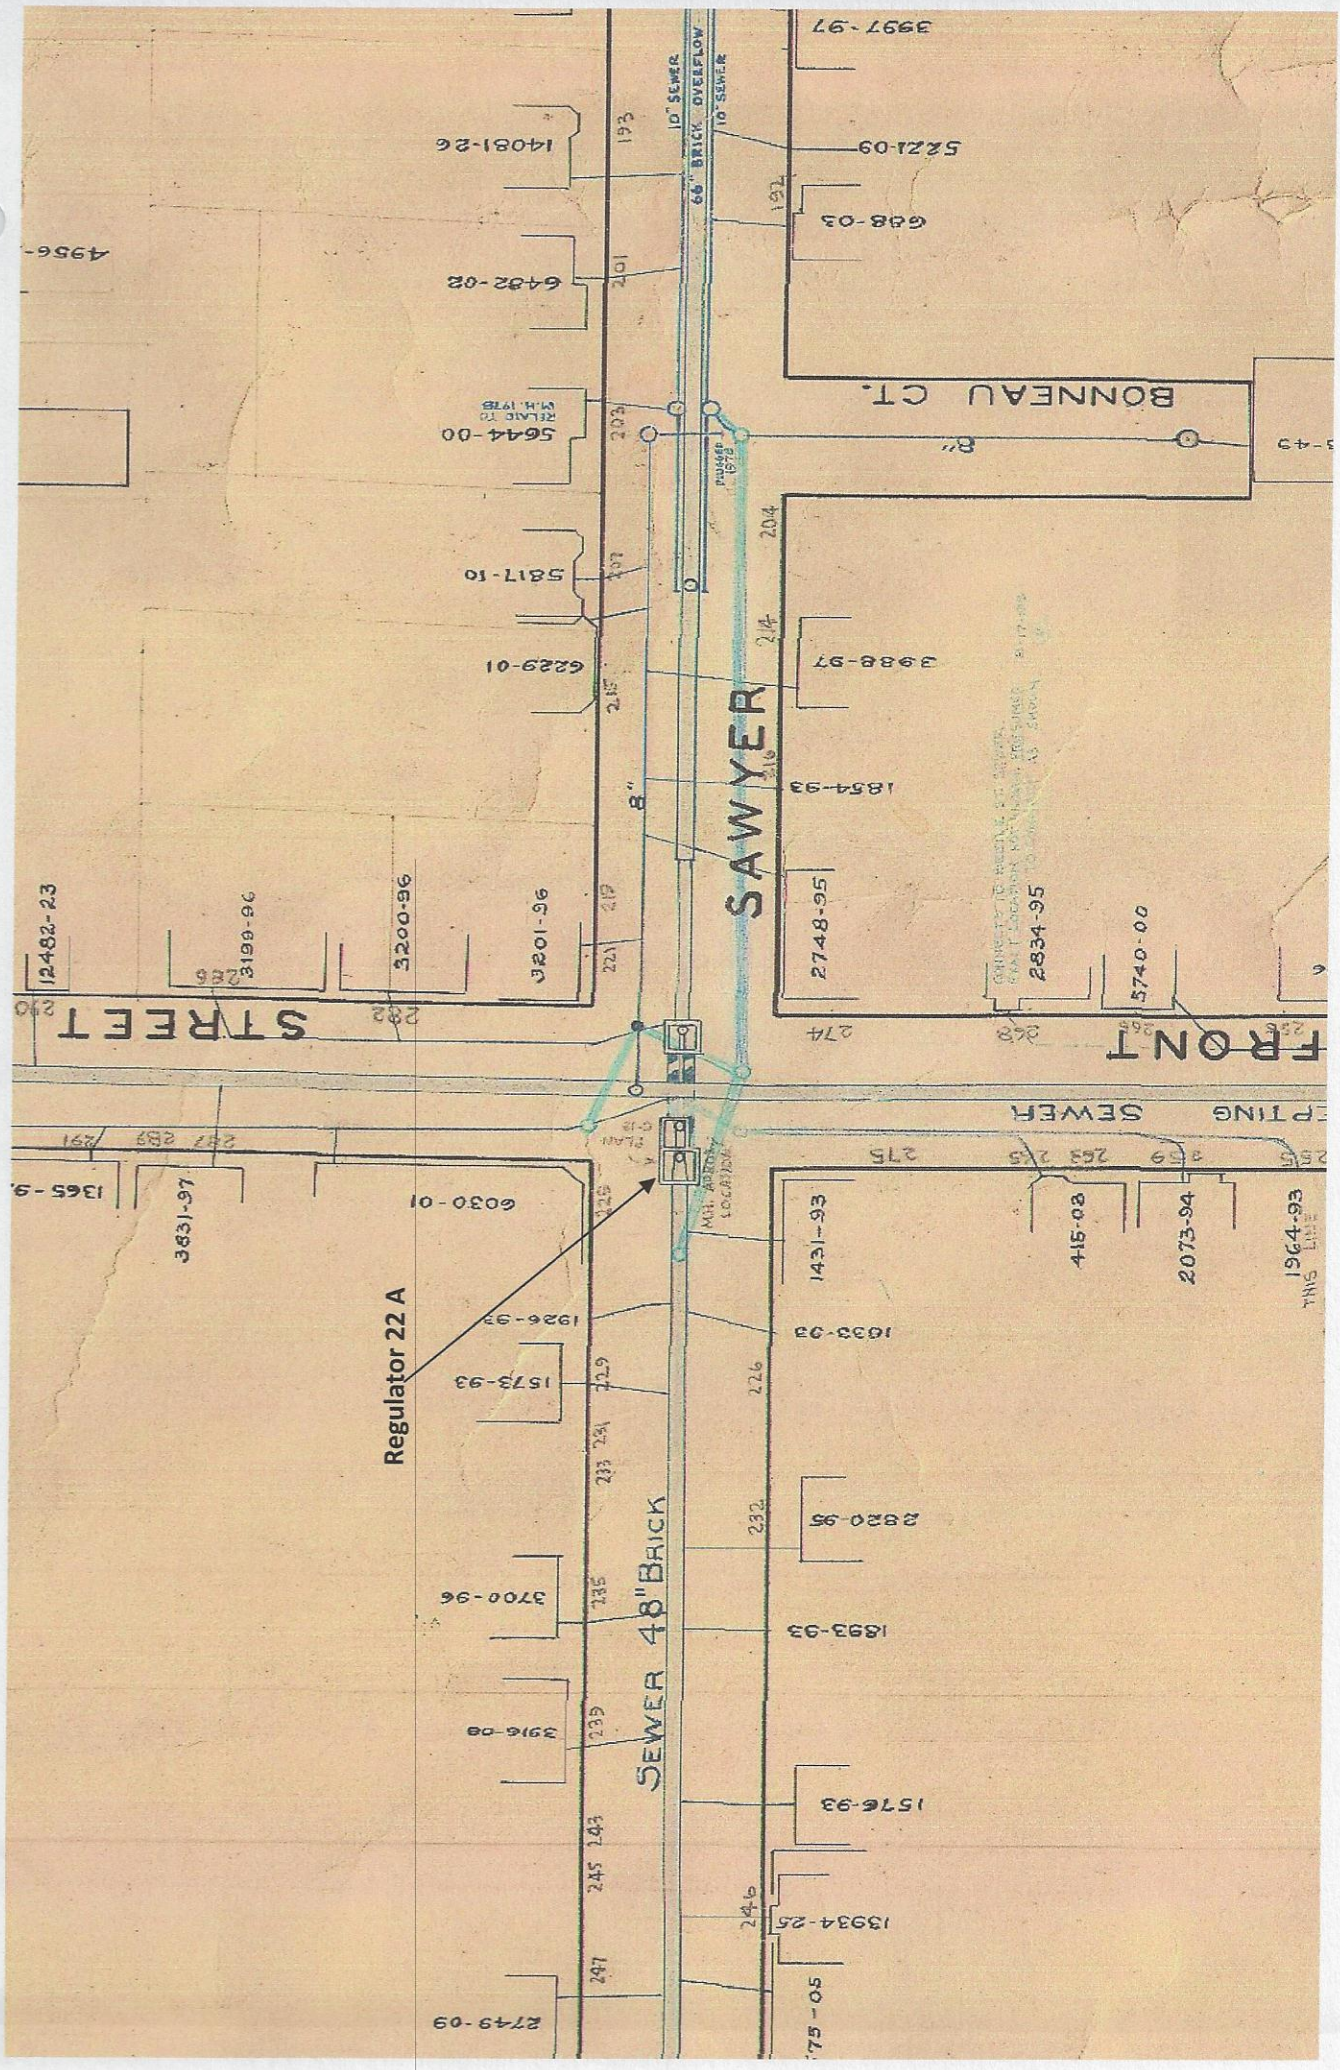

CSO/Regulator Repair Log

Structure #: Reg 022A

[illegible]